


BLACKLICK CREEK

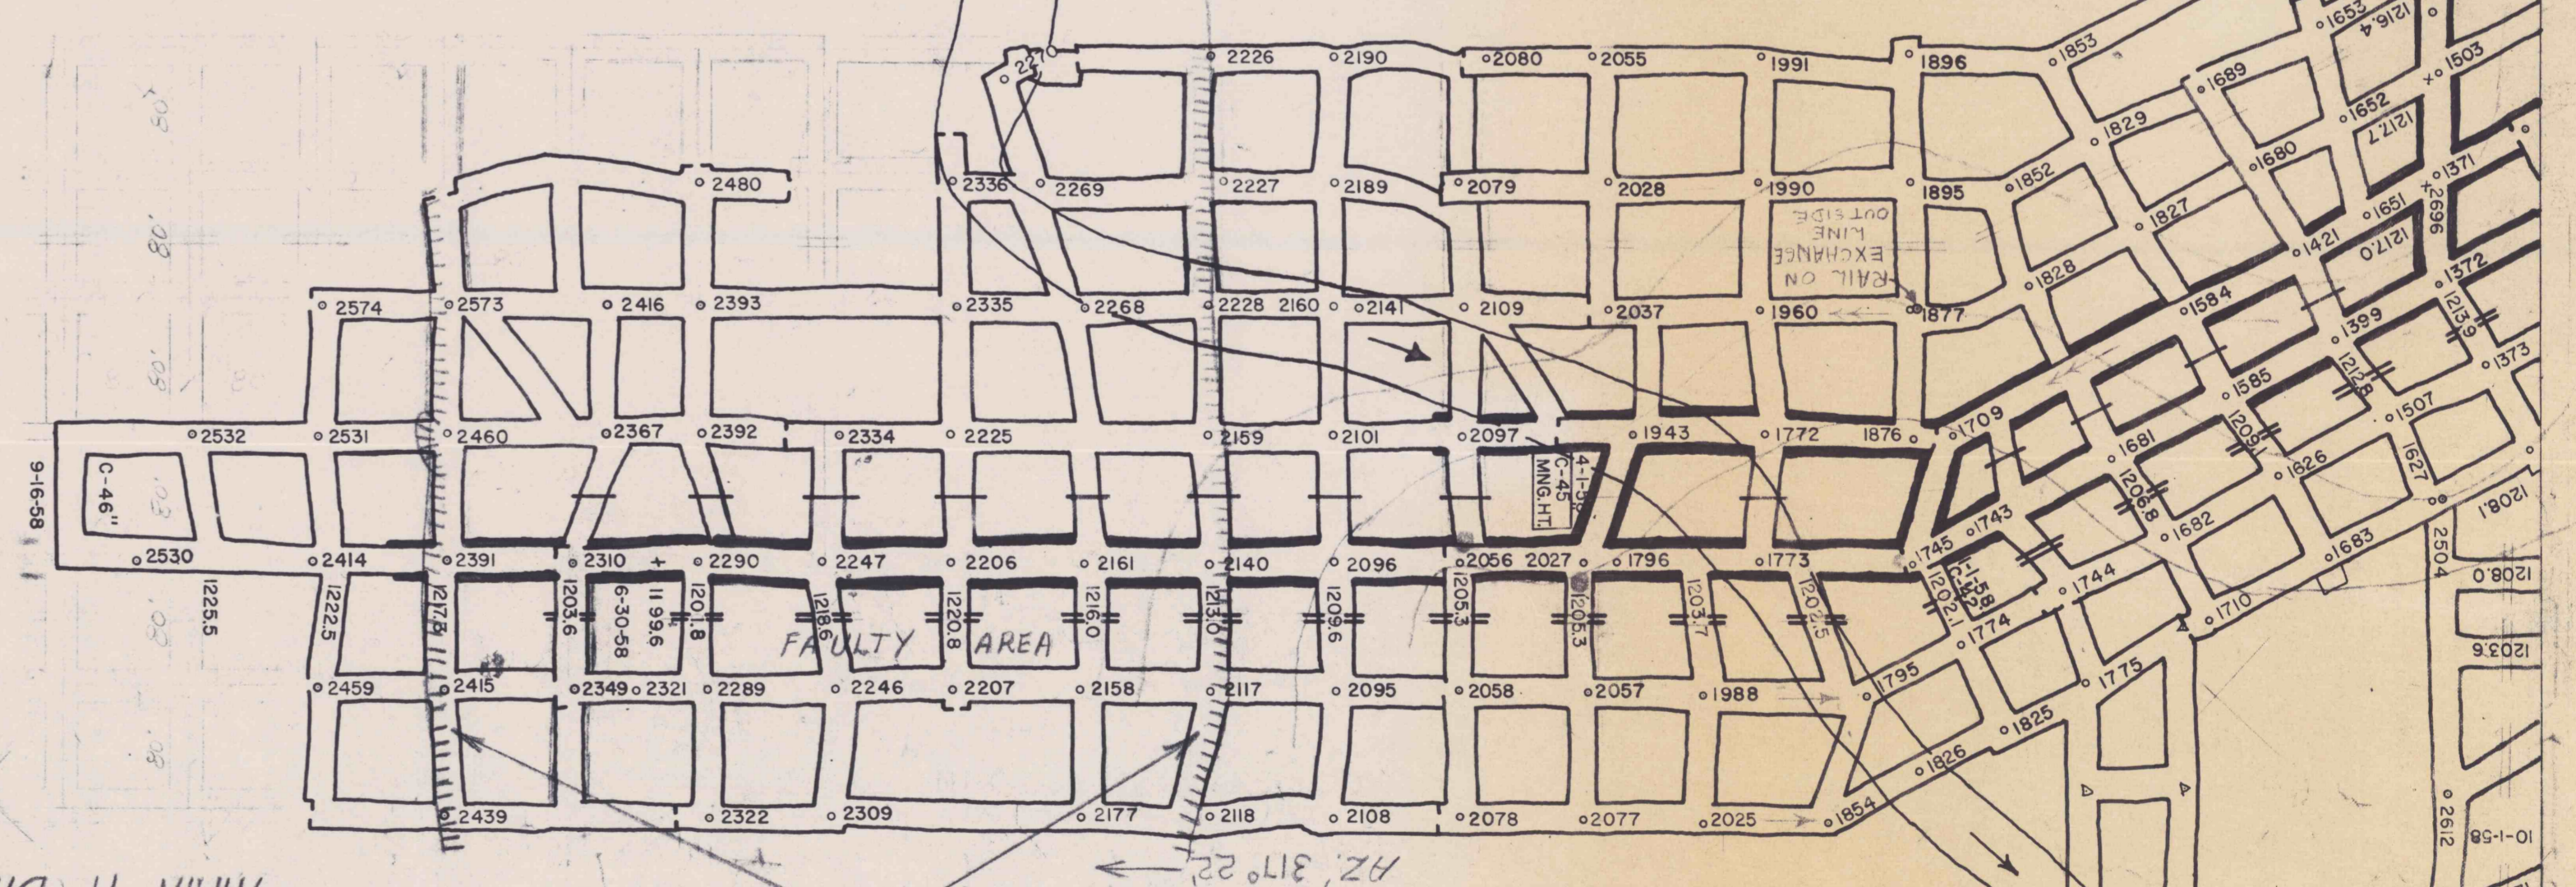

MAIN "A" DIP

SANDROCK UNCLE TOMS IN COAL SEAM