



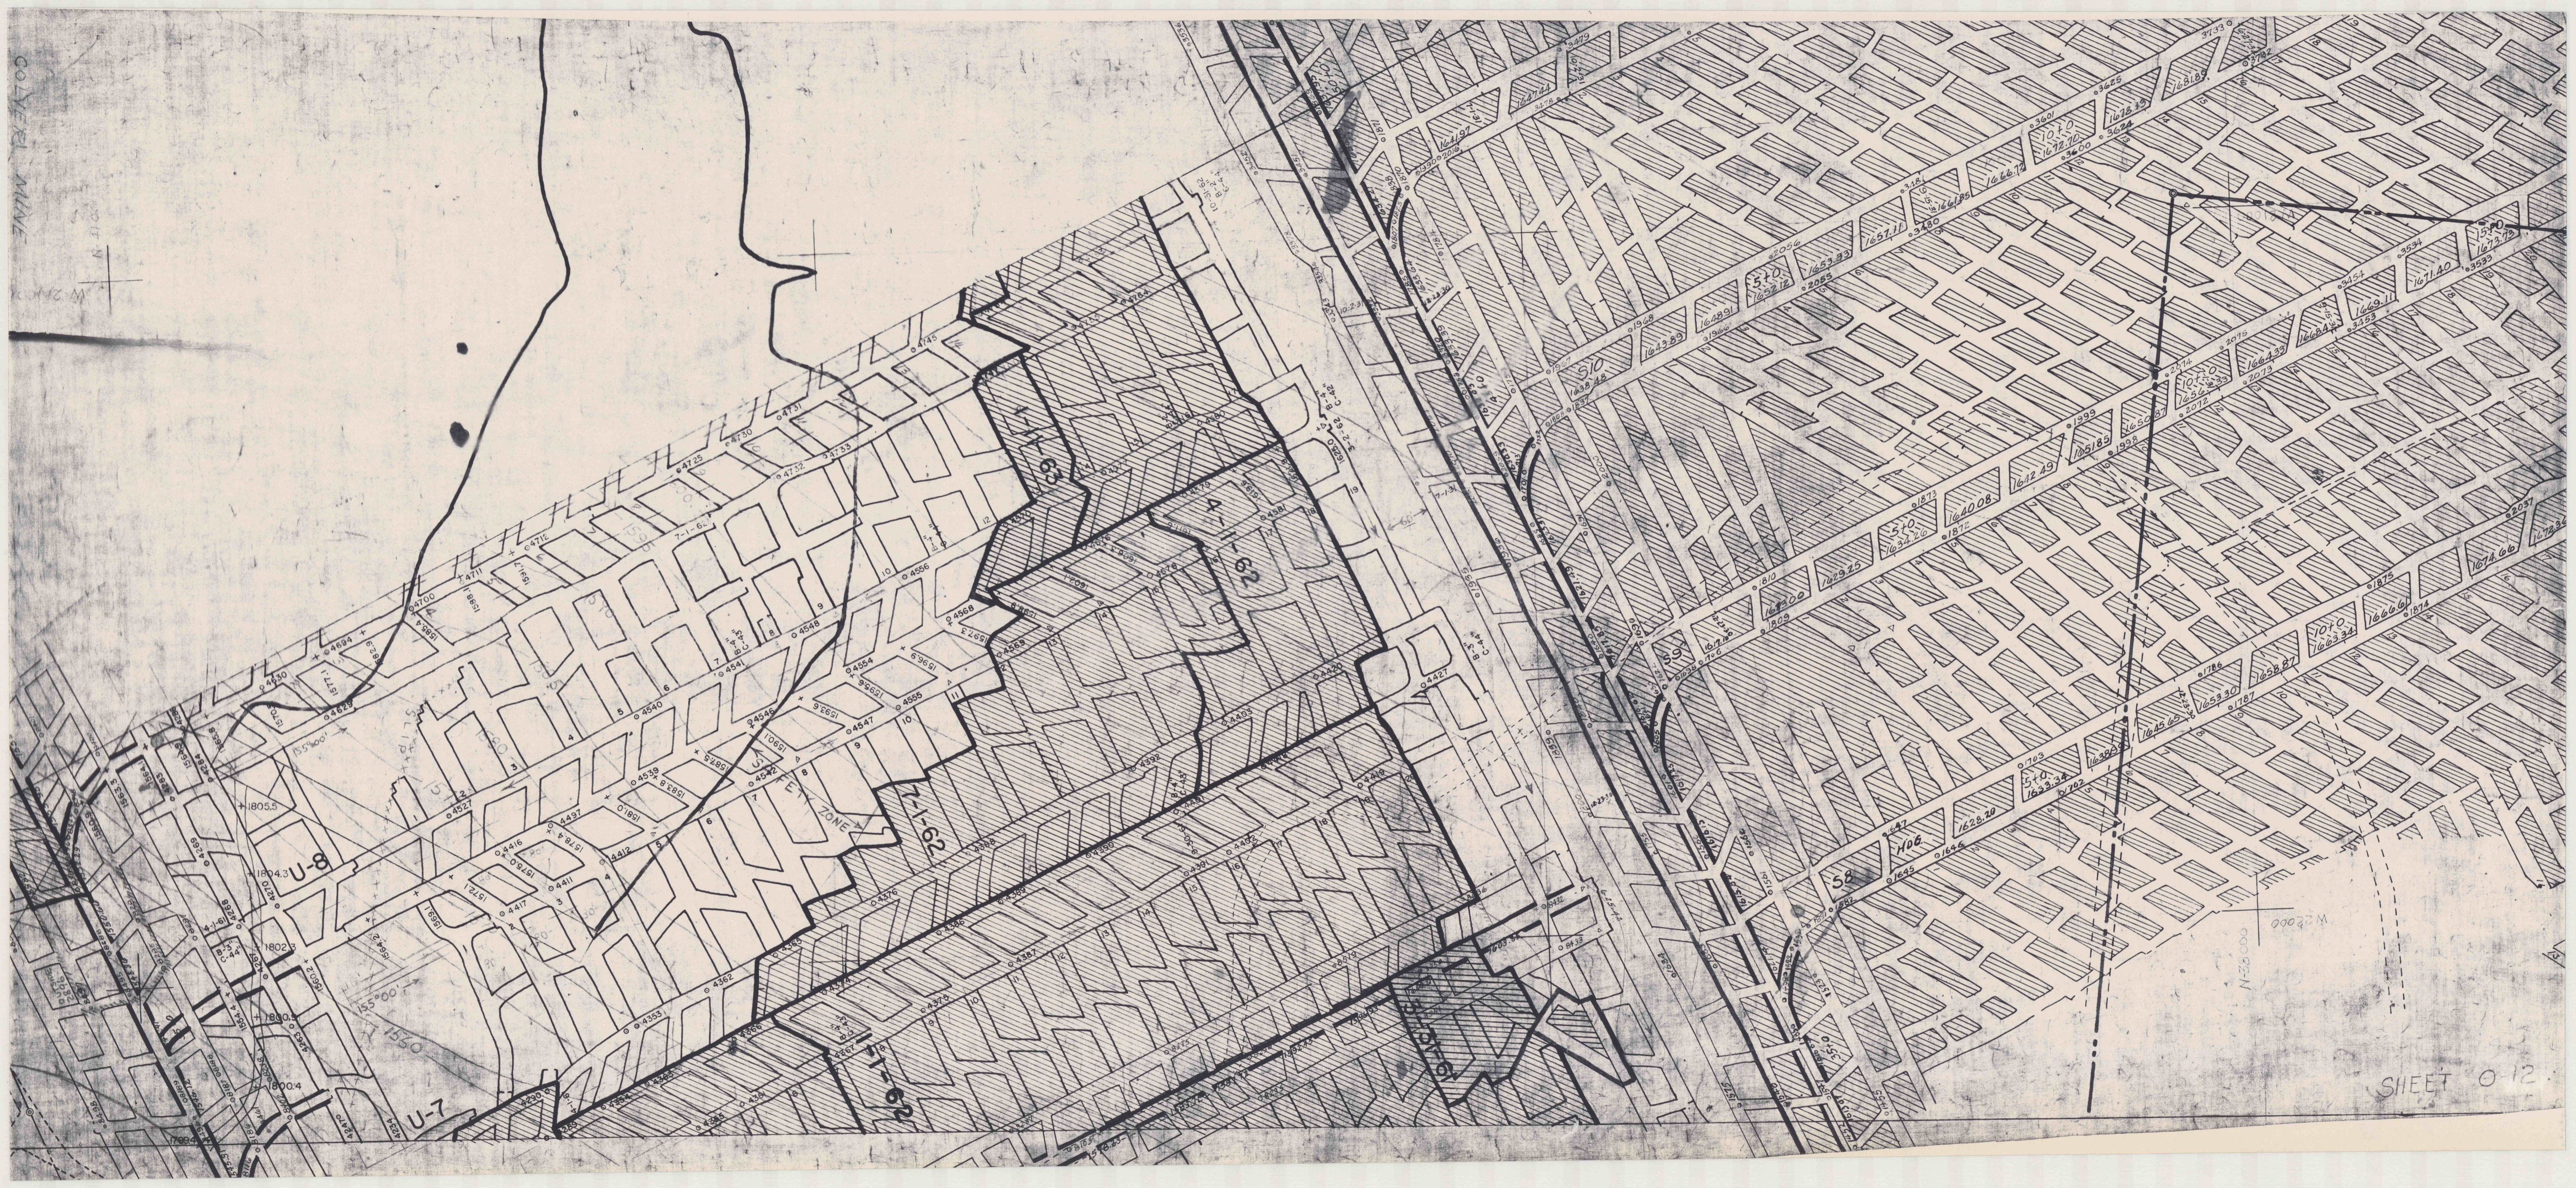

U-7

B-N










SHEET 0-12