


COLVER MINE
SHEET 0-14

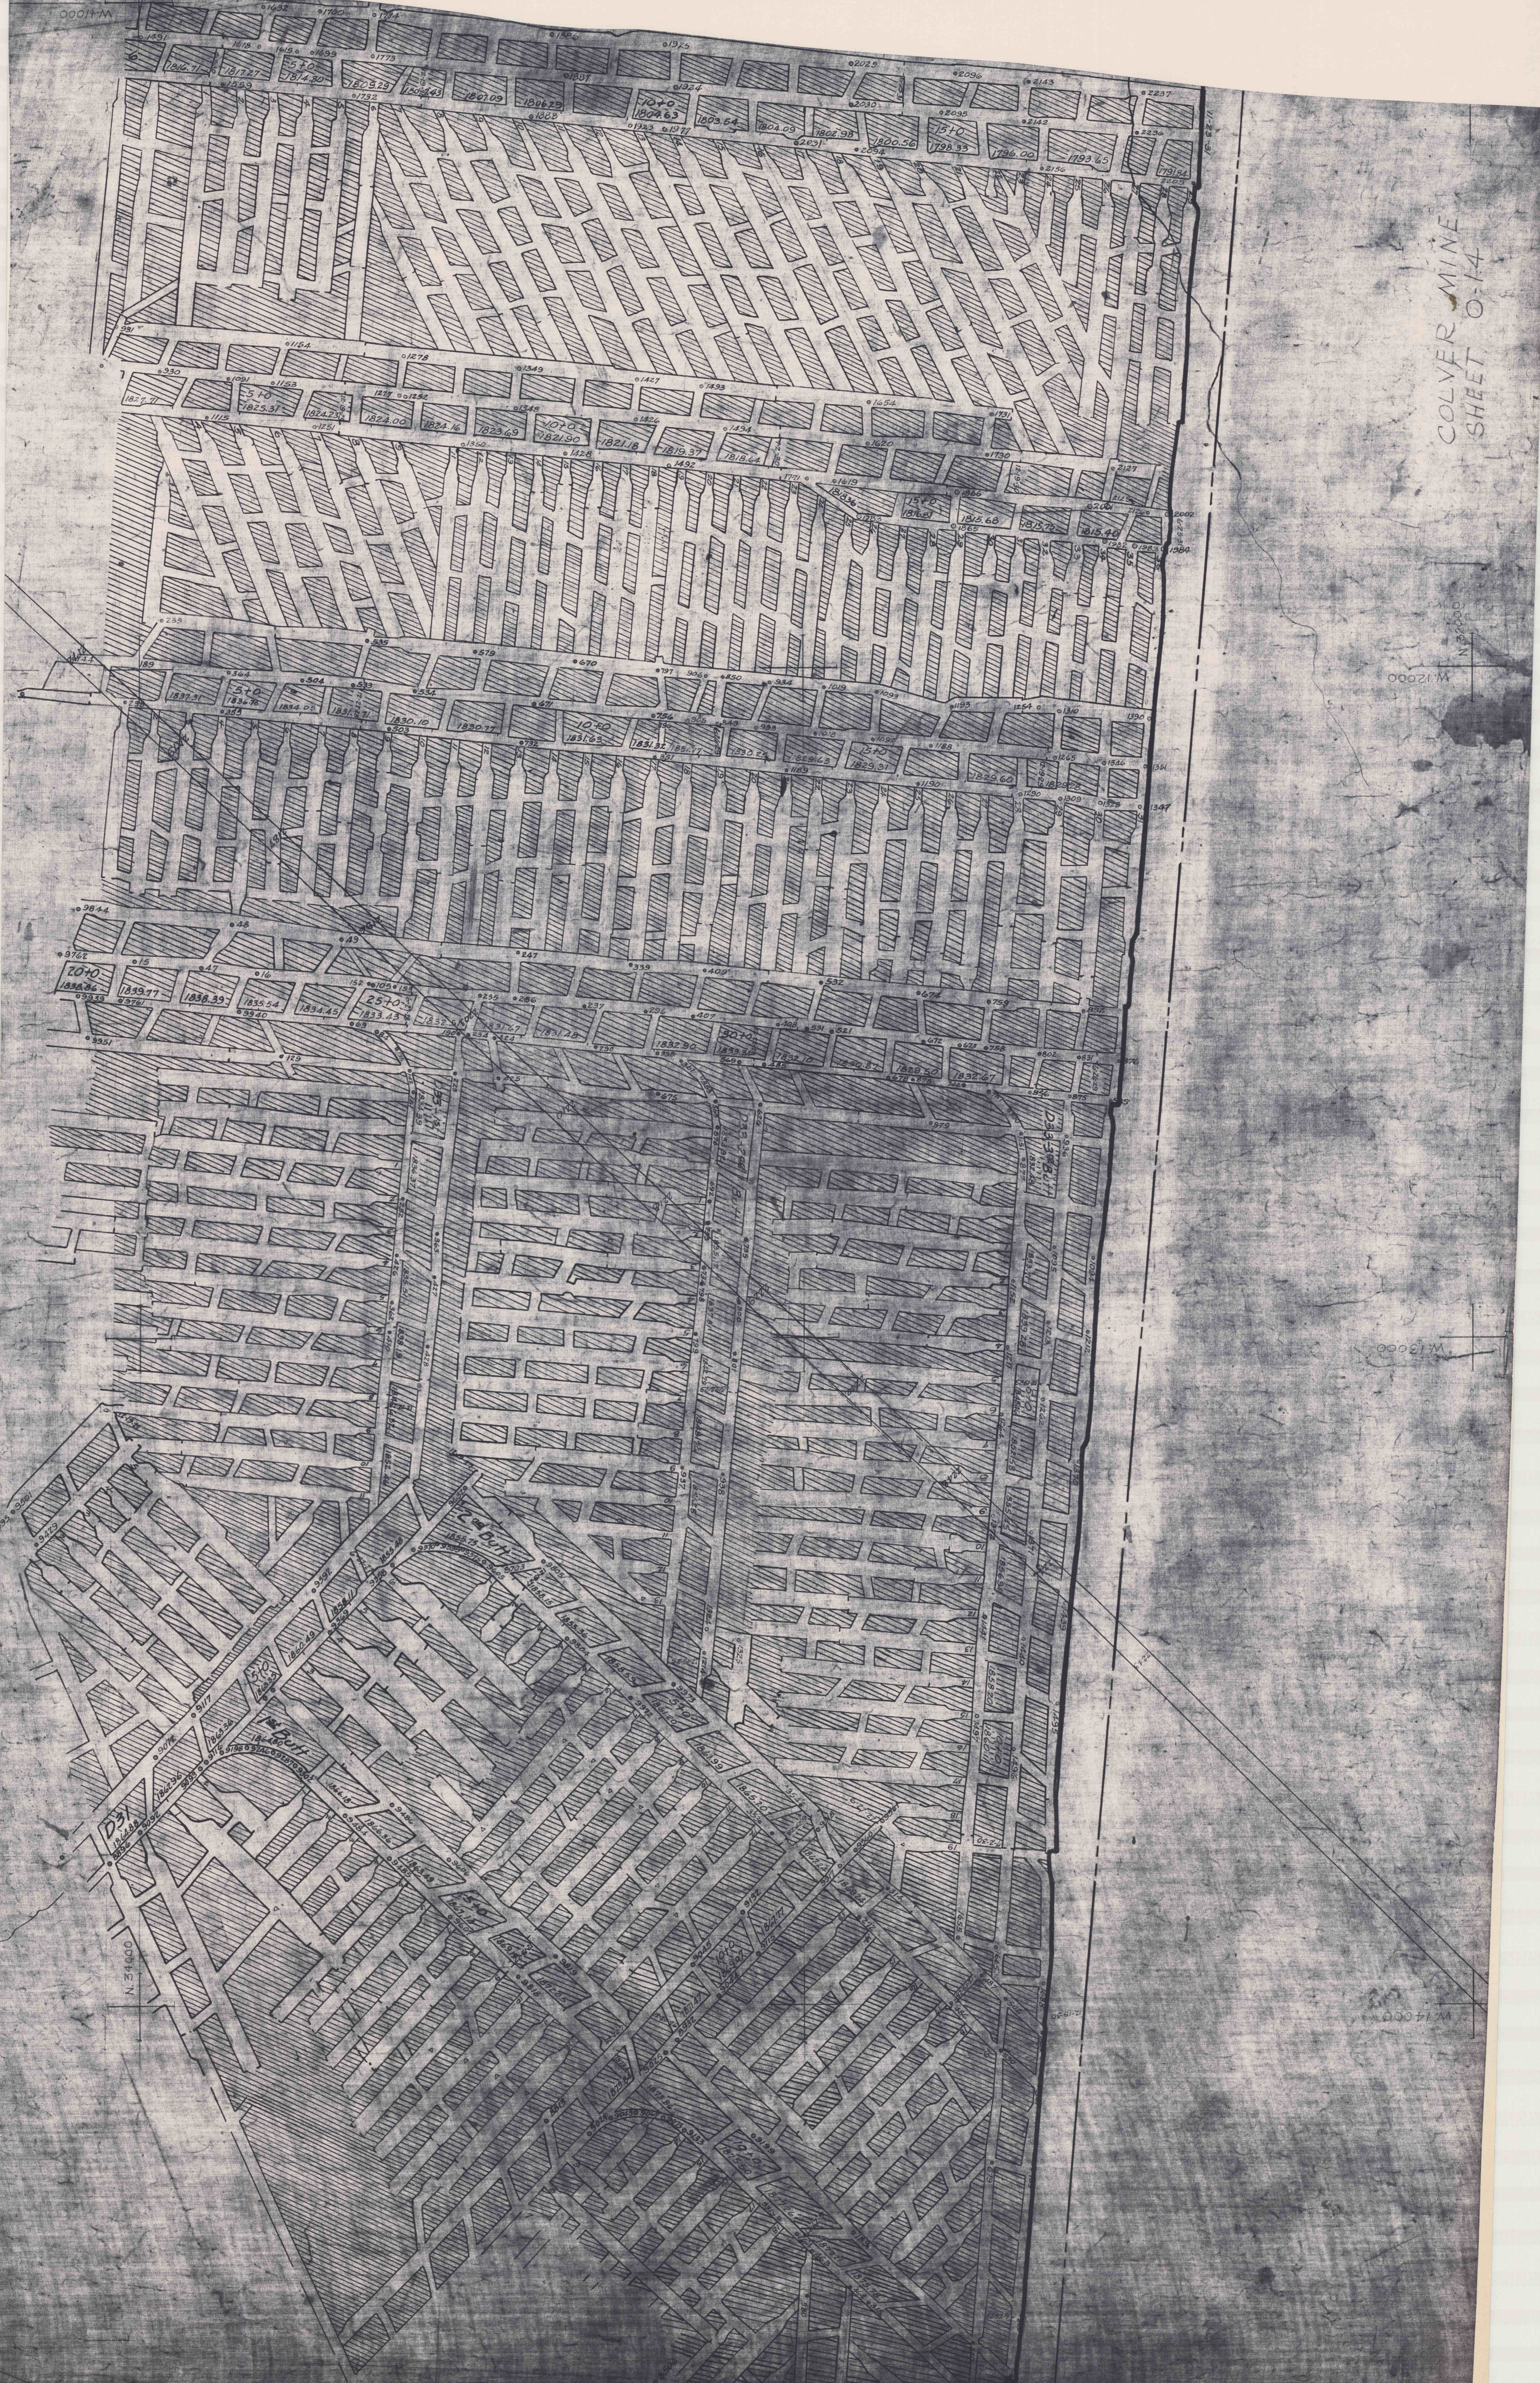

00021 M

00021 M

00021 M