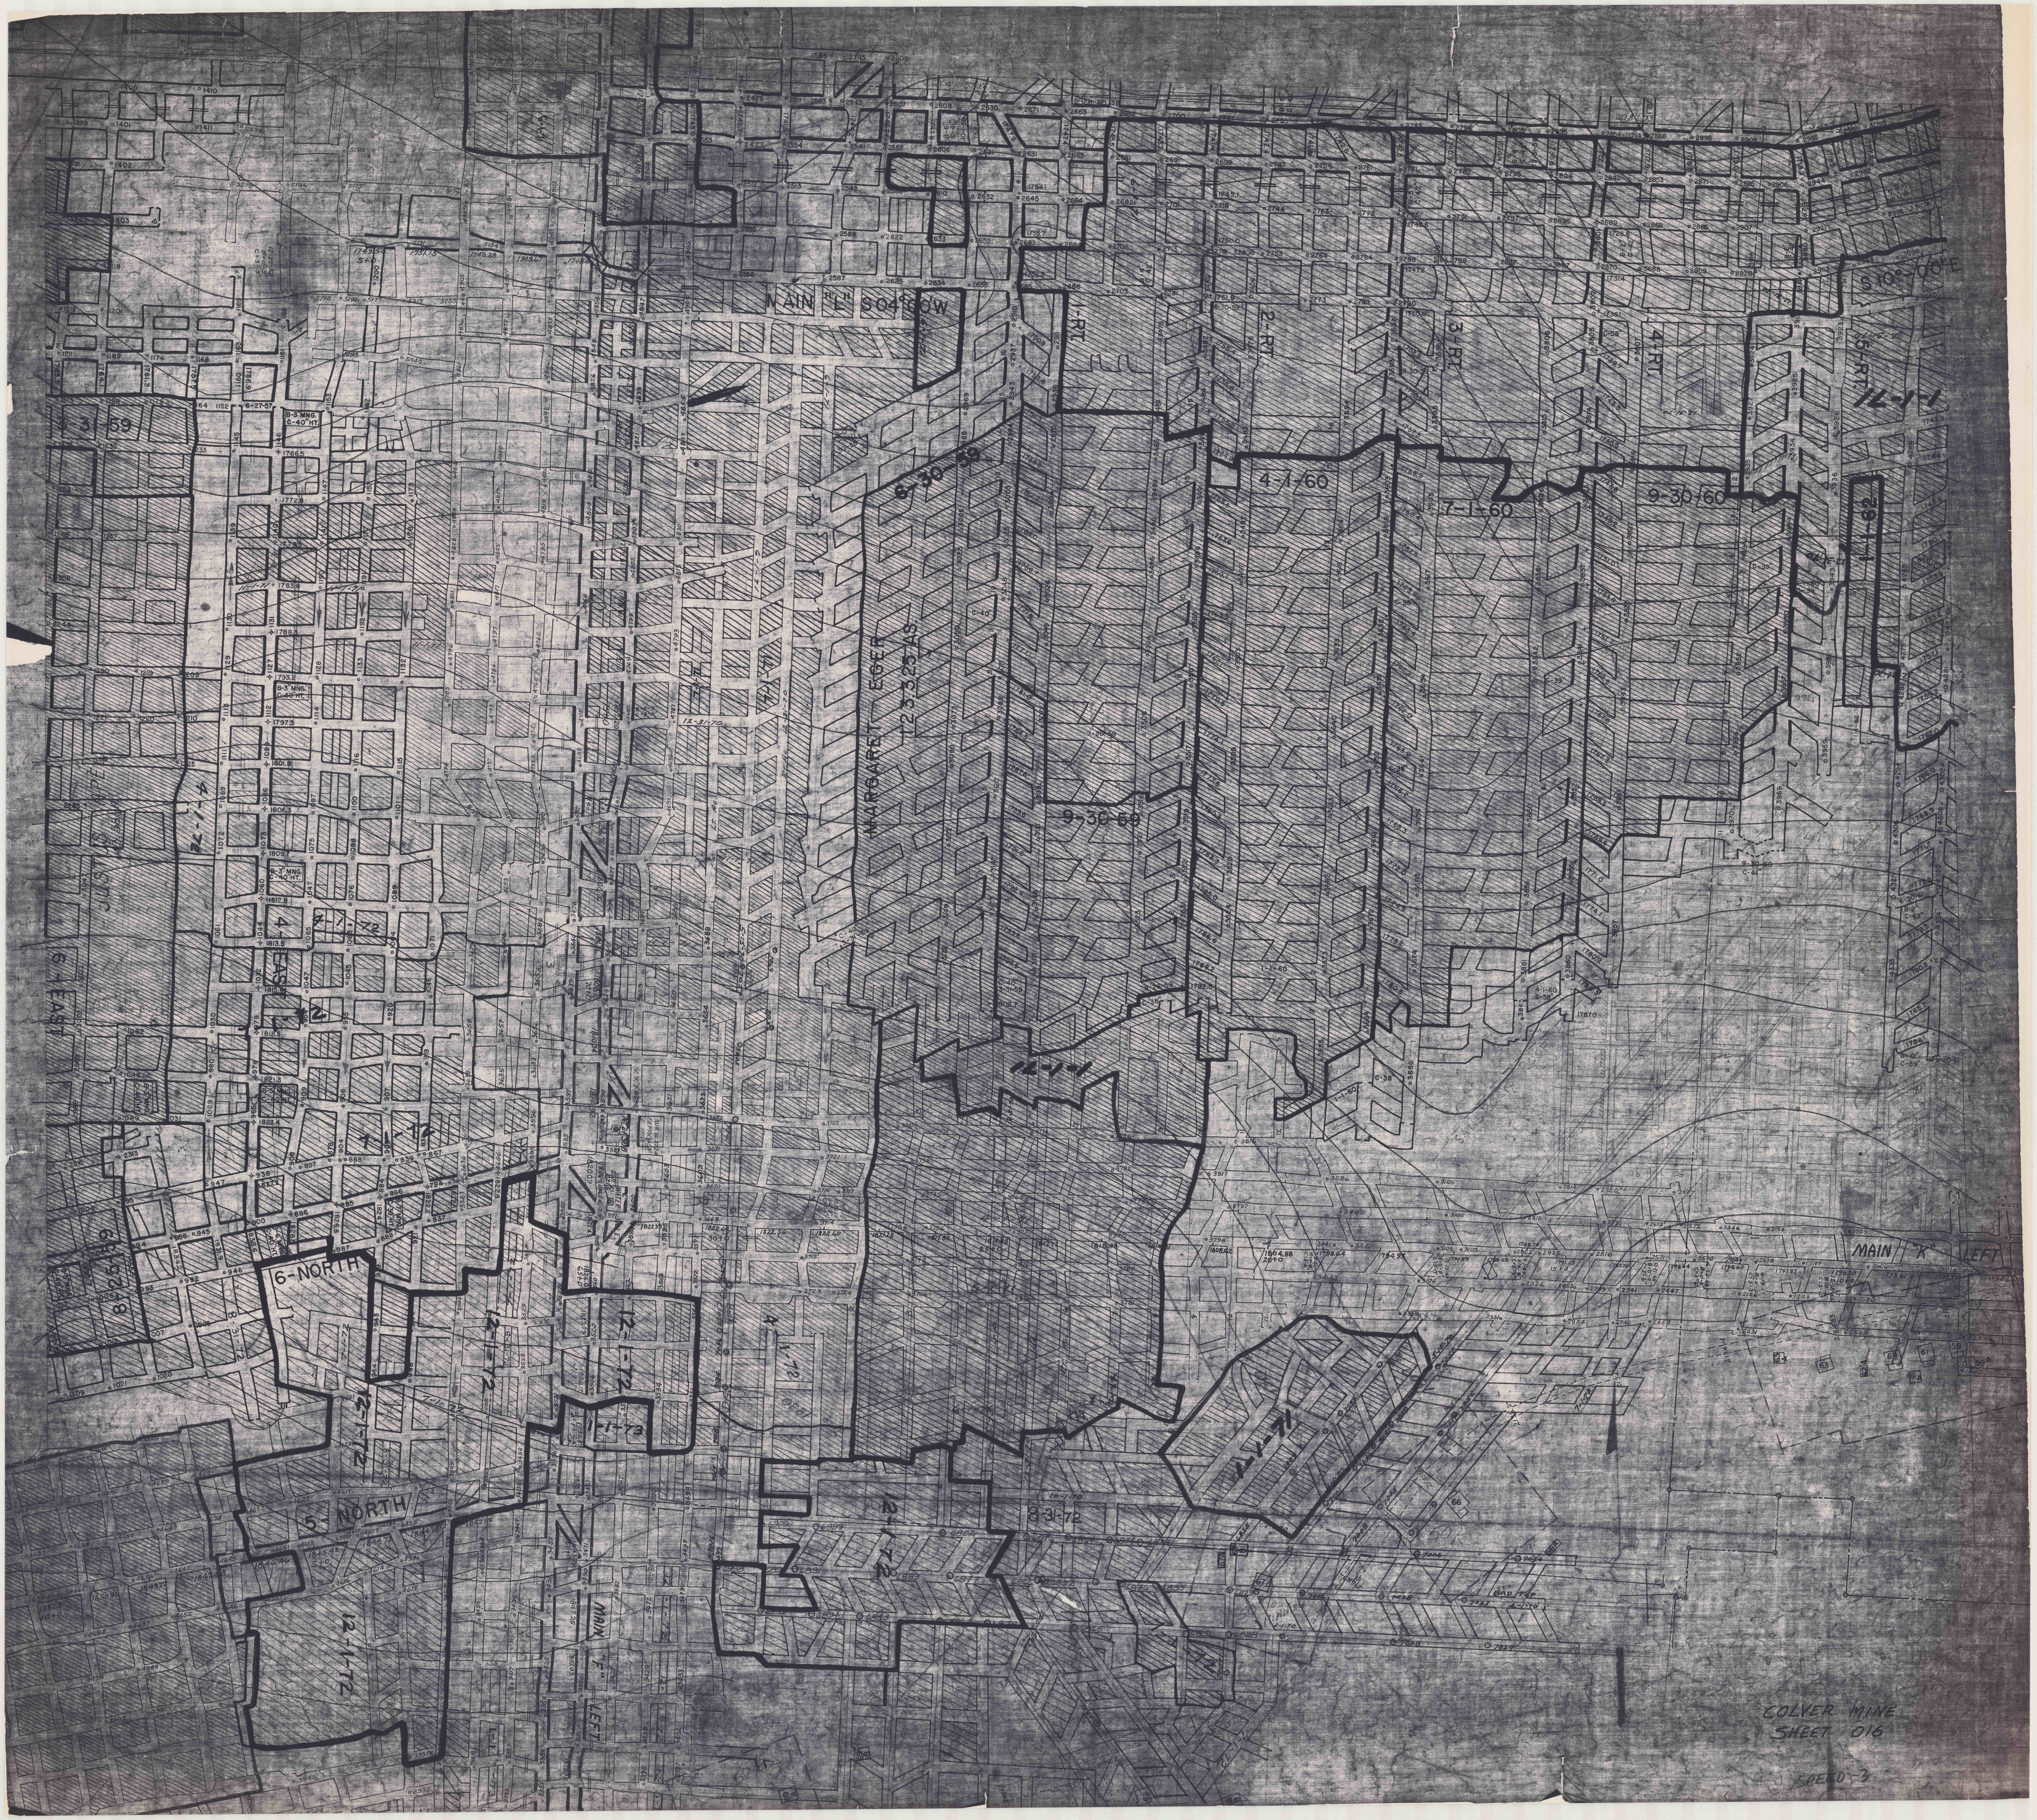
MAIN "L" S04°00'W
1-RT.
2-RT.
3-RT.
4-RT.
5-RT.
S10°-00'E
12-1-71
6-30-59
4-1-60
7-1-60
9-30-60
9-30-59
MARGARET EGER 12-3-325 AS
3-31-59
6-27-57
B-3" MNG. C-40" HT.
12-31-70
6-EAST
4-1-72
4-EAST
11-1-72
11-1-71
6-NORTH
12-1-72
1-1-73
8-31-72
5-NORTH
MAIN "F" LEFT
MAIN "K" LEFT
1-1-71
4-1-70
BAD TOP
9-30-60 C-41"
4-1-60 C-38"
1-1-60
C-38"

COLVER MINE
SHEET 016

SPEED-3