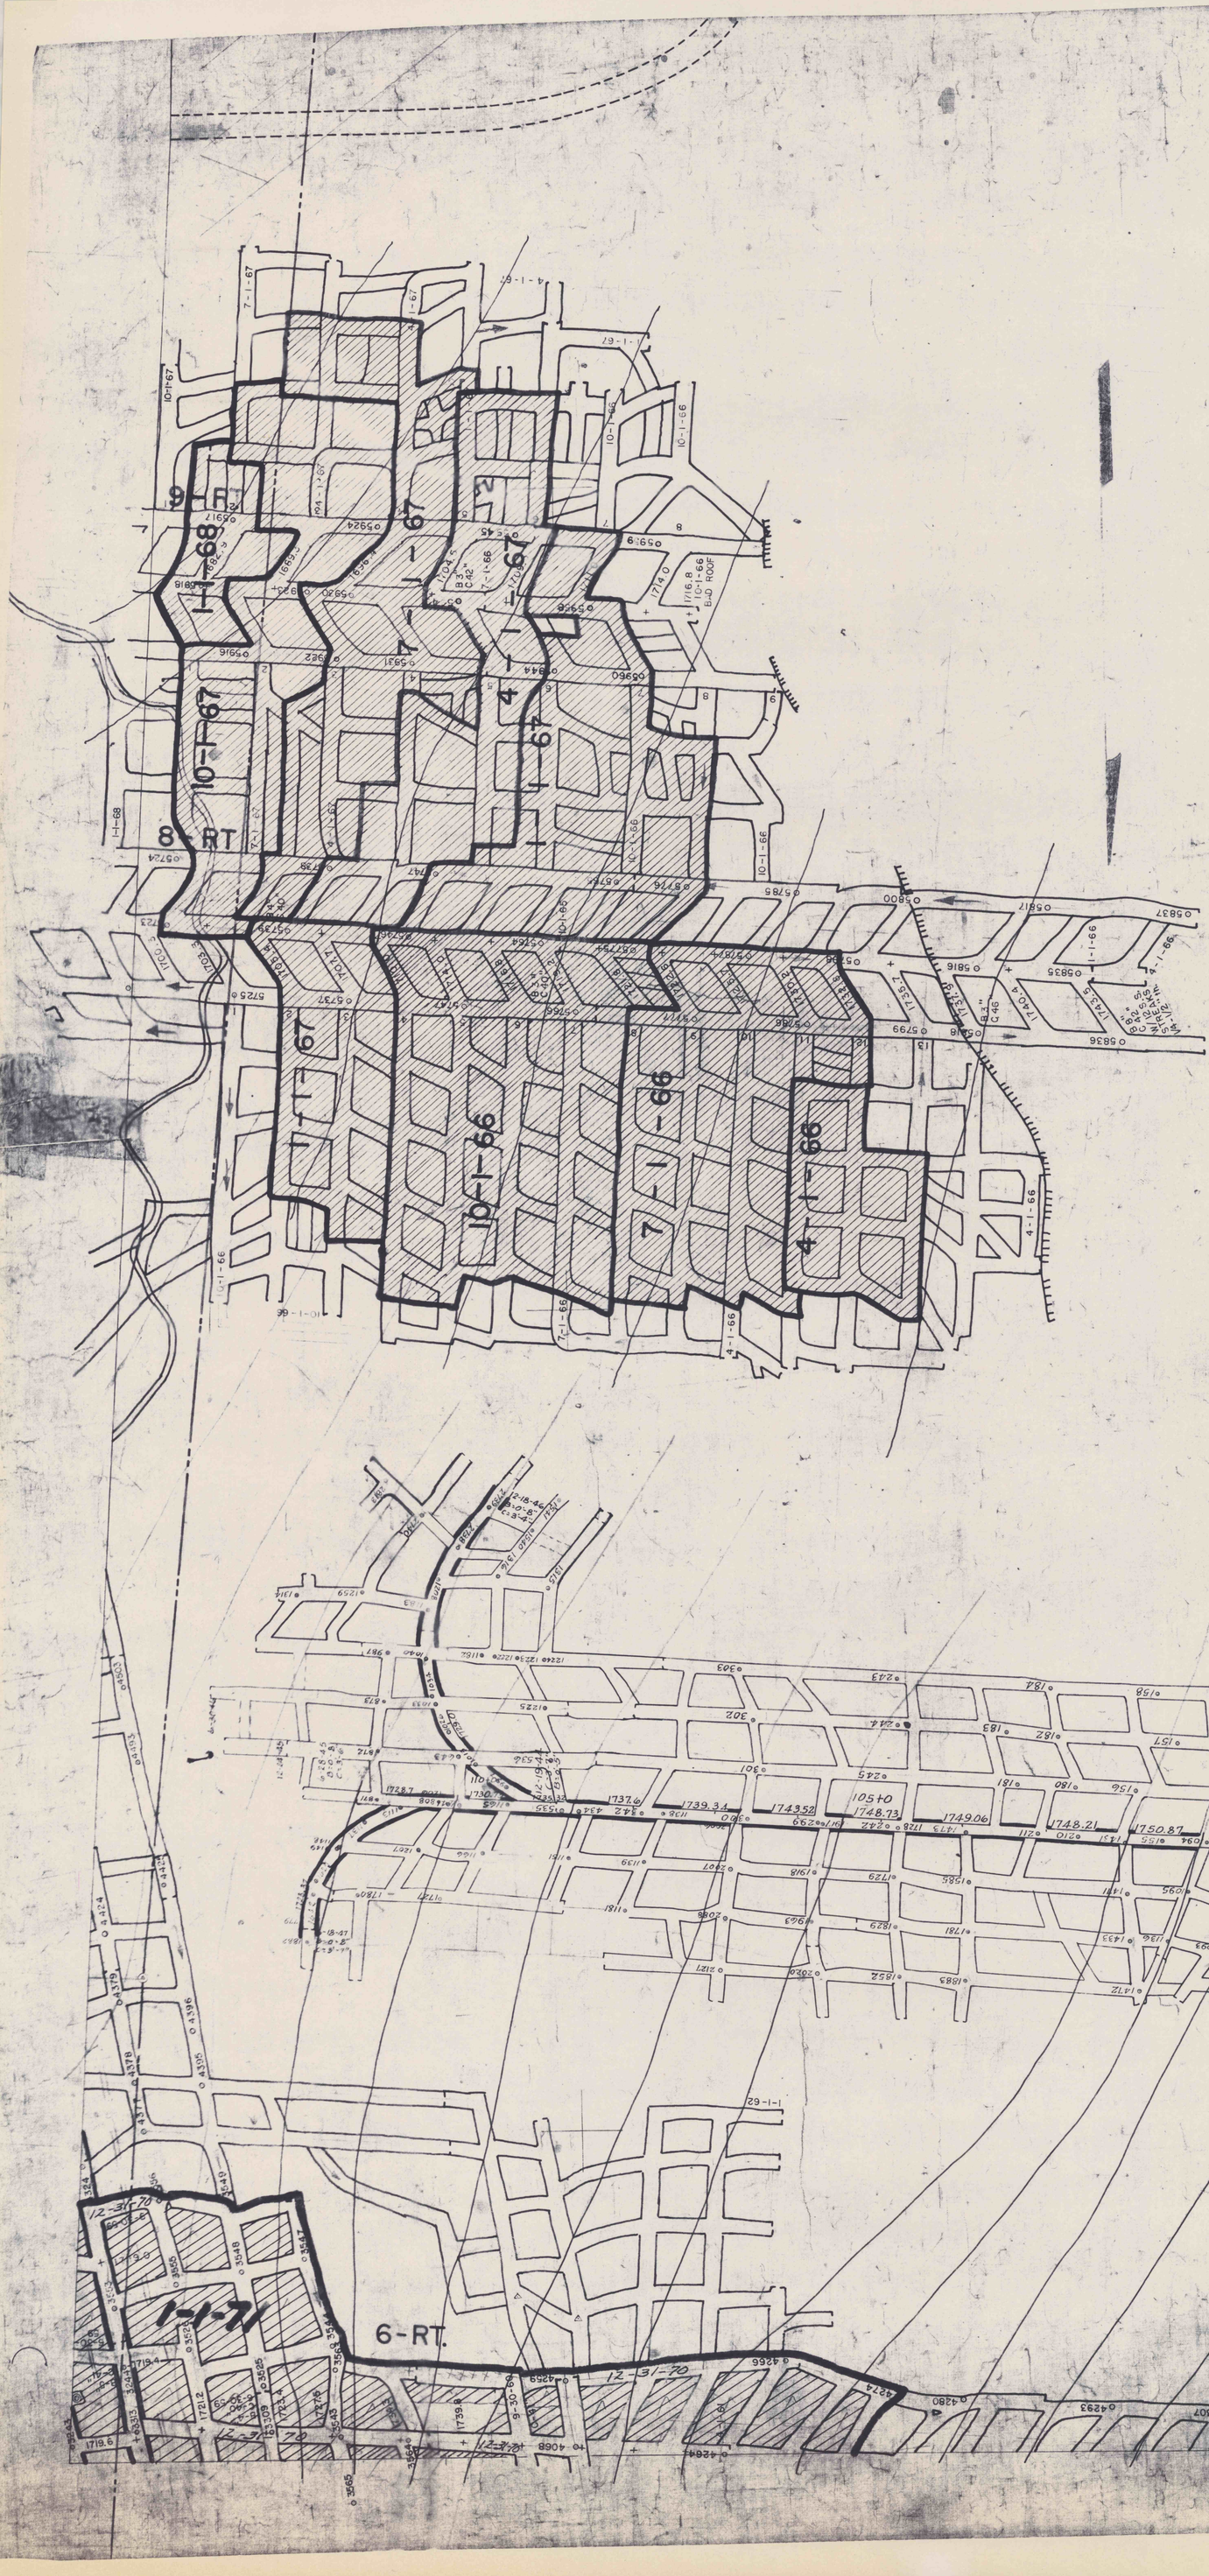
10-I-67
9-RT
8-RT
7-I-67
6-I-67
5-I-67
4-I-67
3-I-67
2-I-67
1-I-67
10-I-66
7-I-66
4-I-66
1-I-66
6-RT.
1-I-71
12-31-70
1-I-62
D.D.H.-39-'12
SUR. EL.-2087
S.S. TOP
B-3"
C-42" B.C. EL.-1760
S + C -7"
F.C. - BOT.
MAIN "K" LEFT
SHEET 0-17
SPEED-5