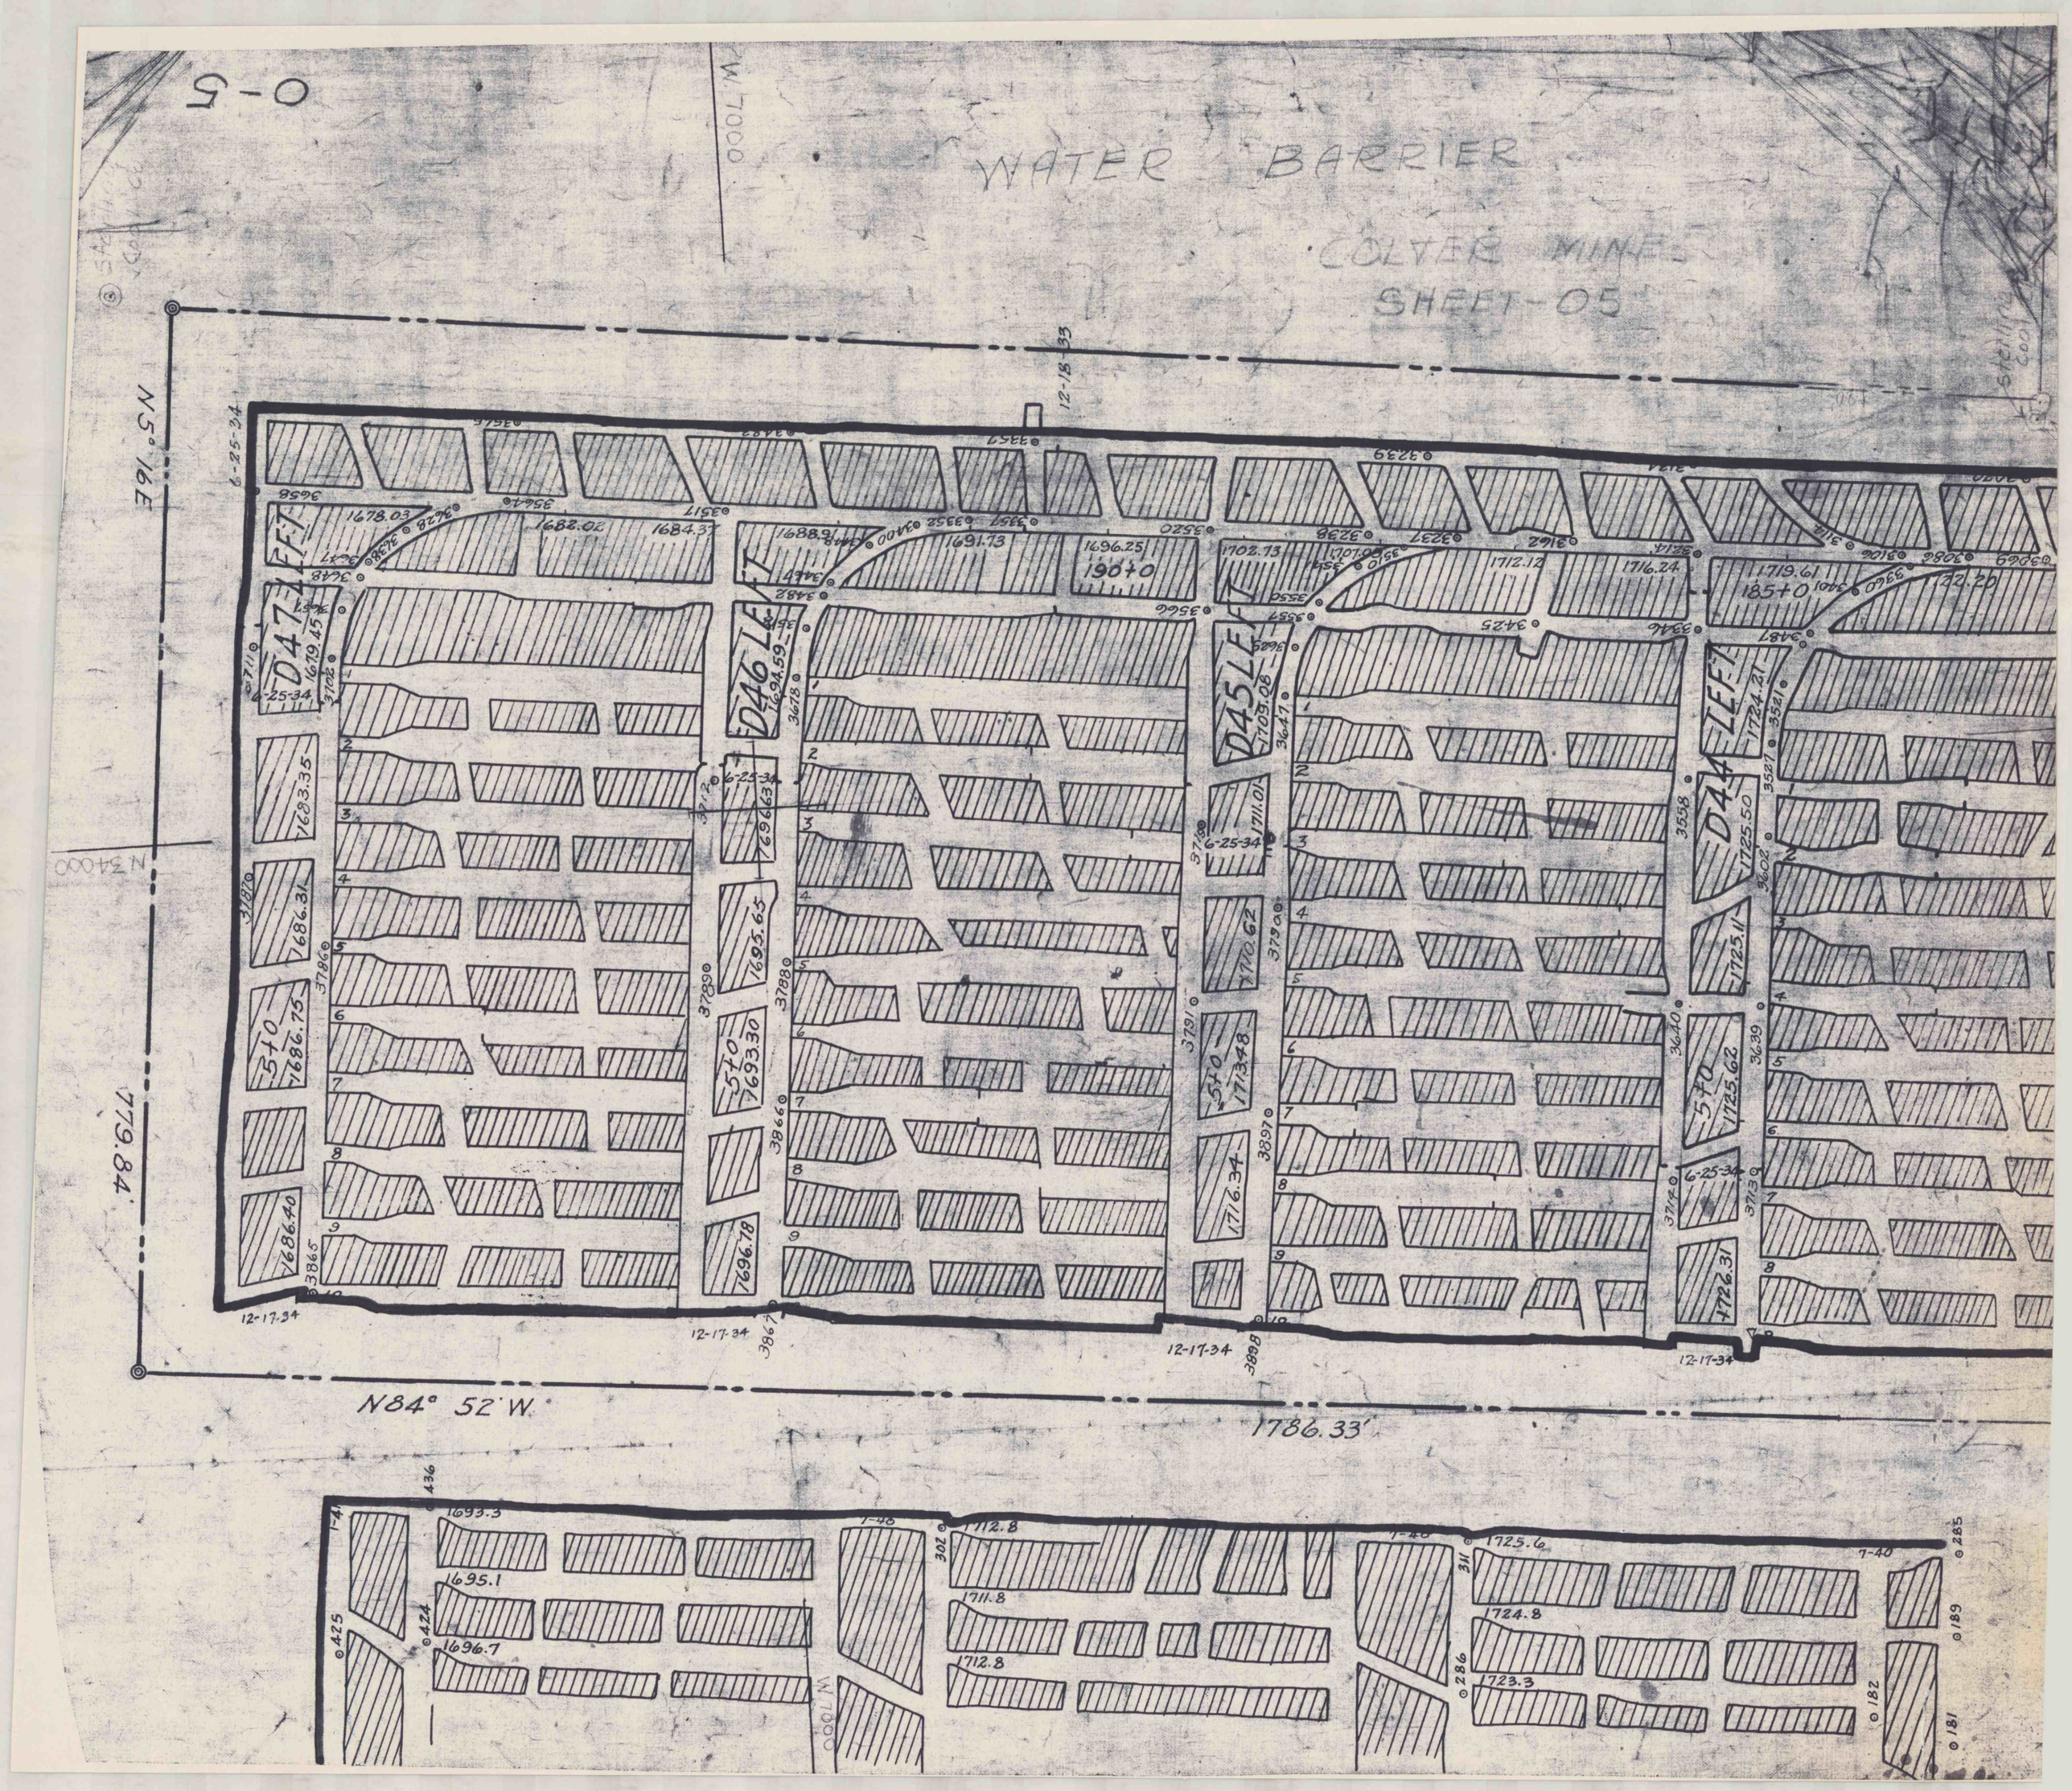

0-5
WATER BARRIER
COLVER MINE
SHEET-05
W. 7000
N5° 16E
N34000
779.84'
N84° 52' W.
1786.33'
D47 LEFT
D46 LEFT
D45 LEFT
D44 LEFT
190+0
185+0
5+0
12-17-34
12-18-33
6-25-34