




FINAL MAP

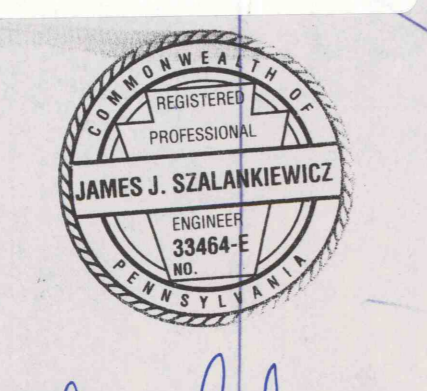

Holl

(47) DARMAC NO. 3 DEEP MINE - C.M.A.P. 03901304
 SUBSIDENCE MAP LEGEND

RECEIVED
 FEB 17 2004
 Dept. of Environmental Regulation

Gas Well / Active	○
Gas Well / Abandoned	○
Spring	○
Water Well	○
Coal Contour	—
100 Foot Cover Line	—
Six Month Contemplated Mining	—
Permit Boundary	—
Limit of Mining / Subsidence Boundary	—
Limit of 500' - 600' Adjacent Area	—
Upper Freeport Outcrop	—
Property Line	—
Intermittent Stream	—
Perennial Stream	—
Drill Hole	•
Protected Structure	□
Unprotected Structure	□
Support Area	□
Pillared Area	□

Notes:
 Entry width will be 19 feet maximum, except in the
 well entry where it will be 20 feet.
 Surface and coal ownership are the same unless
 otherwise noted on this map.
 UNLESS NOTED, SUBSIDENCE AND PERMIT BOUNDARY ARE COMMON

UPPER FREEPORT SEAM

J.J.S. MINING, INC.'S CONTRIBUTION

DARMAC NO. 3 MINE
 PLUMCREEK & ARMSTRONG TWP.
 ARMSTRONG & INDIANA COS.
 SCALE: 1" = 100'