← 8

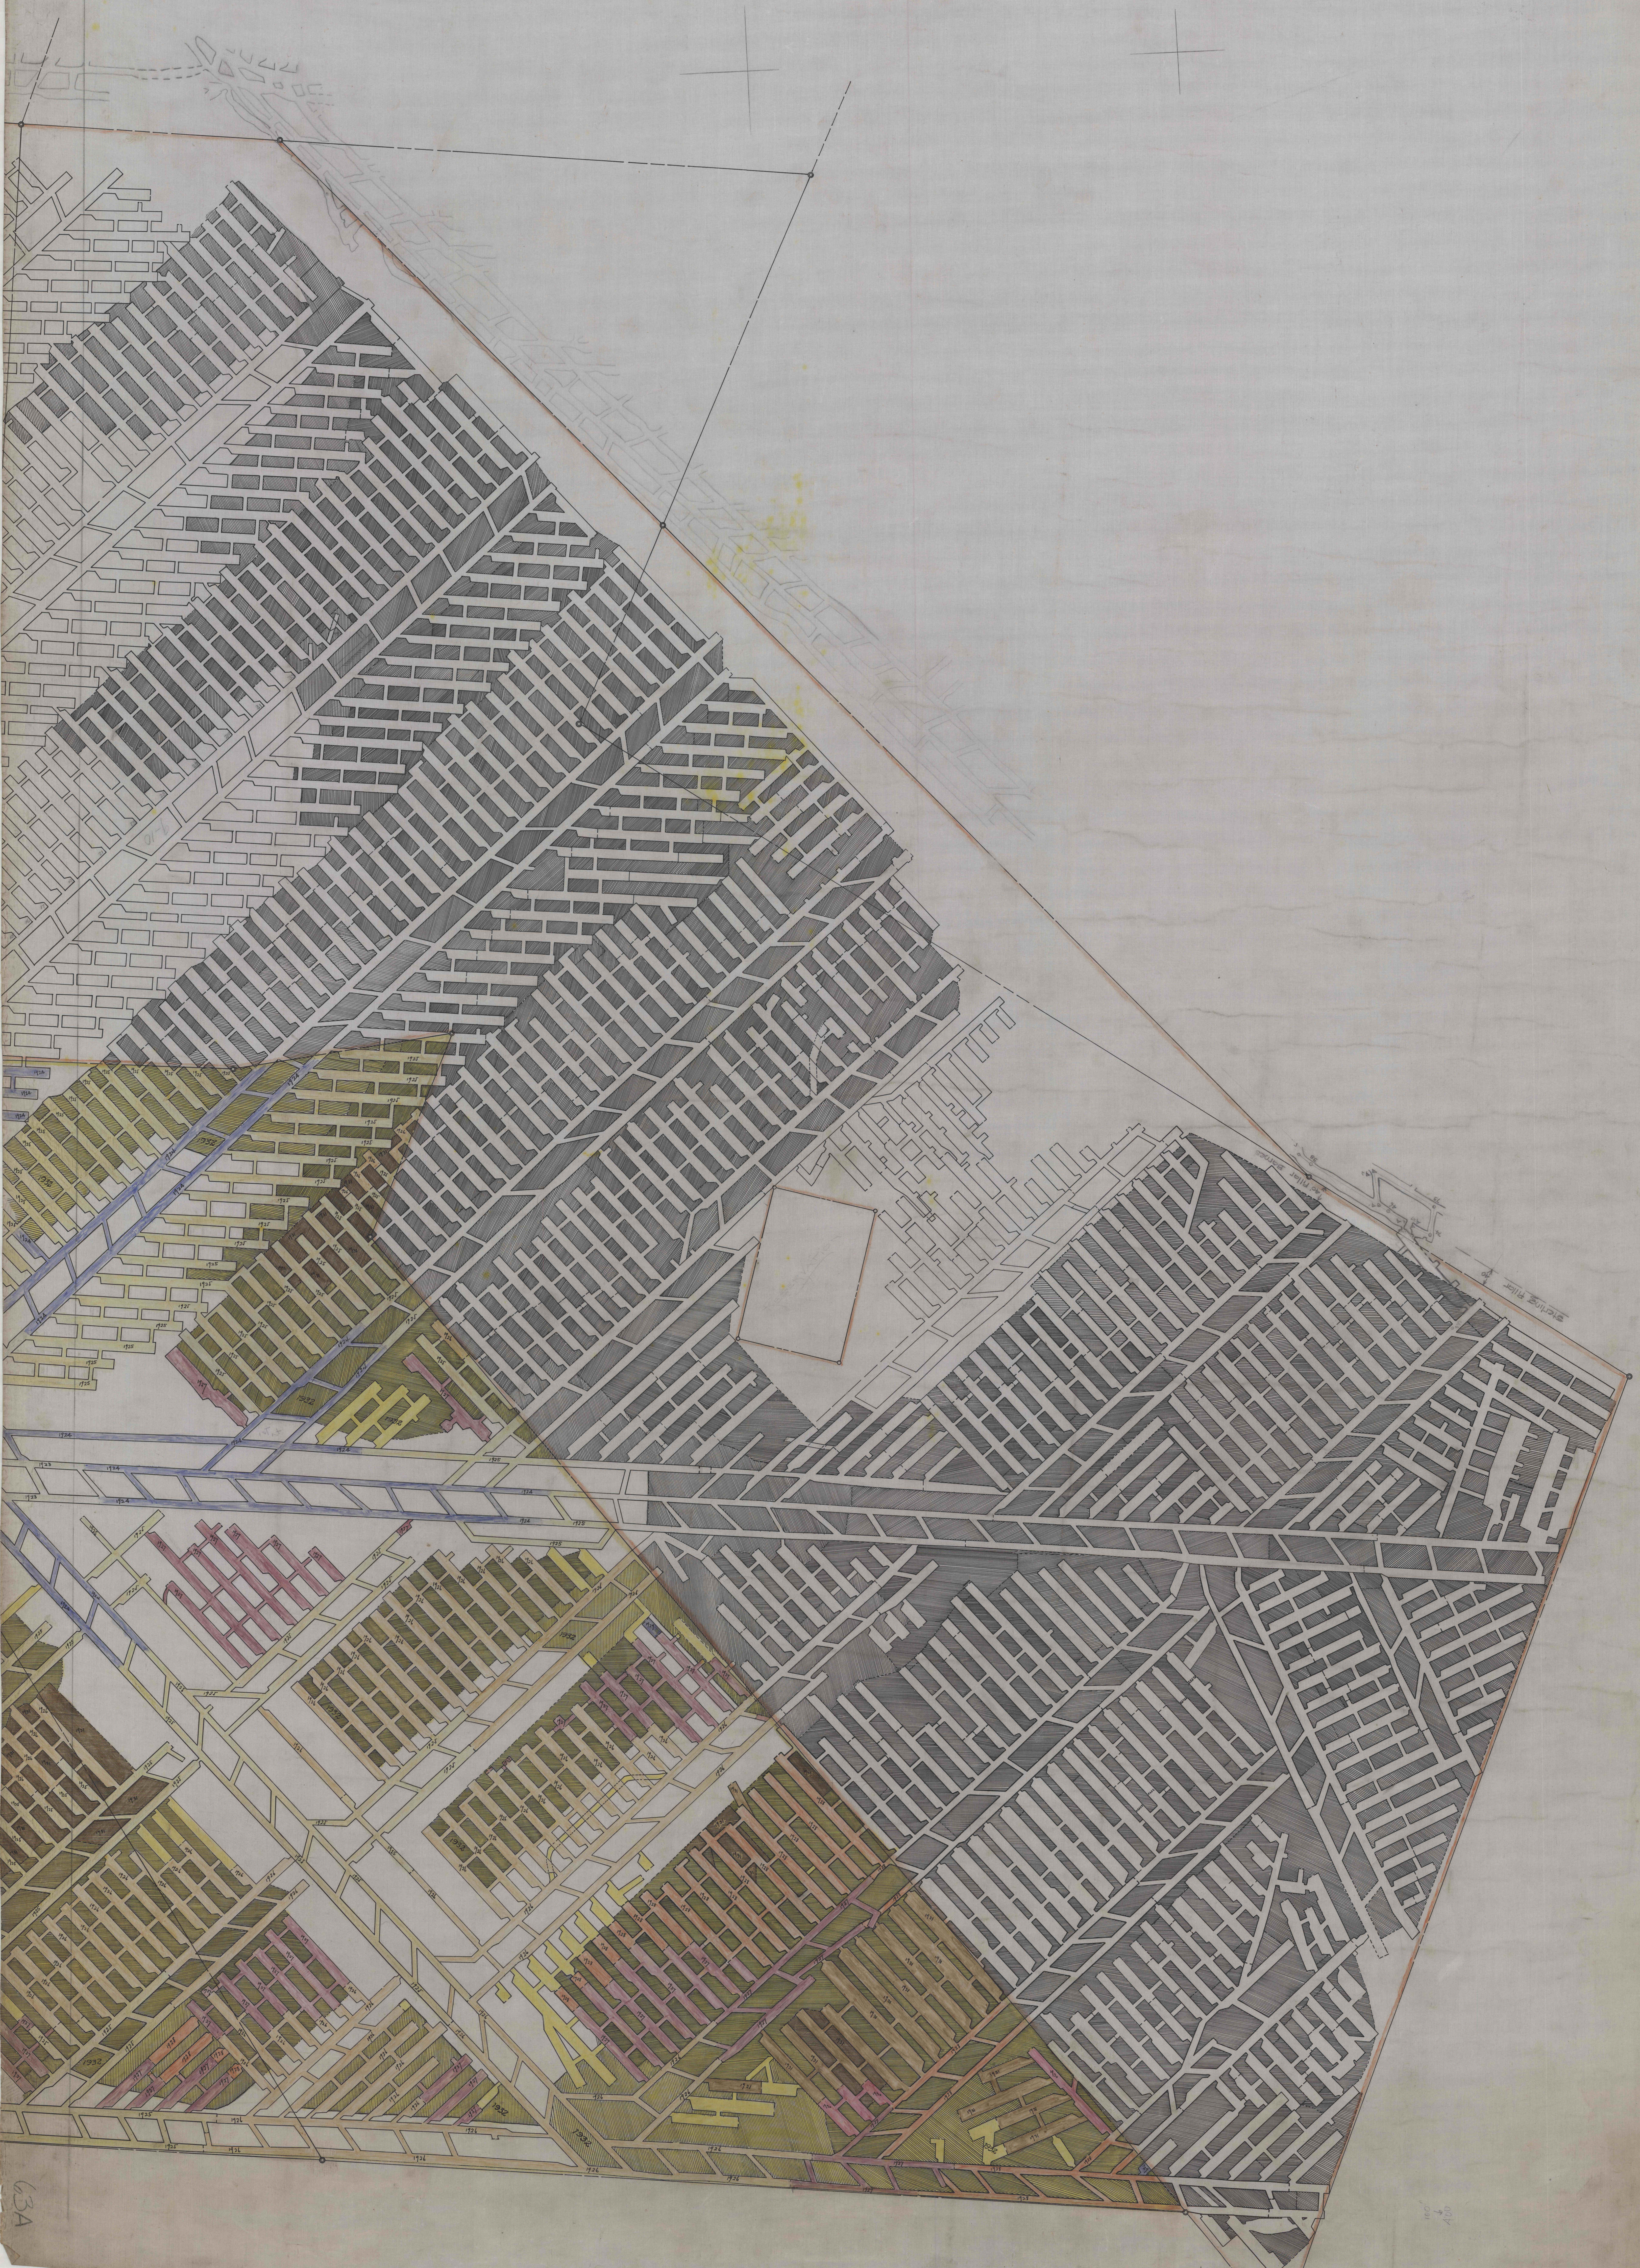
1925
1926
1927
1928
1932

63A