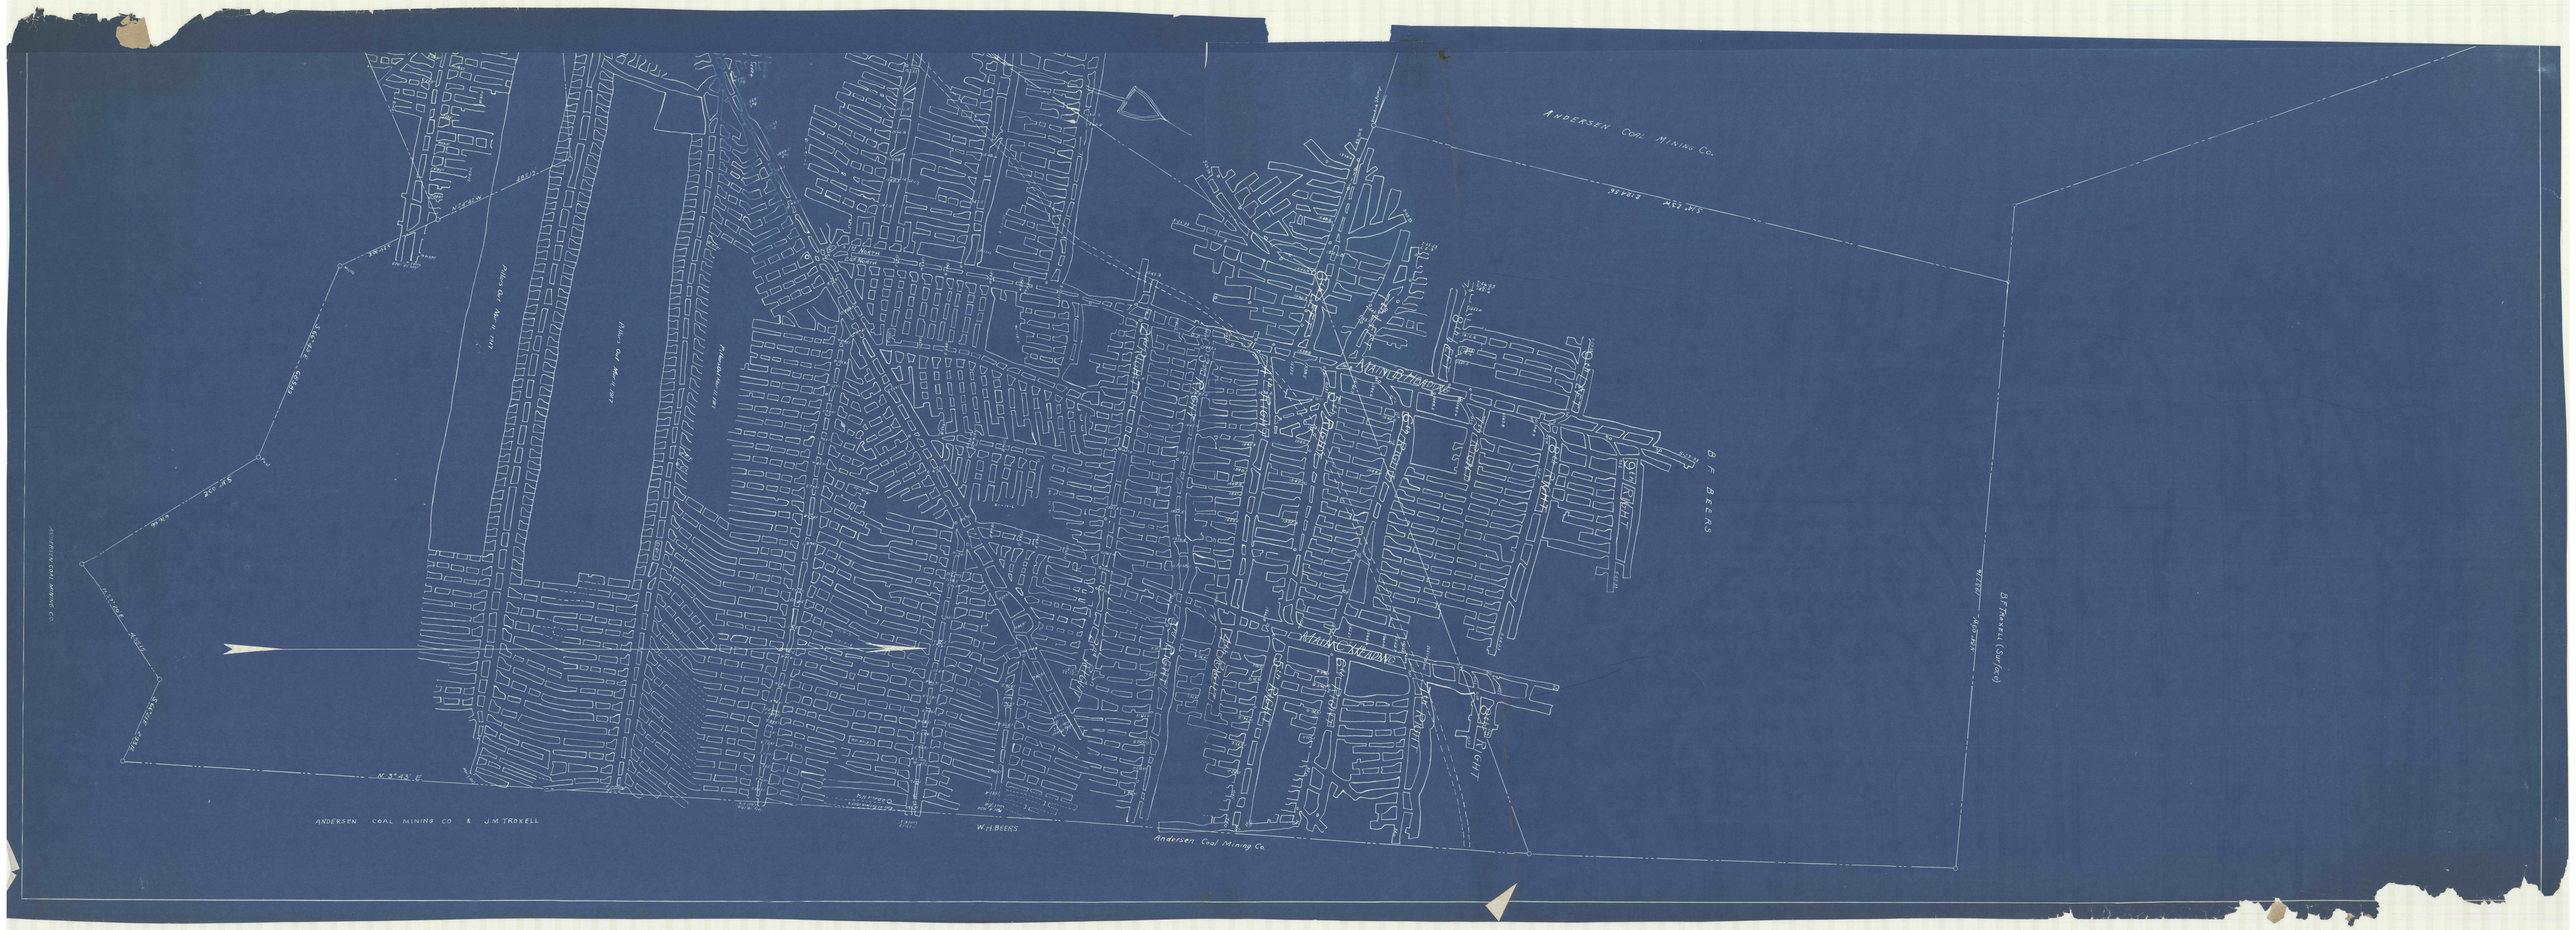
ANDERSEN COAL MINING CO.
B. F. BEERS
MAIN AVENUE
MAIN AVENUE
ANDERSEN COAL MINING CO & J.M. TROXELL
W.H. BEERS
Andersen Coal Mining Co.
N 3°45' E