


HENRY NICEWONGER

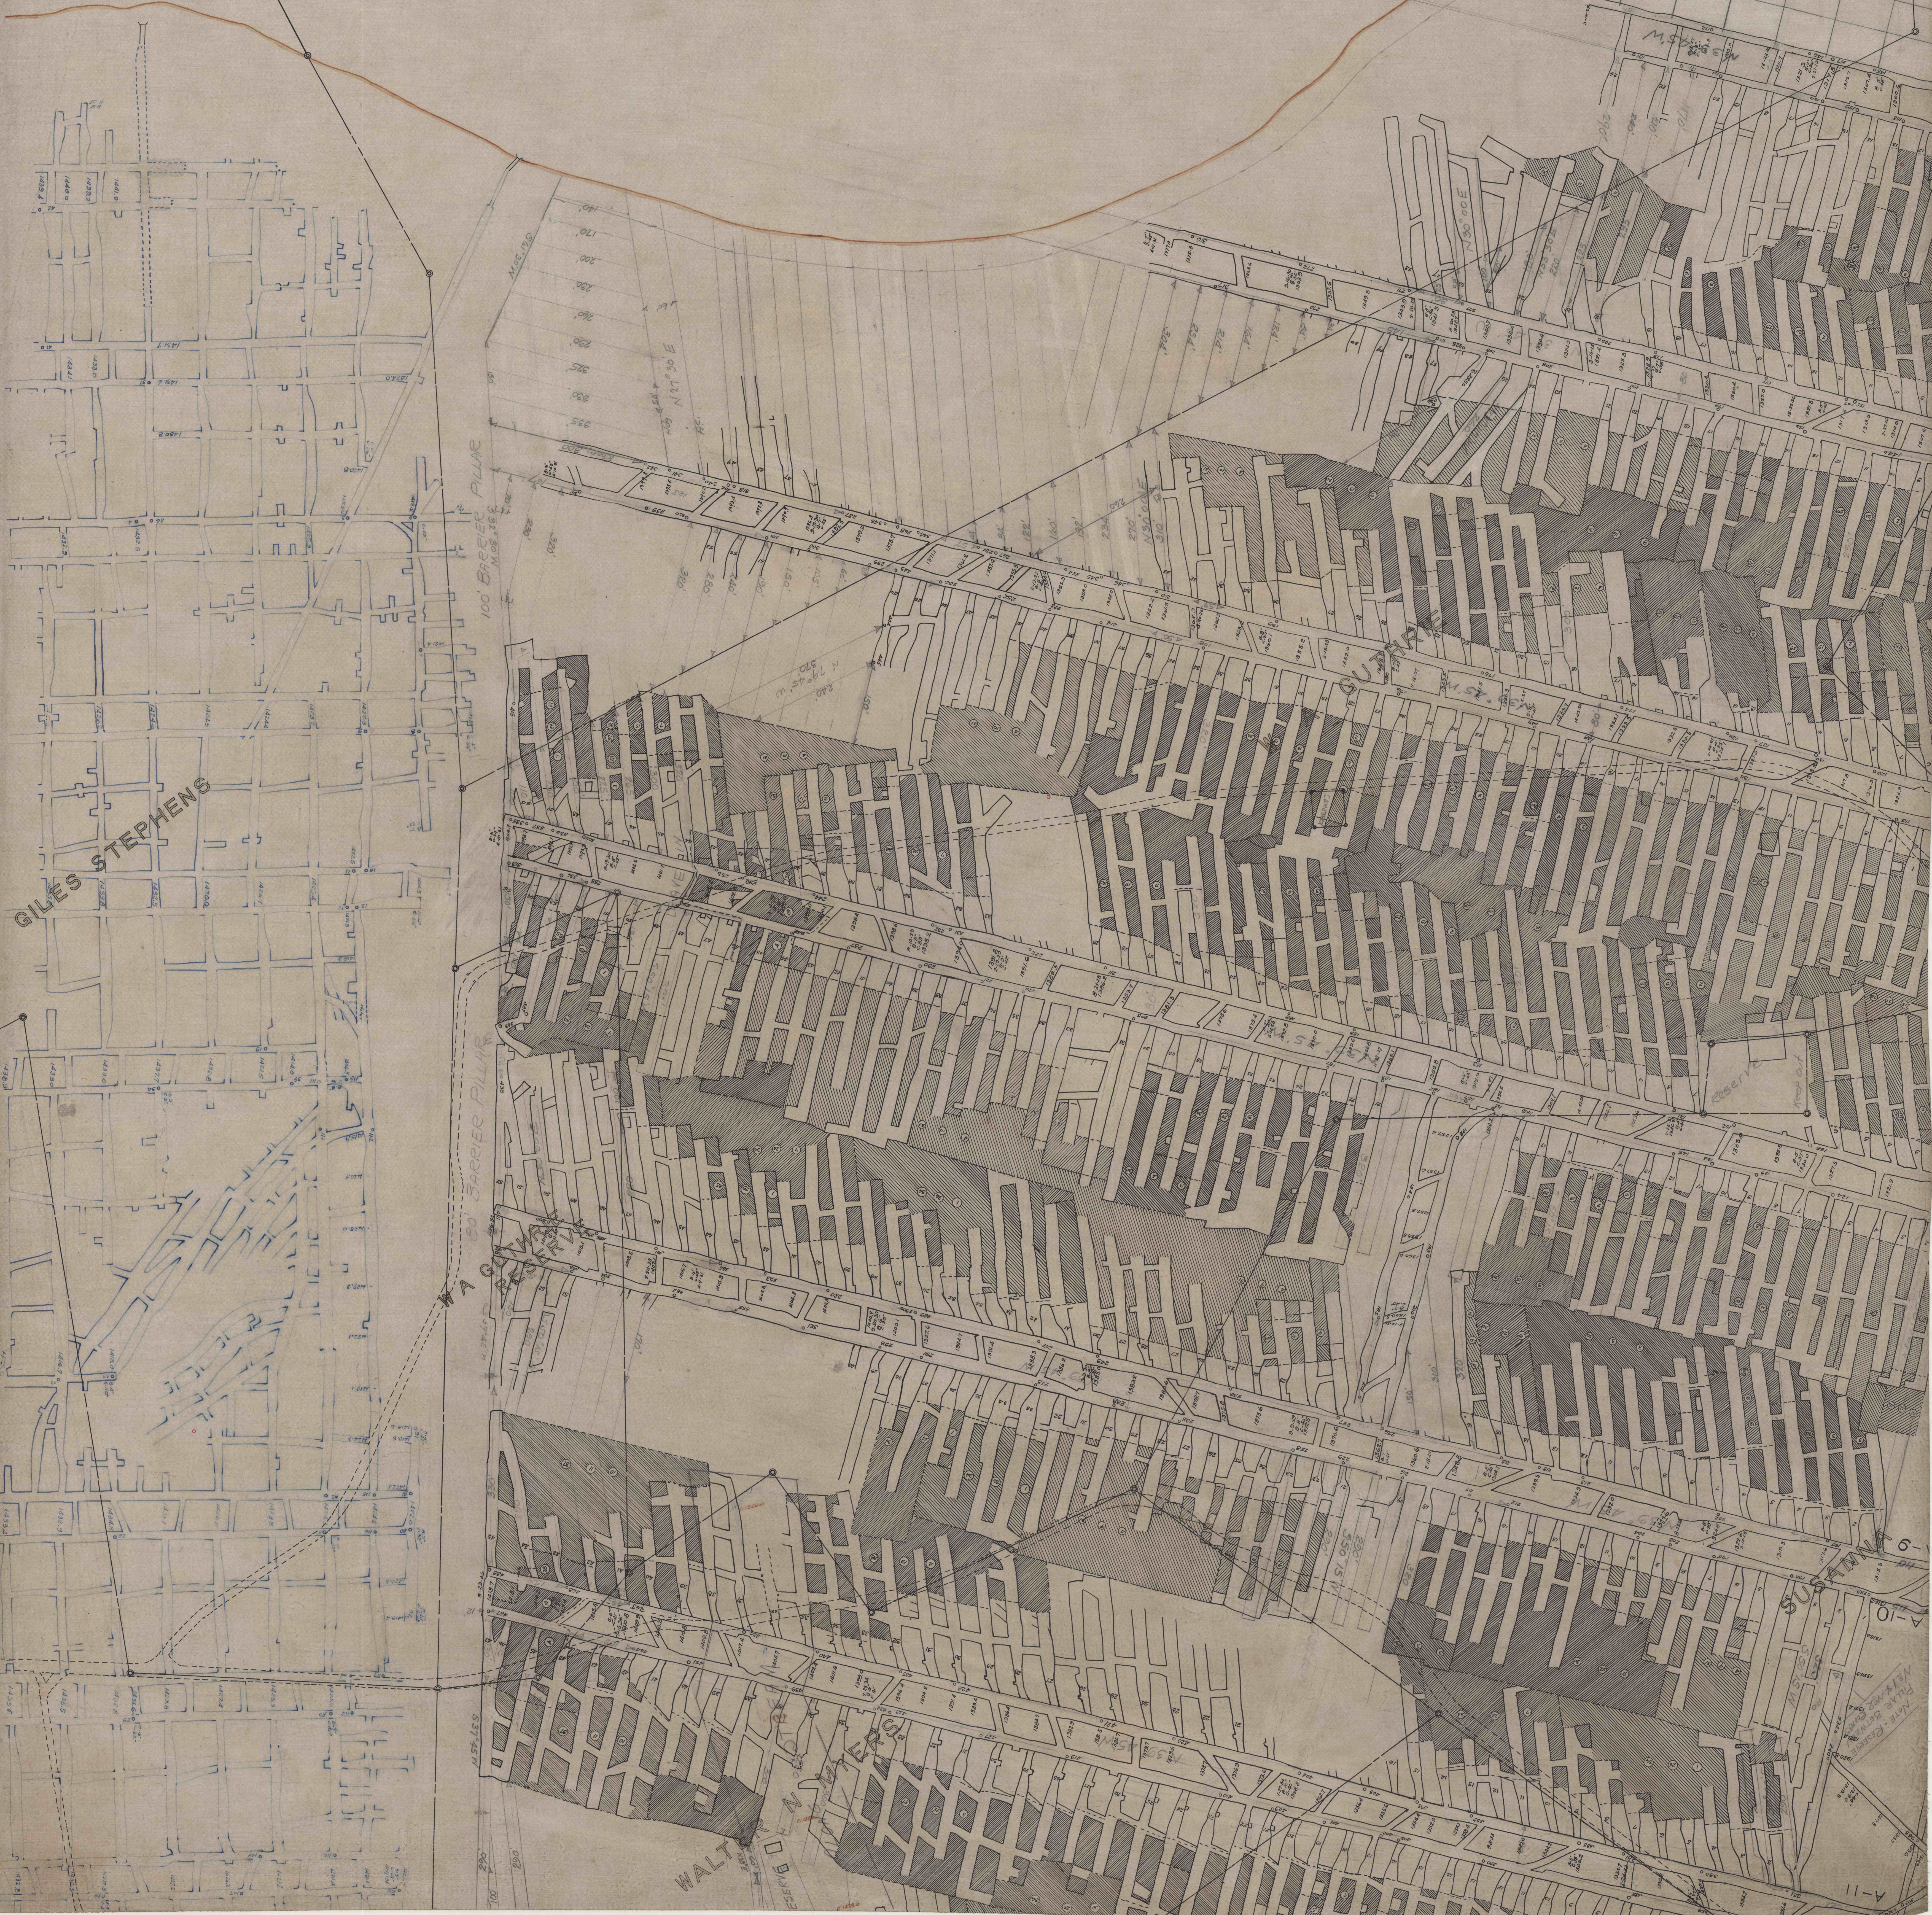

GILES STEPHENS

100 BARRER PILLAR

50 BARRER PILLAR

WALT

A-10  
A-11  
PLAN SHEET  
DATE