SUTTER-RINN COAL CO.

MAP OF MINE NO. 1

Situate- Plumville, Indiana. Co. PA.

Posted Nov. 1, 1923.

Note:- On account of the mine being full of water and inaccessible the places shown in dotted lines and the pillers which are shown as having been withdrawn were platted from information furnished by the Mine Manager.

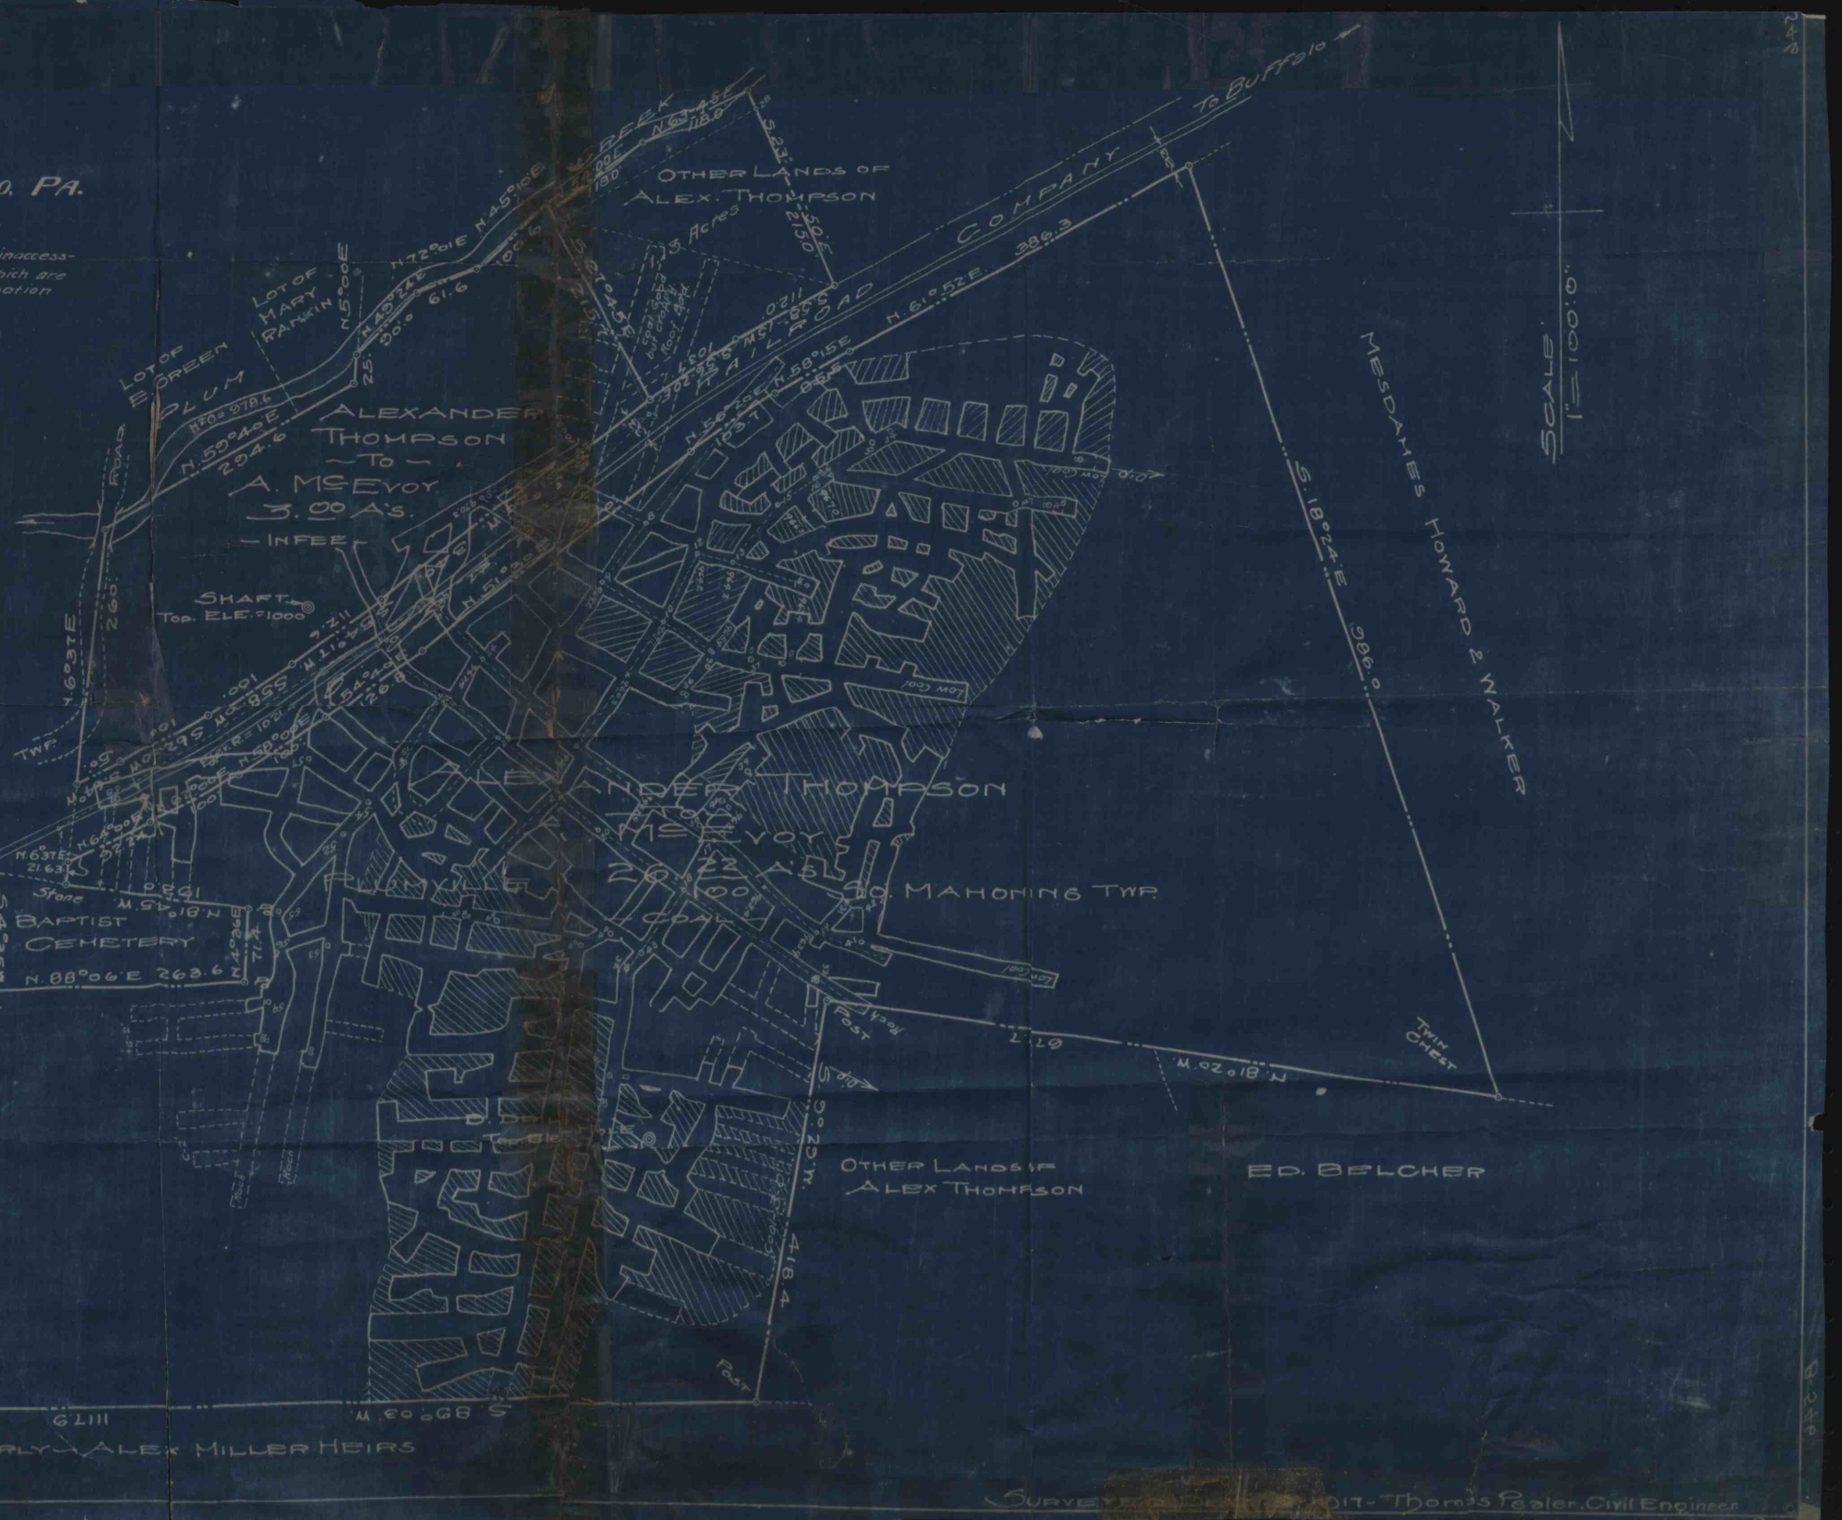

SURVEYED [illegible] 1917- Thomas Peeler, Civil Engineer Indiana, Pa.