


0 1-3/8
 A = 9.77
 M = 11.80
 S = 2.36
 BTU = 13967
 VM = 28.
 FC =
 Fusion = 2410
 Ck = 8 1/2
 Down
 Emeralds Coal M. Co
 Phila

Appalachia Mine

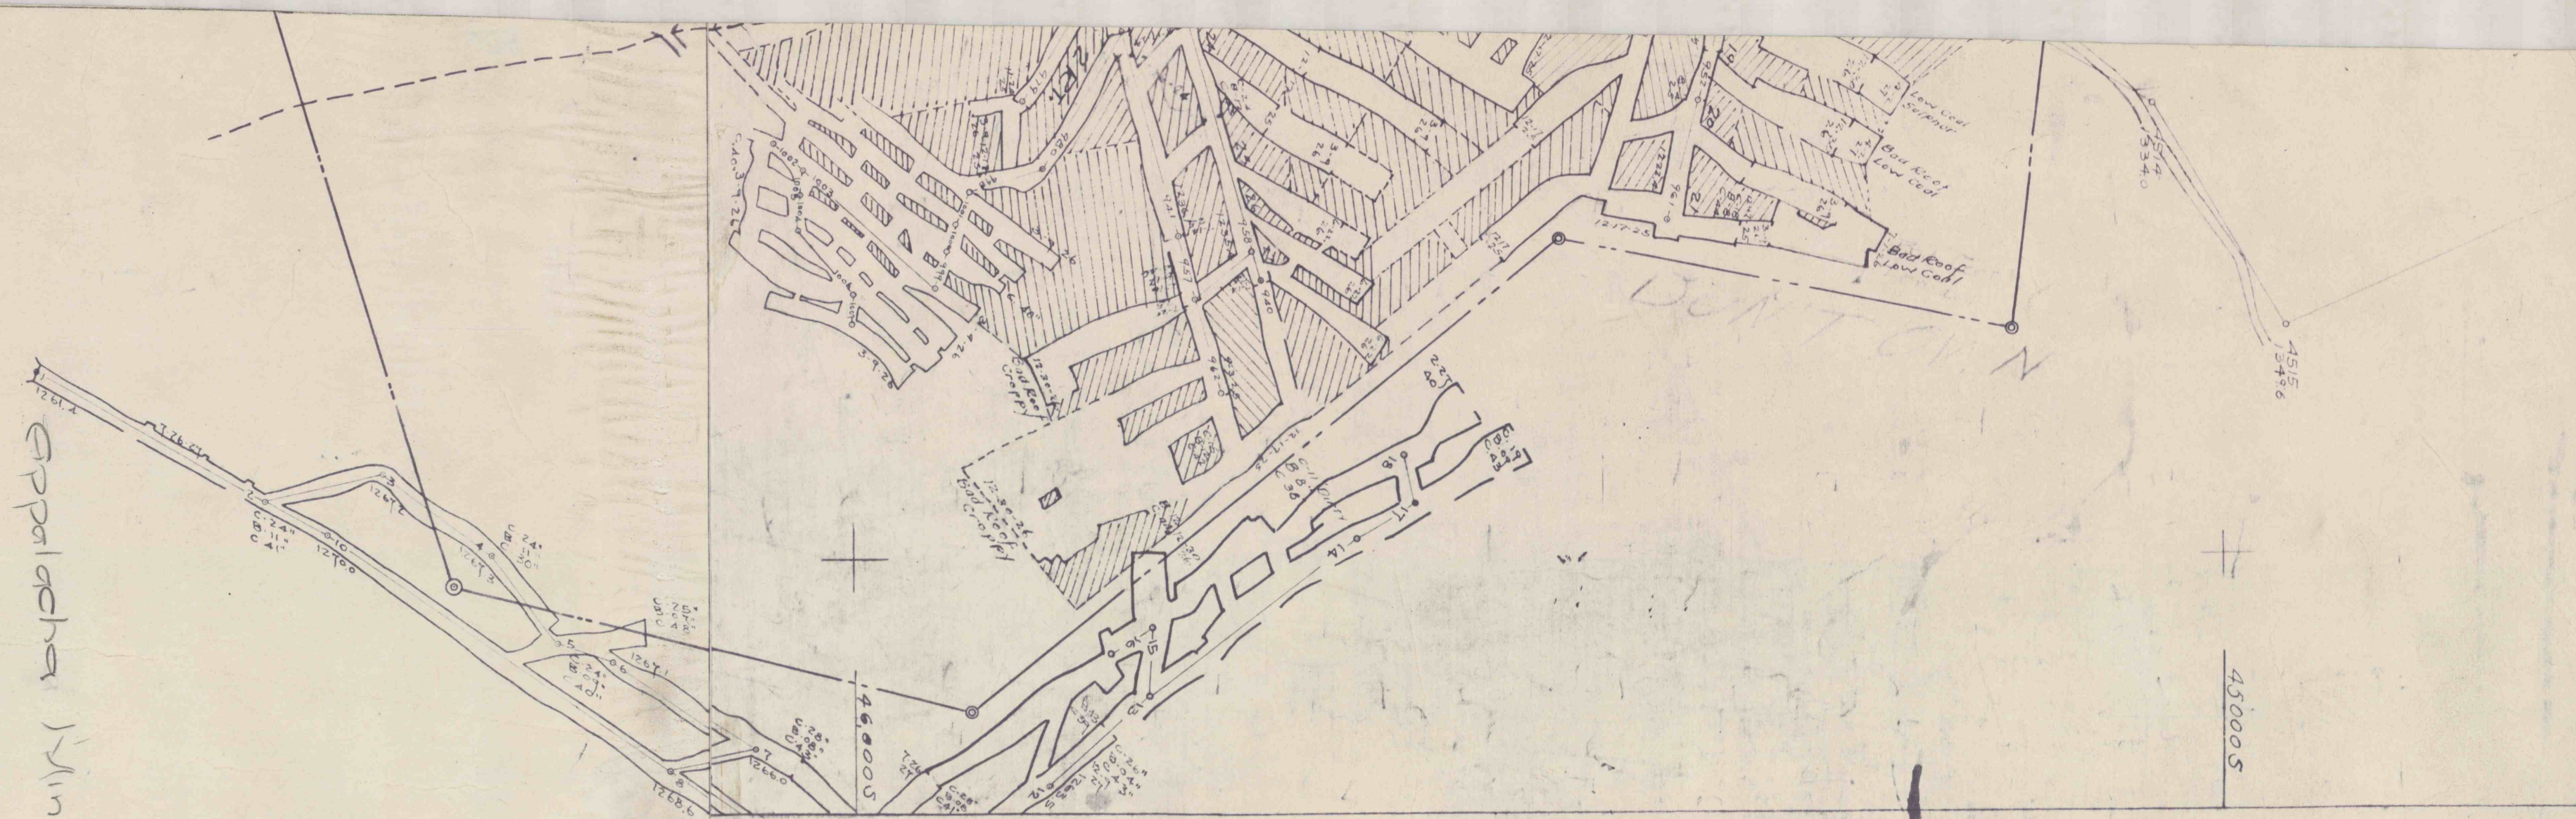

LUCERNE Trac. #1222
 Traced Sept. 20 1923 C.N.W

Cont'd o