


Area Calc  
 July 6-27 to Dec  
 31-1927

Note -  
 No provision made  
 for Barrier Pillar  
 along C.B.C. Property  
 Line -

No Allowance for  
 Mining loss or  
 House coal

Net for reference

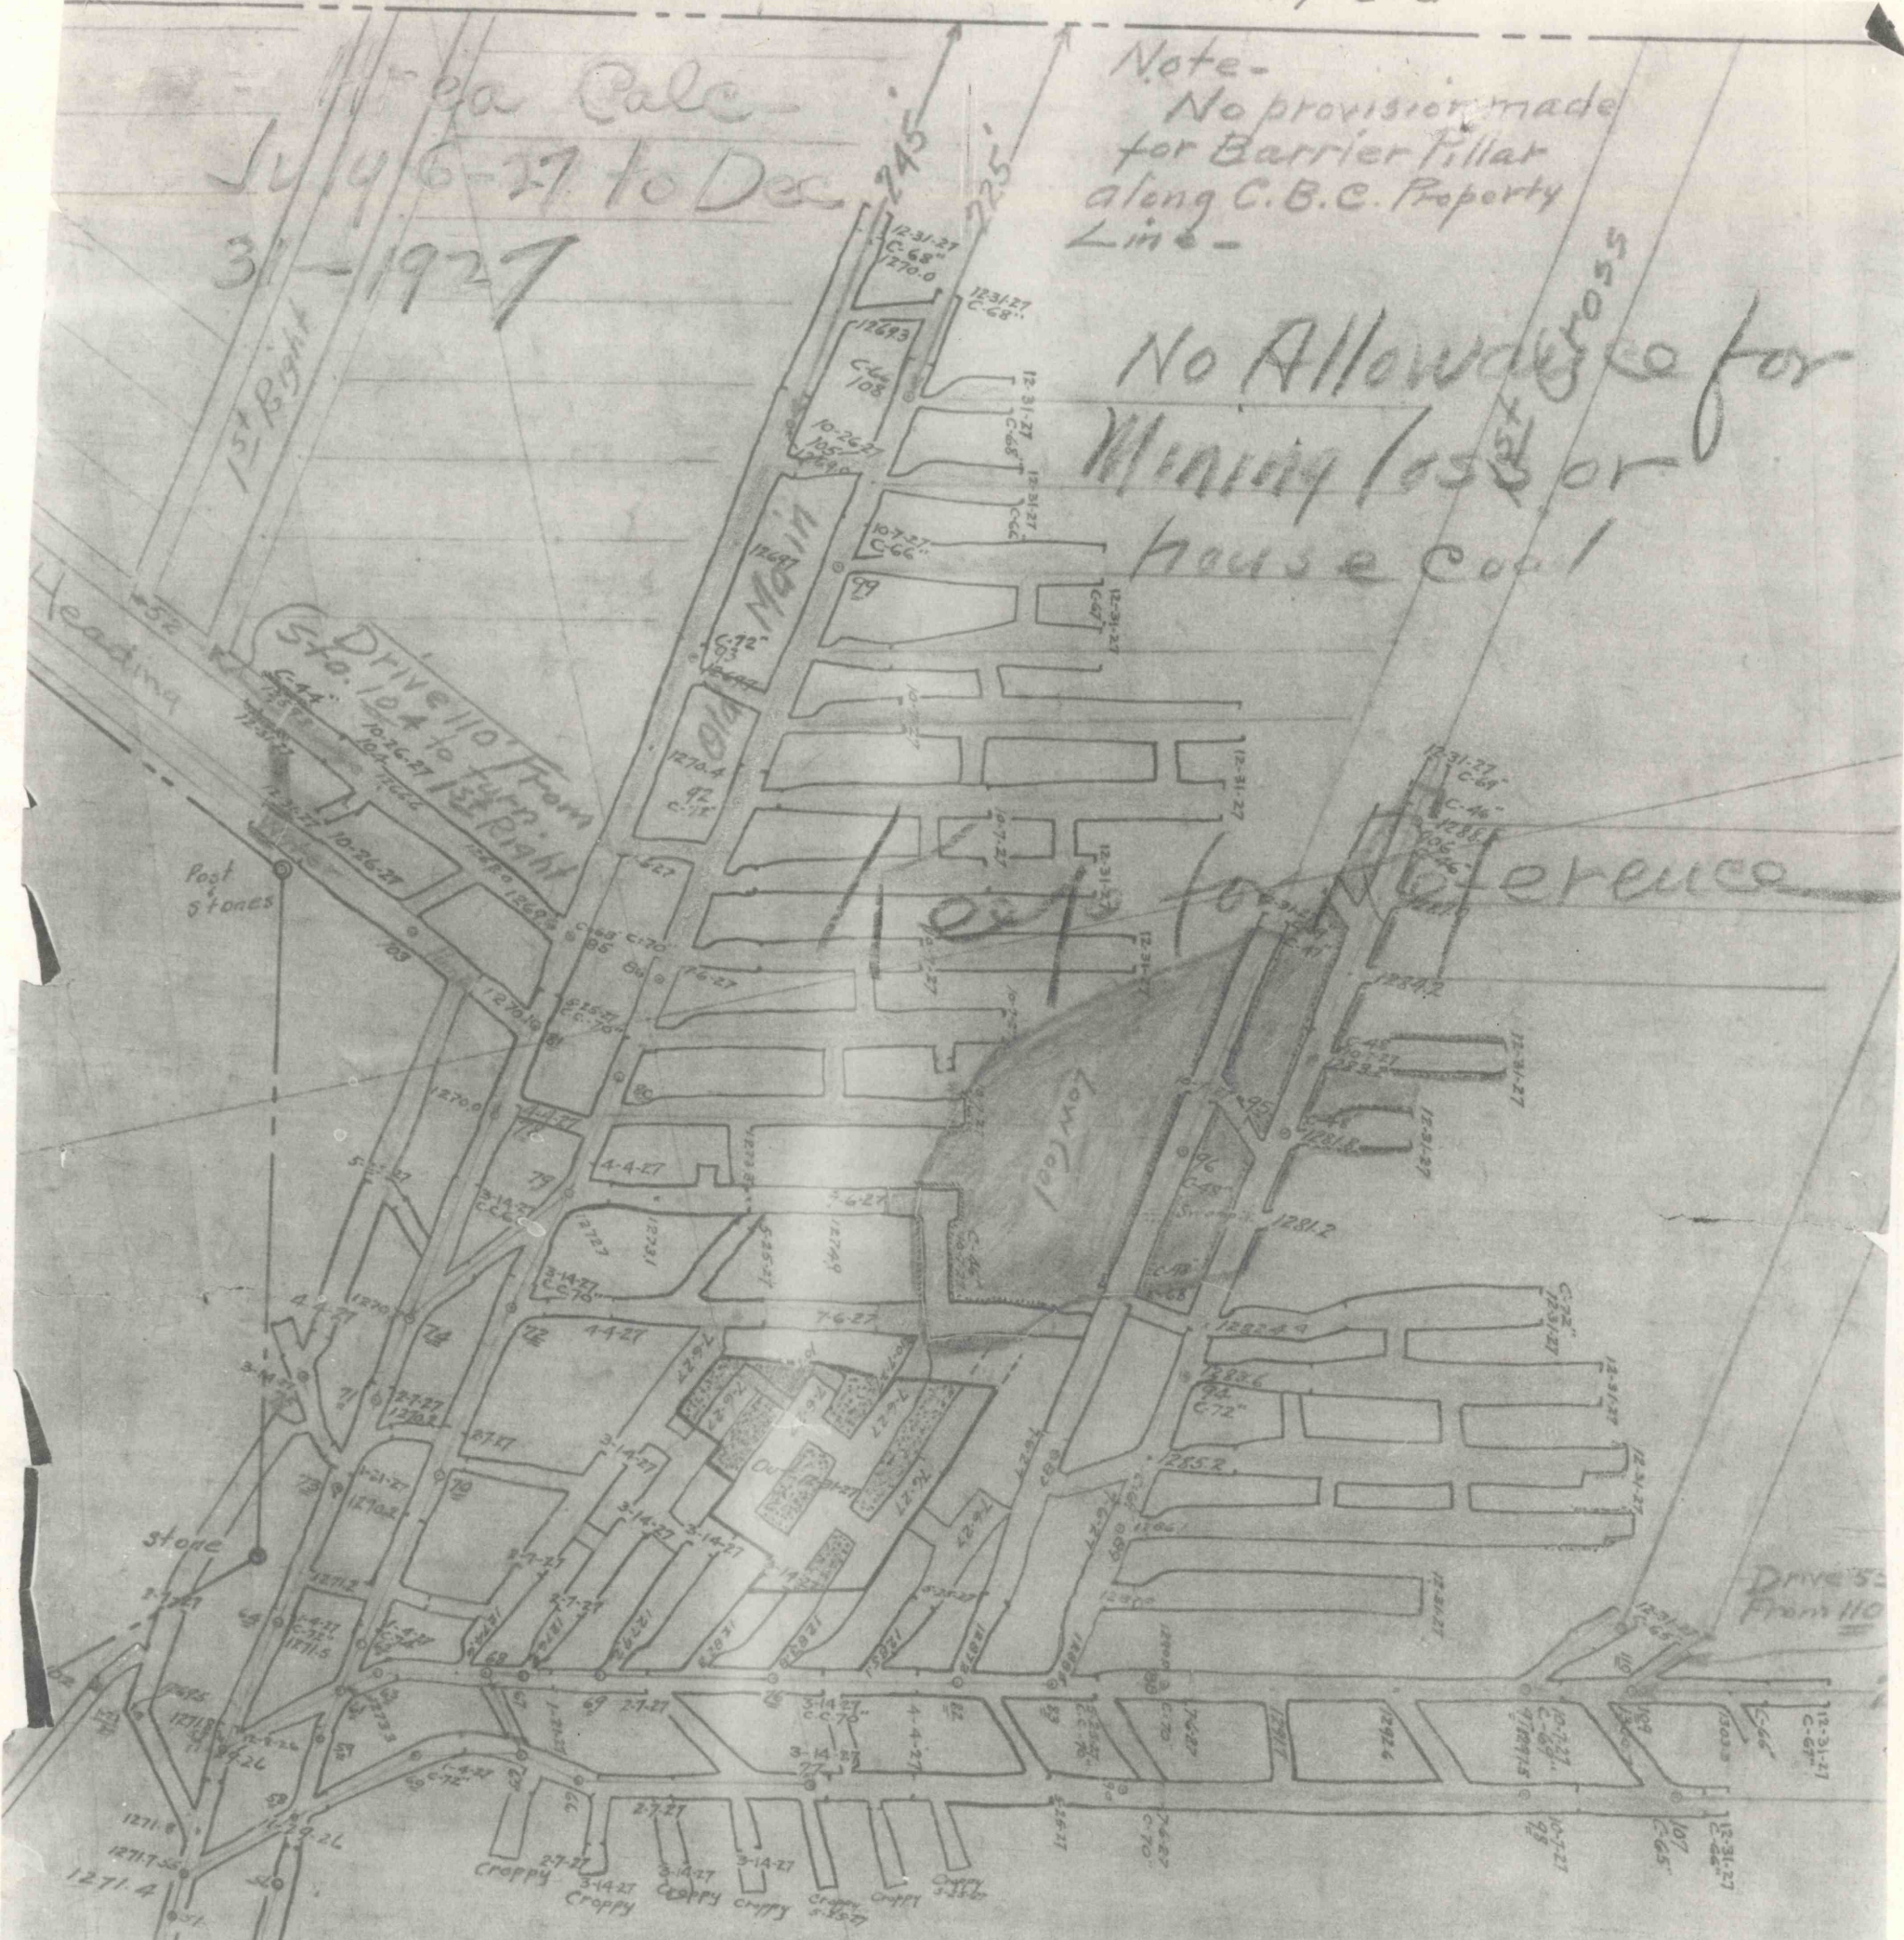

1800 tons per acre foot  
 Mined Out area in green = .4 Acre low coal " 48"  
 " " " = 2.73 " high " 68"  
 Total Mined Out July 6-27 to Dec 31-27 = 30726 Net T.