


A-9

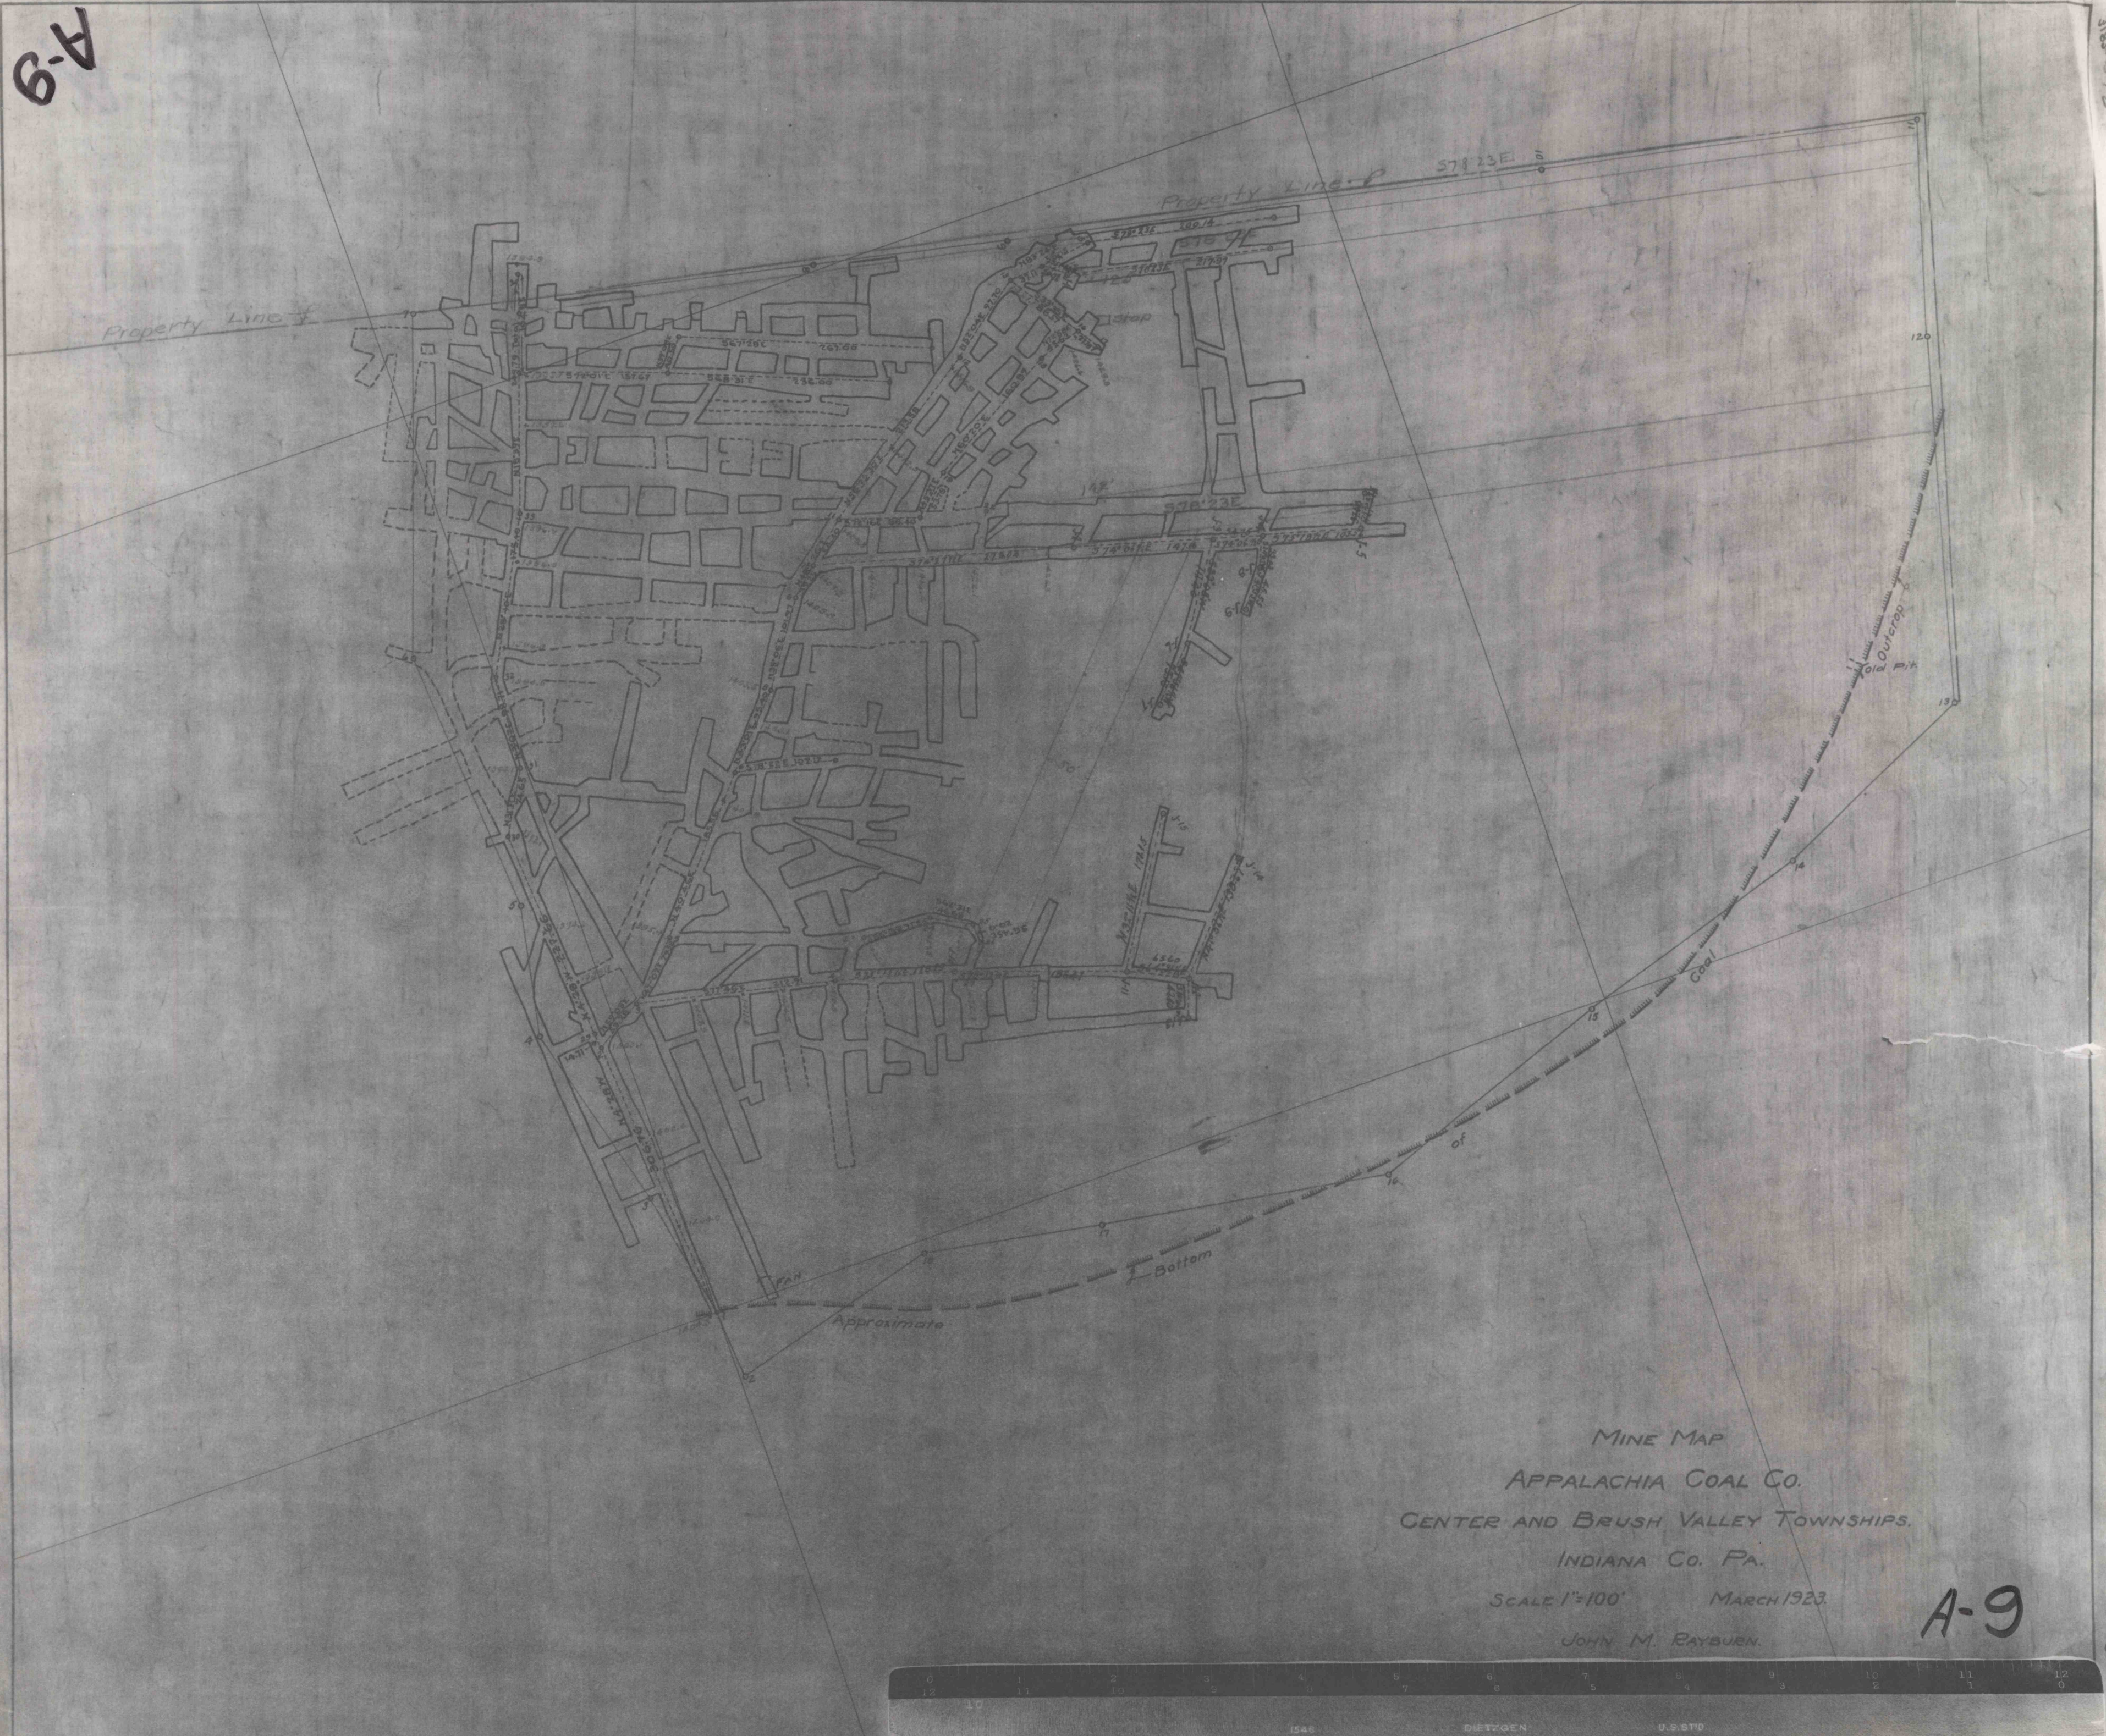

MINE MAP
 APPALACHIA COAL CO.
 CENTER AND BRUSH VALLEY TOWNSHIPS,
 INDIANA CO. PA.
 SCALE 1"=100' MARCH 1923.
 JOHN M. RAYBURN.

A-9