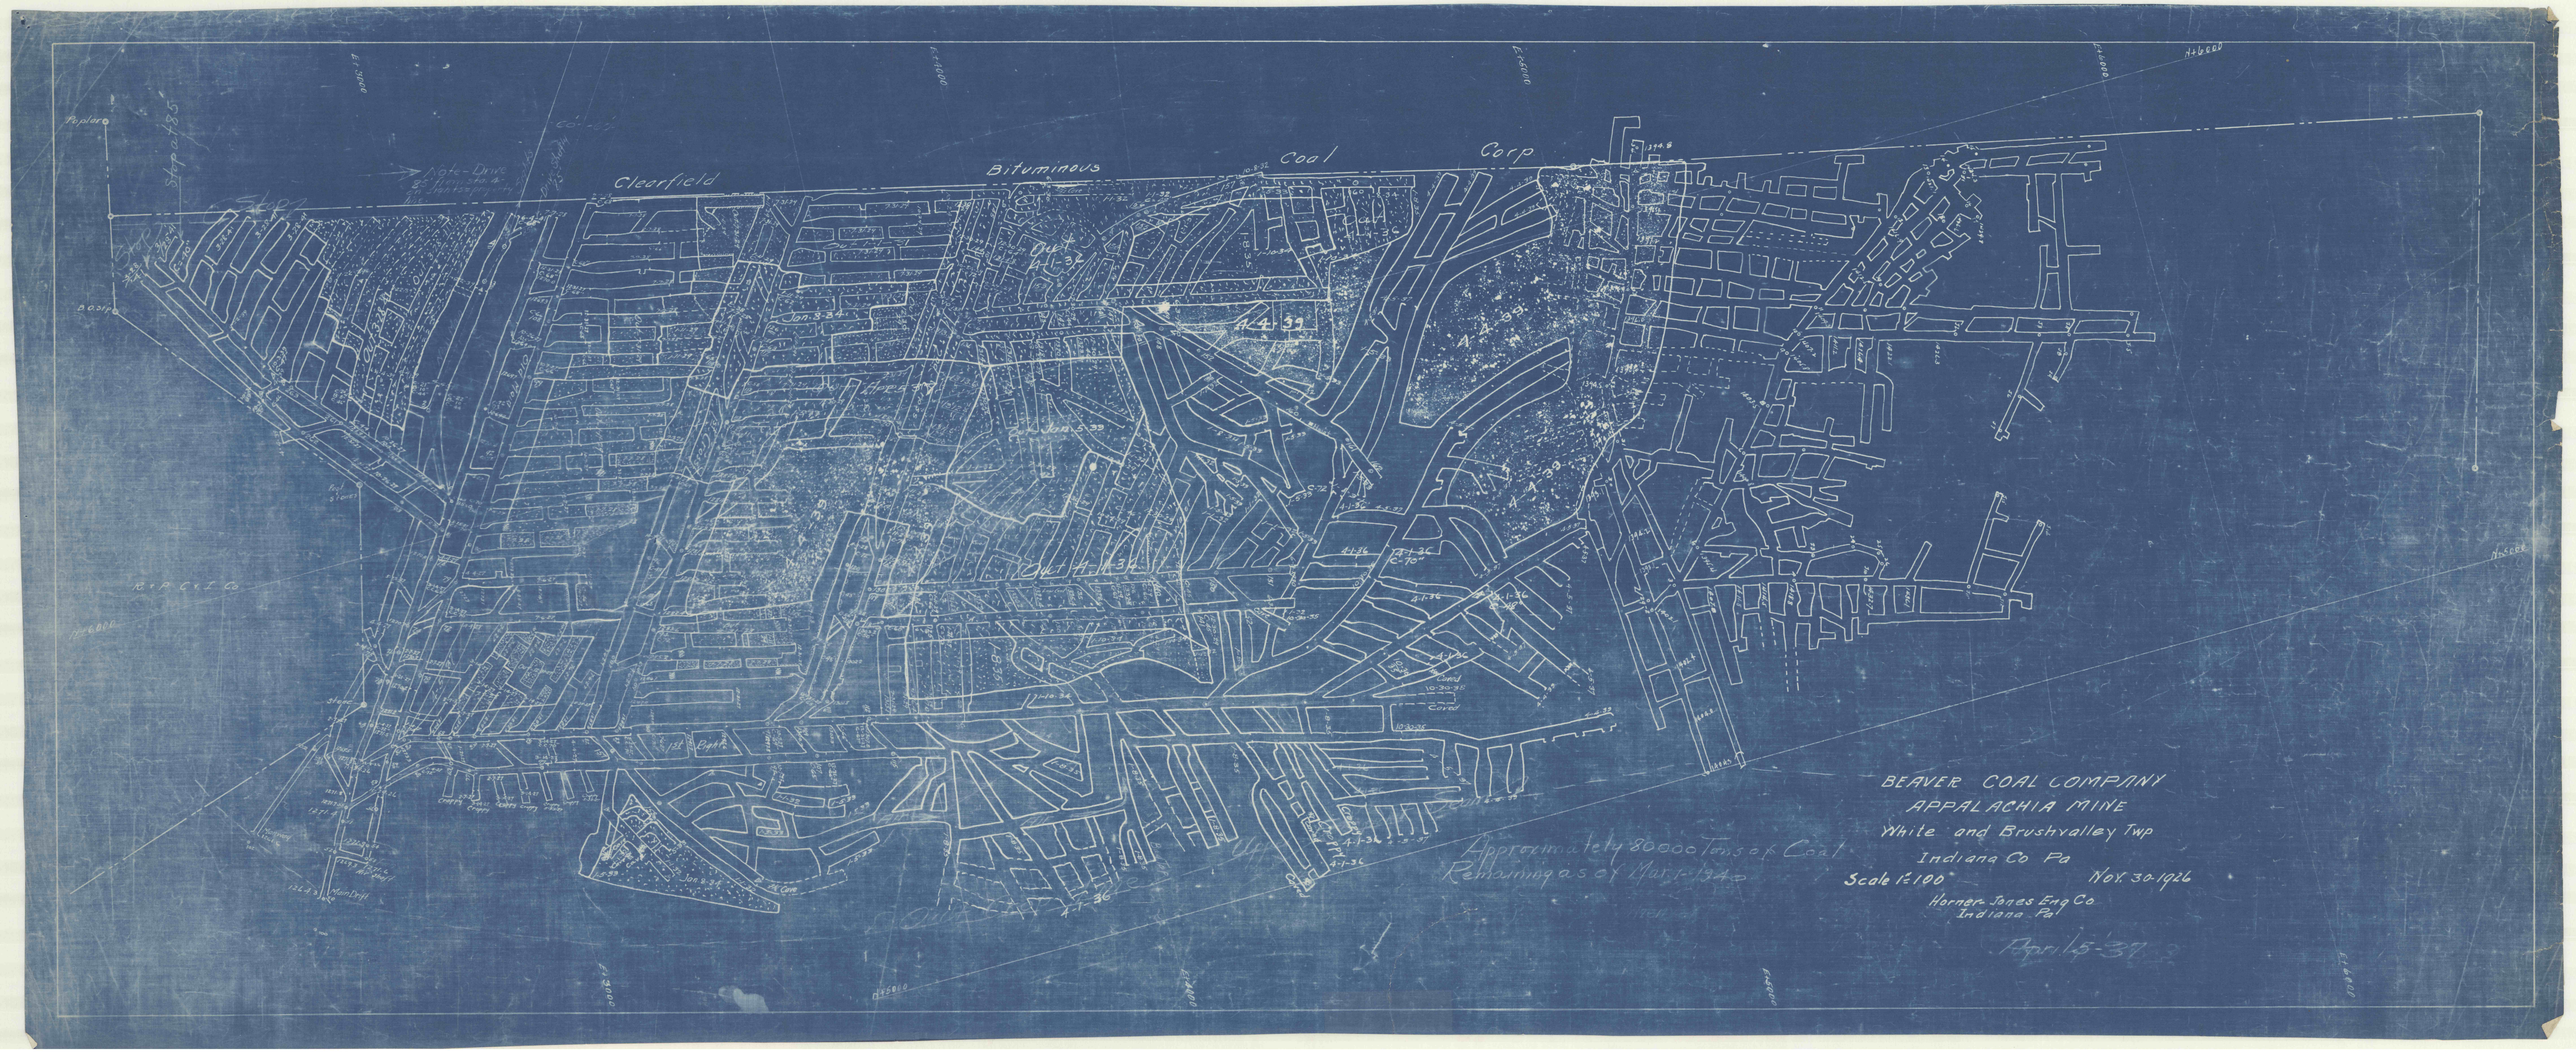
Clearfield Bituminous Coal Corp
BEAVER COAL COMPANY
APPALACHIA MINE
White and Brushvalley Twp
Indiana Co Pa
Scale 1"=100'
Nov. 30-1926
Horner-Jones Eng Co
Indiana Pa
April 5-37
Approximately 80000 Tons of Coal
Remaining as of Mar 1-1940
R & P C & I Co
Poplar
Main Drift
1st Right
Caved
Out
4-1-39
4-1-36
Jan 8-34
Jan 5-39
10-30-35