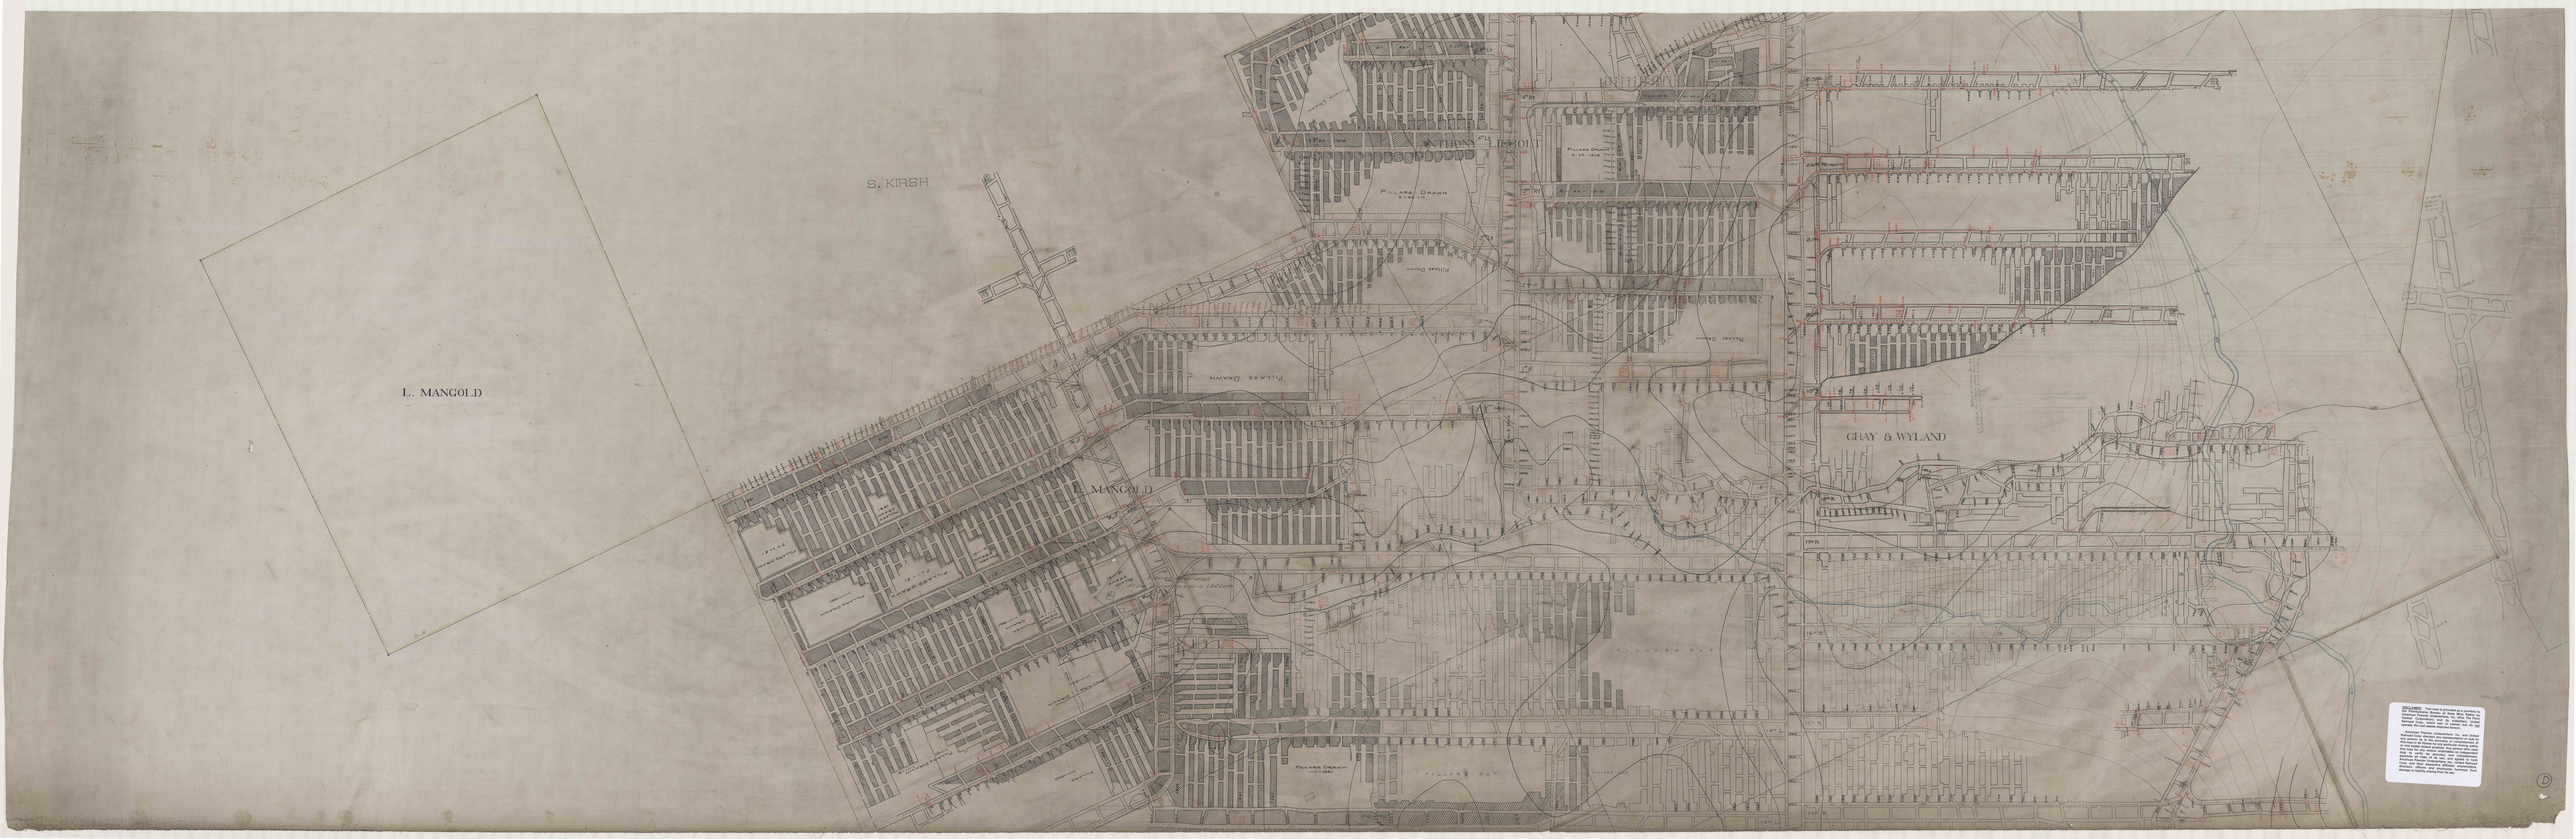
S. KIRSH
L. MANGOLD
L. MANGOLD
ANTHONY LIEBOLT
GRAY & WYLAND
PILLARS DRAWN
PILLARS DRAWN
PILLARS DRAWN
PILLARS DRAWN
PILLARS DRAWN
PILLARS OUT
PILLARS OUT
PILLARS OUT