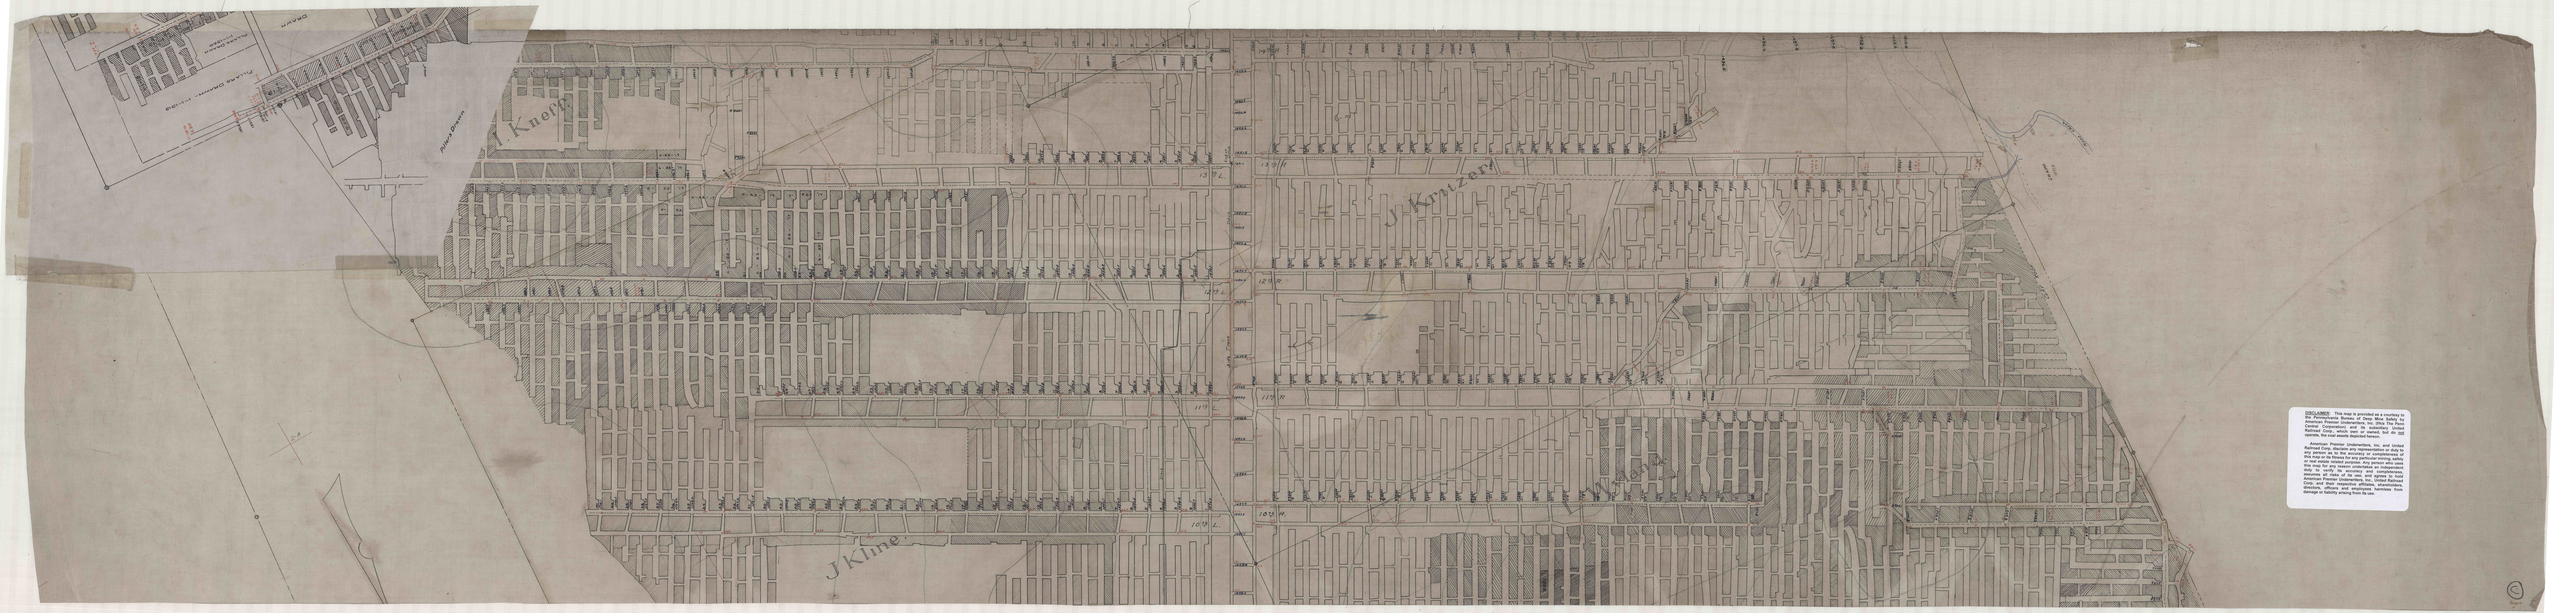


American Premier Underwriters, Inc. and United Railroad Corporation make no representations or warranties of any person as to the accuracy or completeness of this map or its fitness for any particular mining, safety or other purpose. Anyone using this map should verify this map for any reason undertake an independent duty to verify its accuracy and completeness. Anyone using this map hereby agrees to hold American Premier Underwriters, Inc. United Railroad Corp. and their respective affiliates, shareholders, employees and agents harmless from damage or liability arising from its use.