

W.C. MEARS

A.R. KINTER

D. KIRKLAND

C.E. MEARS

LOW COAL OR
FAULTS AREA

4.35 AC. MINED OUT
OR LOST

269 AC. MINED
12,672 TONS
Pitman-Jones


COAL 30"

GAS
WELL

200 FT
NO MINING

Mine
Drainage
Pond
Pond
Pond

DISCLAIMER: This map is provided as a courtesy to the Pennsylvania Bureau of Deep Mine Safety by American Premier Underwriters, Inc. (AKA The Penn Central Corporation) and its subsidiary United Railroad Corp., which own or owned, but do not operate, the coal assets depicted herein.
American Premier Underwriters, Inc. and United Railroad Corp. disclaim any representation or duty to any person as to the accuracy or completeness of this map or its fitness for any particular mining, safety or real estate related purpose. Any person who uses this map for any reason undertakes an independent duty to verify its accuracy and completeness. American Premier Underwriters, Inc., United Railroad Corp. and their respective affiliates, shareholders, directors, officers and employees are harmless from damage or liability arising from its use.

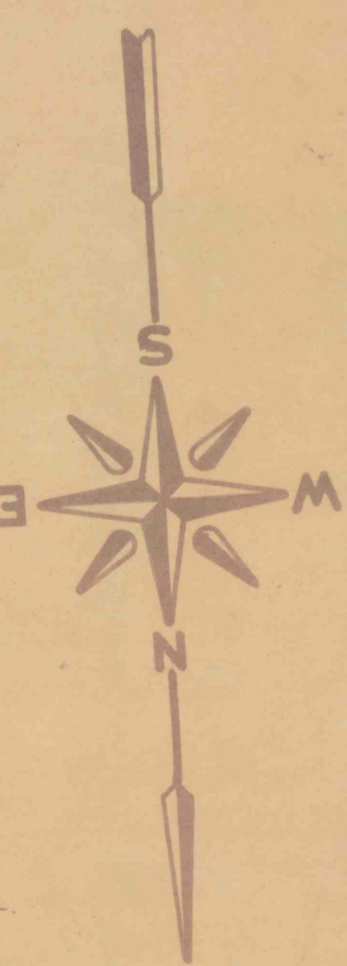

Rec. 2/21/73

Final map D-226