


IMPERIAL KEOKSTONE COAL CO.
PROPERTY OF MINING OPERATIONS
DATE SHOWING
JUNE 1, 1928

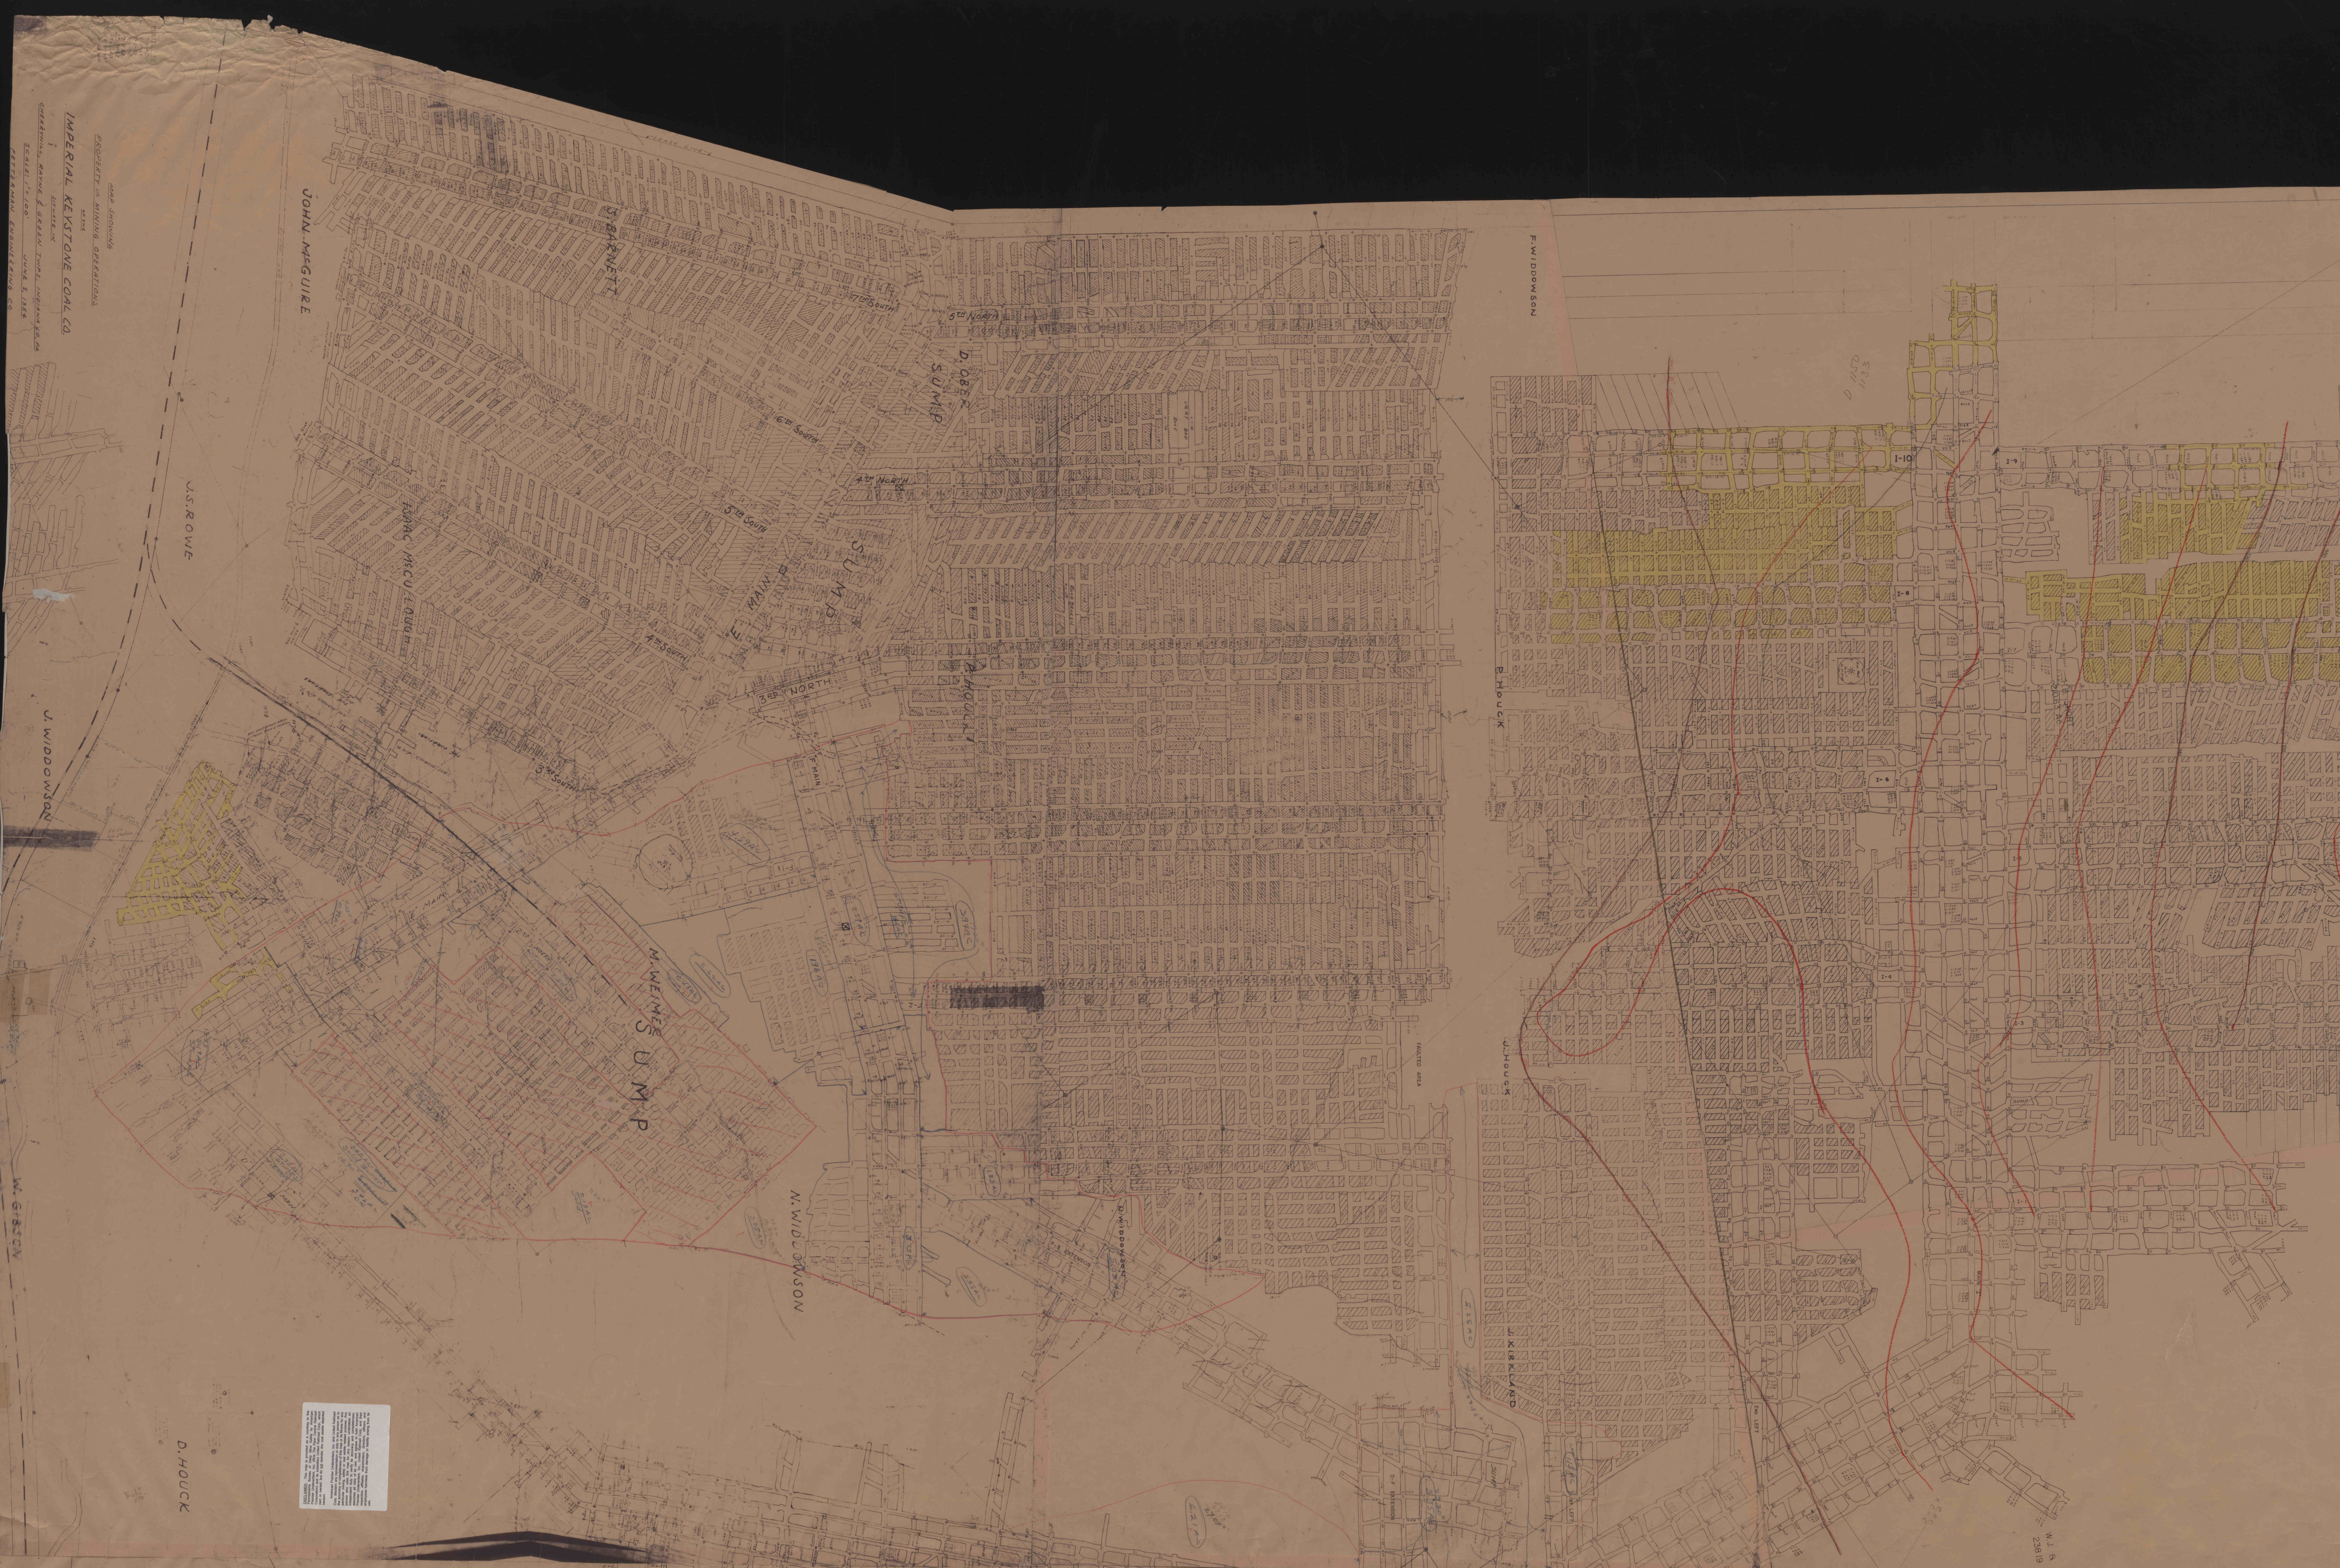


D. HOUCK

N.J. & H.L.S.
23919 AC