


JOHN McGUIRE

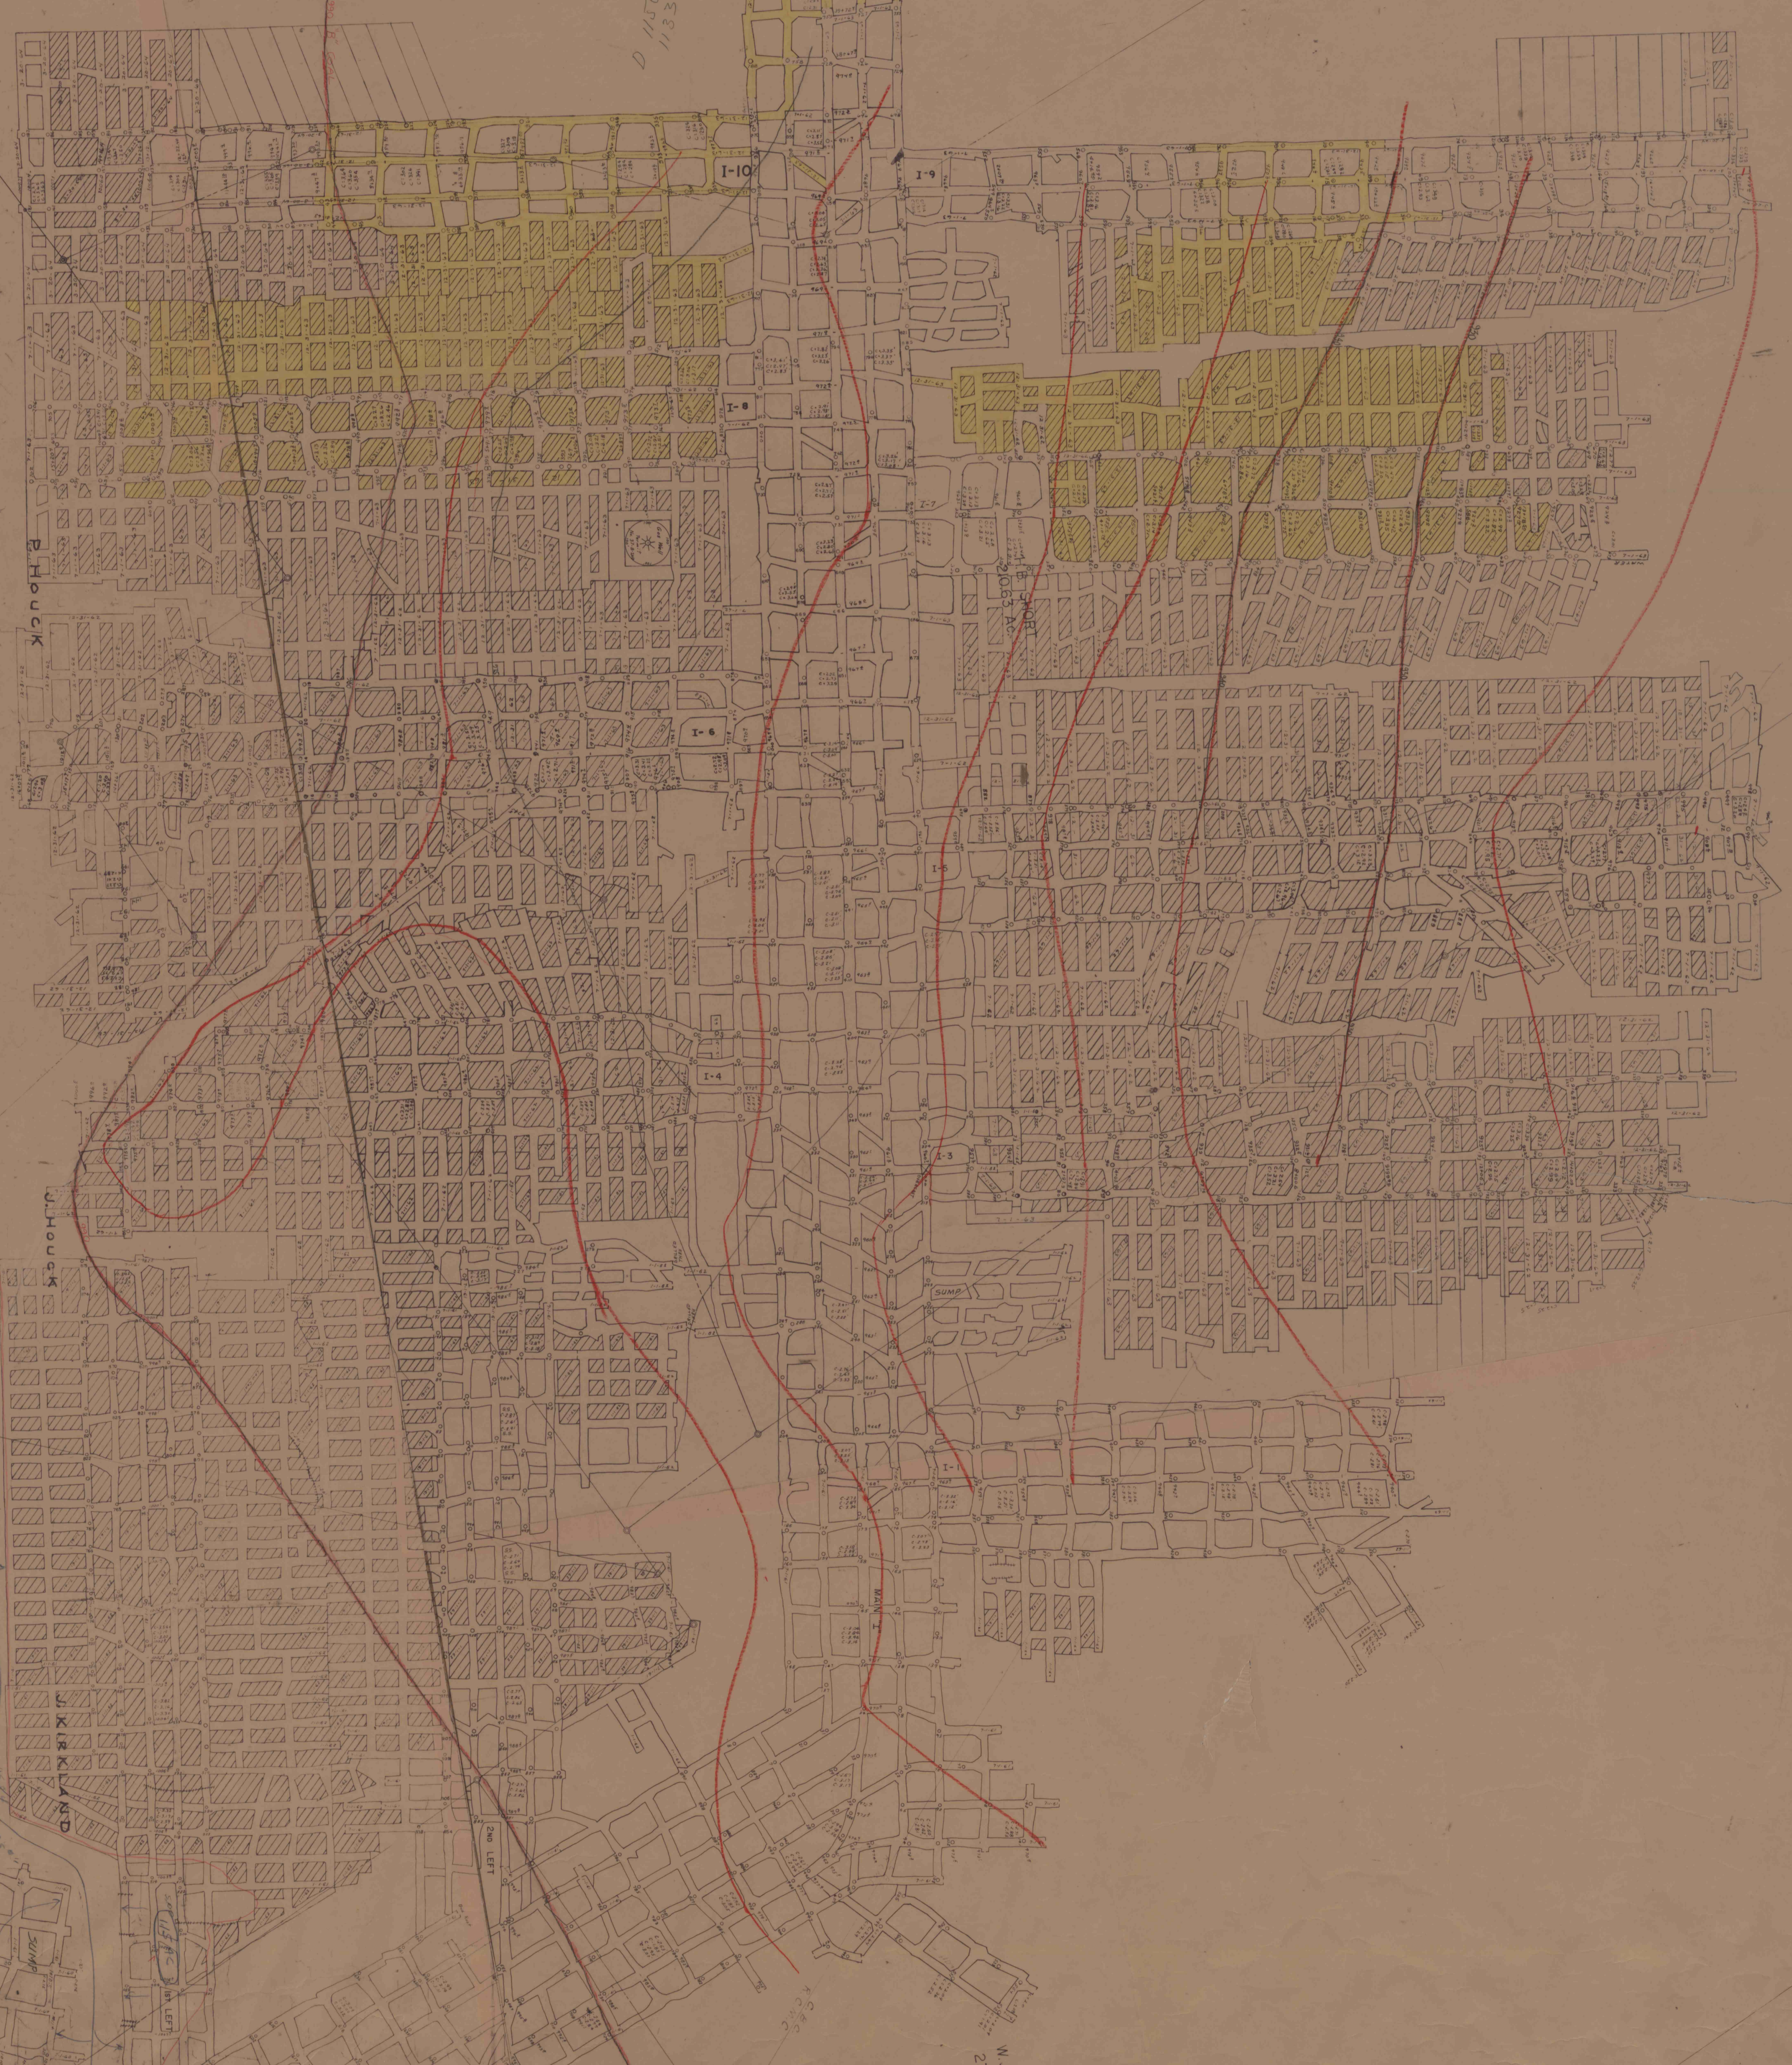

F. W. DOWNSON



5-2-D

JOHN McGUIRE
 F. W. DOWNSON
 M. WENNER
 D. M. P.
 N. W. DOWNSON