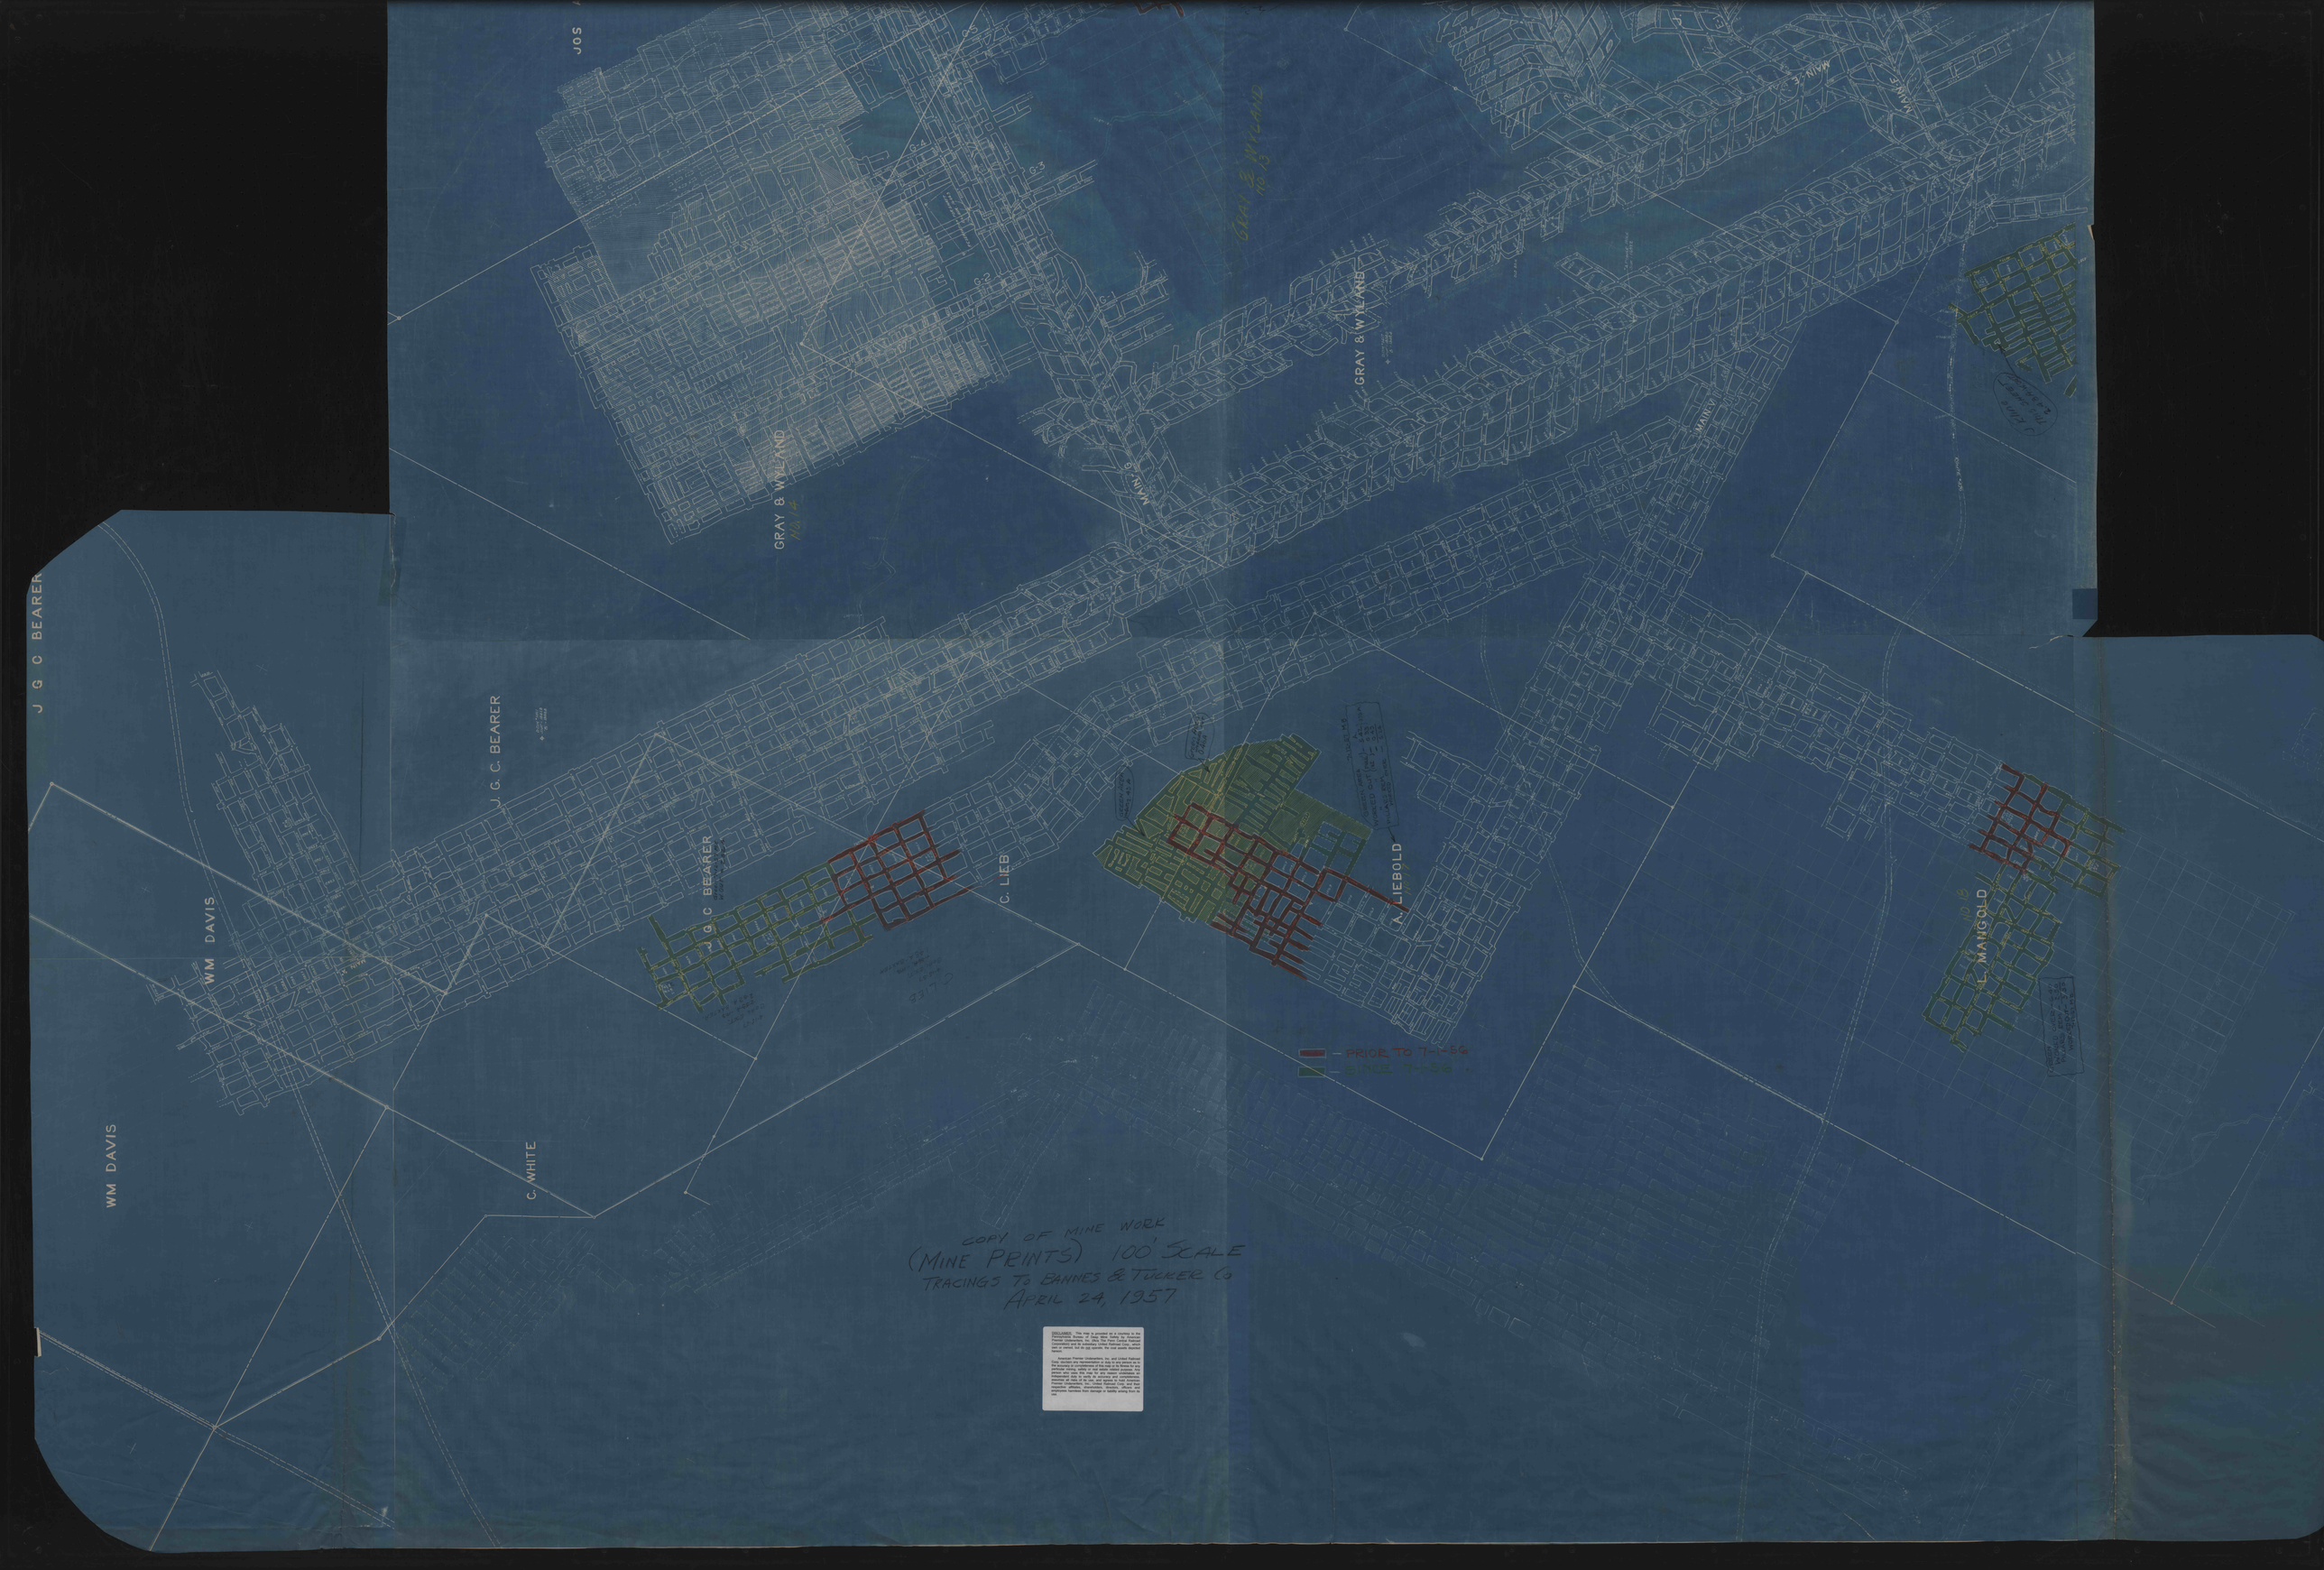
GRAY & WYLAND
GRAY & WYLAND
GRAY & WYLAND
MAIN
MAIN
MAIN
MAIN
J G C BEARER
J G C BEARER
J G C BEARER
J G C BEARER
WM DAVIS
WM DAVIS
C. LIEB
A. LIEBOLD
C. WHITE
L. MANGOLD
— PRIOR TO 11-1-56
— SINCE 11-1-56
COPY OF MINE WORK
(MINE PRINTS) 100' SCALE
TRACINGS TO BARNES & TUCKER CO
APRIL 24, 1957