


DISCLAIMER: This map is provided as a courtesy to the Pennsylvania Bureau of Deep Mine Safety by American Premier Underwriters, Inc. (APU), a subsidiary of American Premier Underwriters, Inc. (APU), which is not a coal operator, but do not operate, the coal assets depicted herein.

American Premier Underwriters, Inc. and United Railroad Corp. disclaim any representation or duty to any person as to the accuracy or completeness of this map or its basis for any person who uses this map for any reason, and disclaims an independent duty to verify its accuracy and completeness, assumes all risks of its use, and agrees to defend, indemnify and hold American Premier Underwriters, Inc. and United Railroad Corp. and their respective affiliates, shareholders, directors, officers and employees harmless from damage or liability arising from its use.

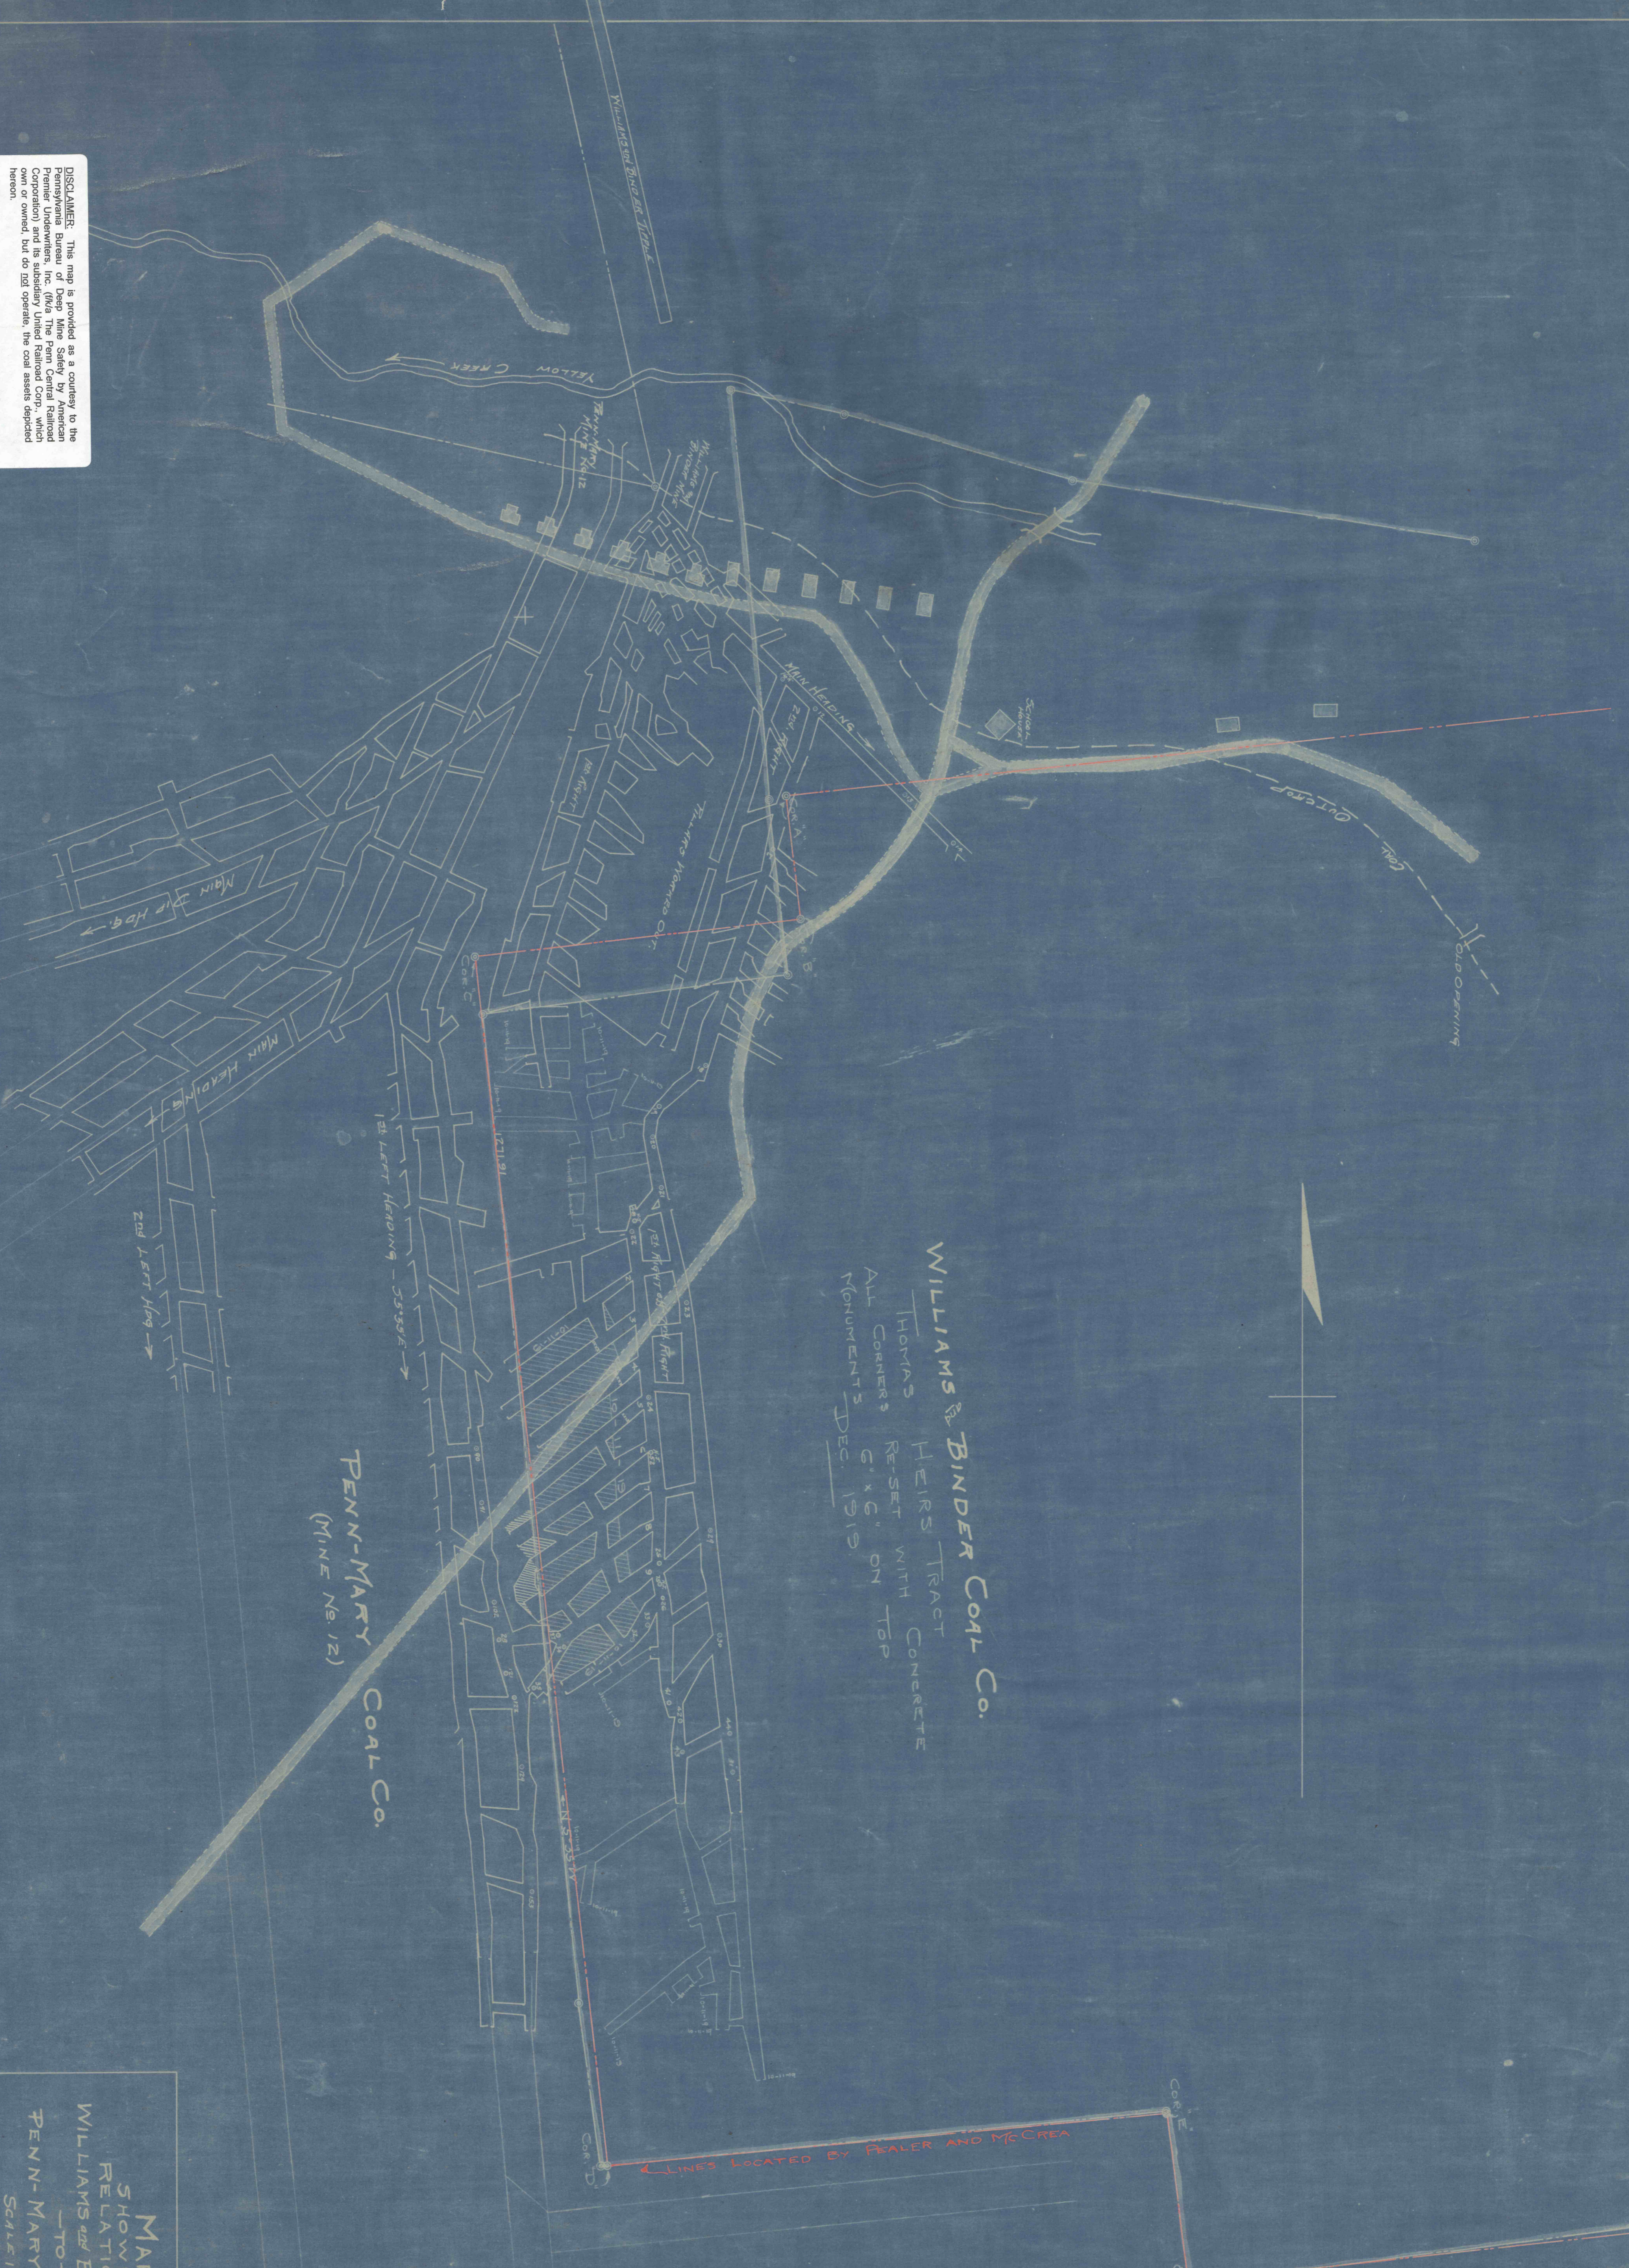

WILLIAMS' BINDER COAL CO.  
 HEIRS TRACT  
 HORNS RESET WITH CONCRETE  
 ALL CORNERS 6" x 6" ON TOP  
 MONUMENTS DEC. 1919

PENN-MARY COAL CO.  
 (MINE No. 12)

← LINES LOCATED BY PEALER AND MCCREA

MAP  
 SHOWING  
 RELATION OF  
 WILLIAMS' BINDER MINE  
 TO  
 PENN-MARY MINE No. 12  
 Scale: 1" = 100'  
 Penn-Mary Coal Co., Eng. Dept.  
 JUN. 15, 1919.  
 EXTENDED - Feb. 28, 1919.

P947-F

P947-F