


C71

DISCLAIMER: This map is provided as a courtesy to the Pennsylvania Bureau of Deep Mine Safety by American Corporation and its subsidiary United Railroad Corp., which own or owned, but do not operate the coal assets depicted herein.

American Premier Underwriters, Inc. and United Railroad Corp. disclaim any representation or duty to any person as to the accuracy or completeness of this map or its fitness for any purpose. This map is provided for any reason, and the user assumes all risks of its use, and agrees to hold American Premier Underwriters, Inc., United Railroad Corp., and its employees harmless from damage or liability arising from its use.

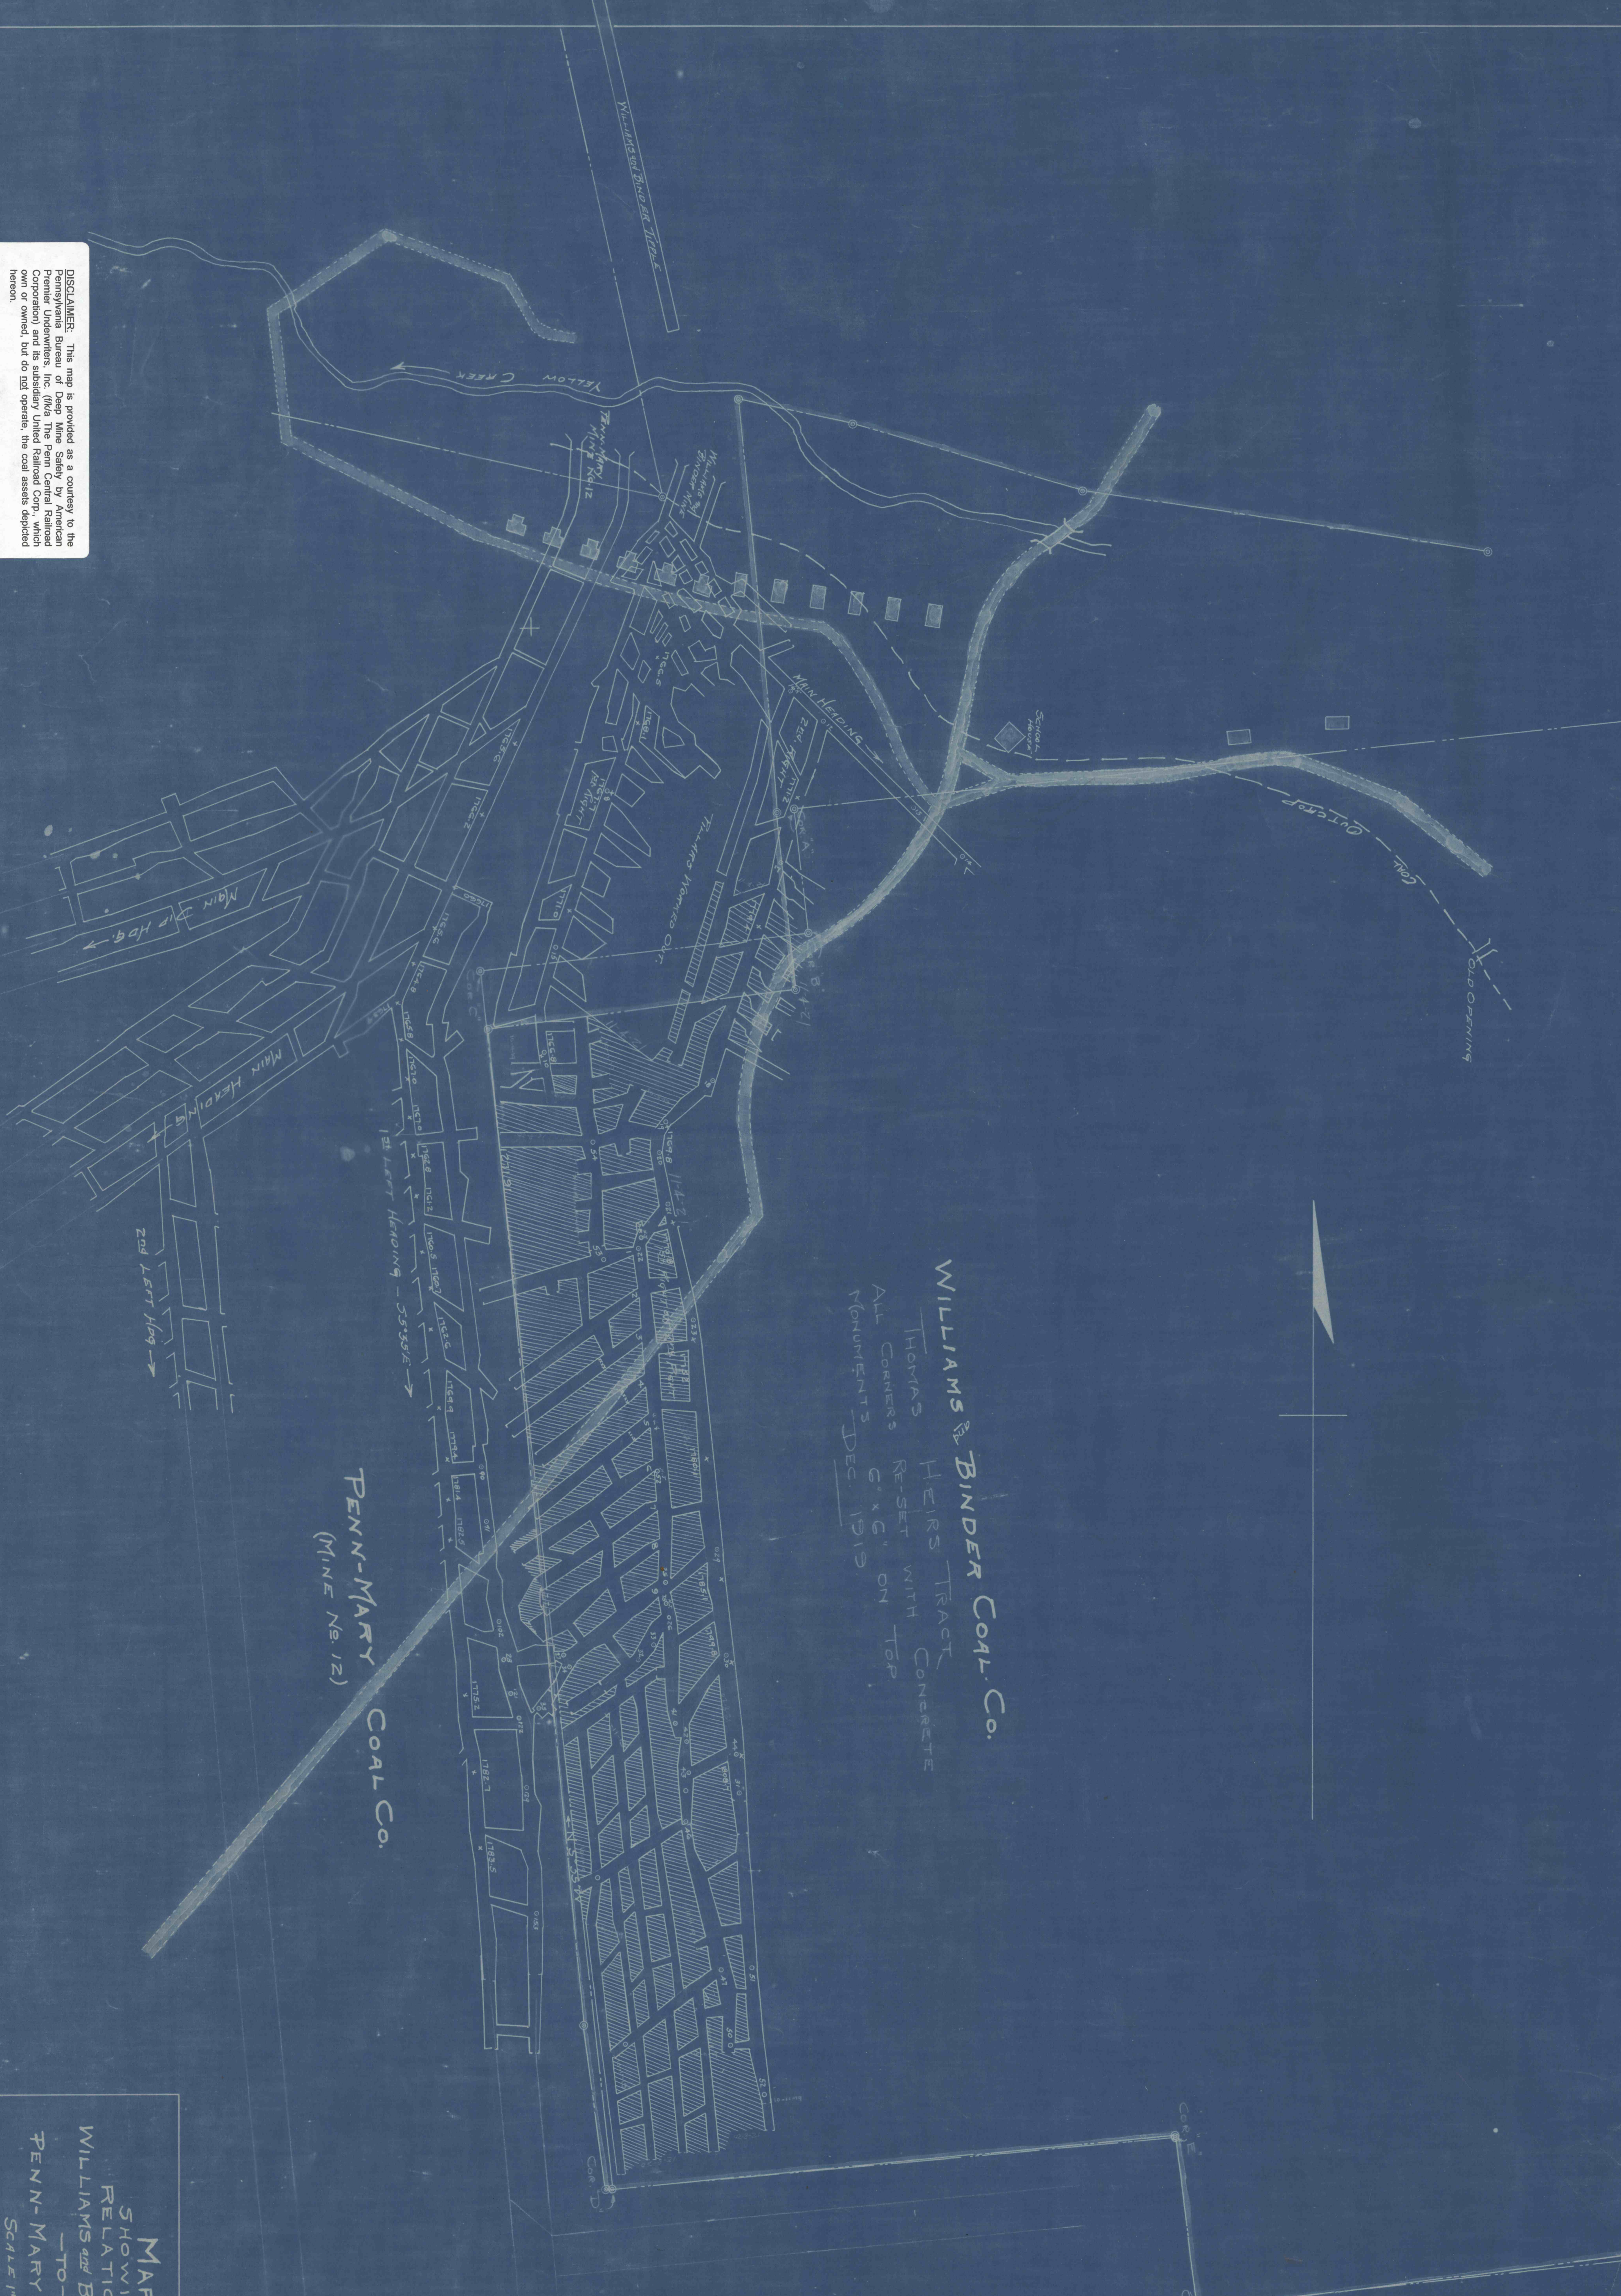

WILLIAMS & BINDER COAL CO.
 HEIRS TRACT
 RE-SET WITH CONCRETE
 ALL CORNERS 6' x 6' ON TOP
 MONUMENTS DEC 1919

PENN-MARY COAL CO.
 (MINE No. 12)

MAP SHOWING RELATION OF WILLIAMS and BINDER MINE TO PENN-MARY MINE No 12
 SCALE 1"=100'
 Penn-Mary Coal Co., Eng. Dept.
 JAN/15-1919
 EXTEND ED - FEB. 28th - 1919

P947-F

P947-F