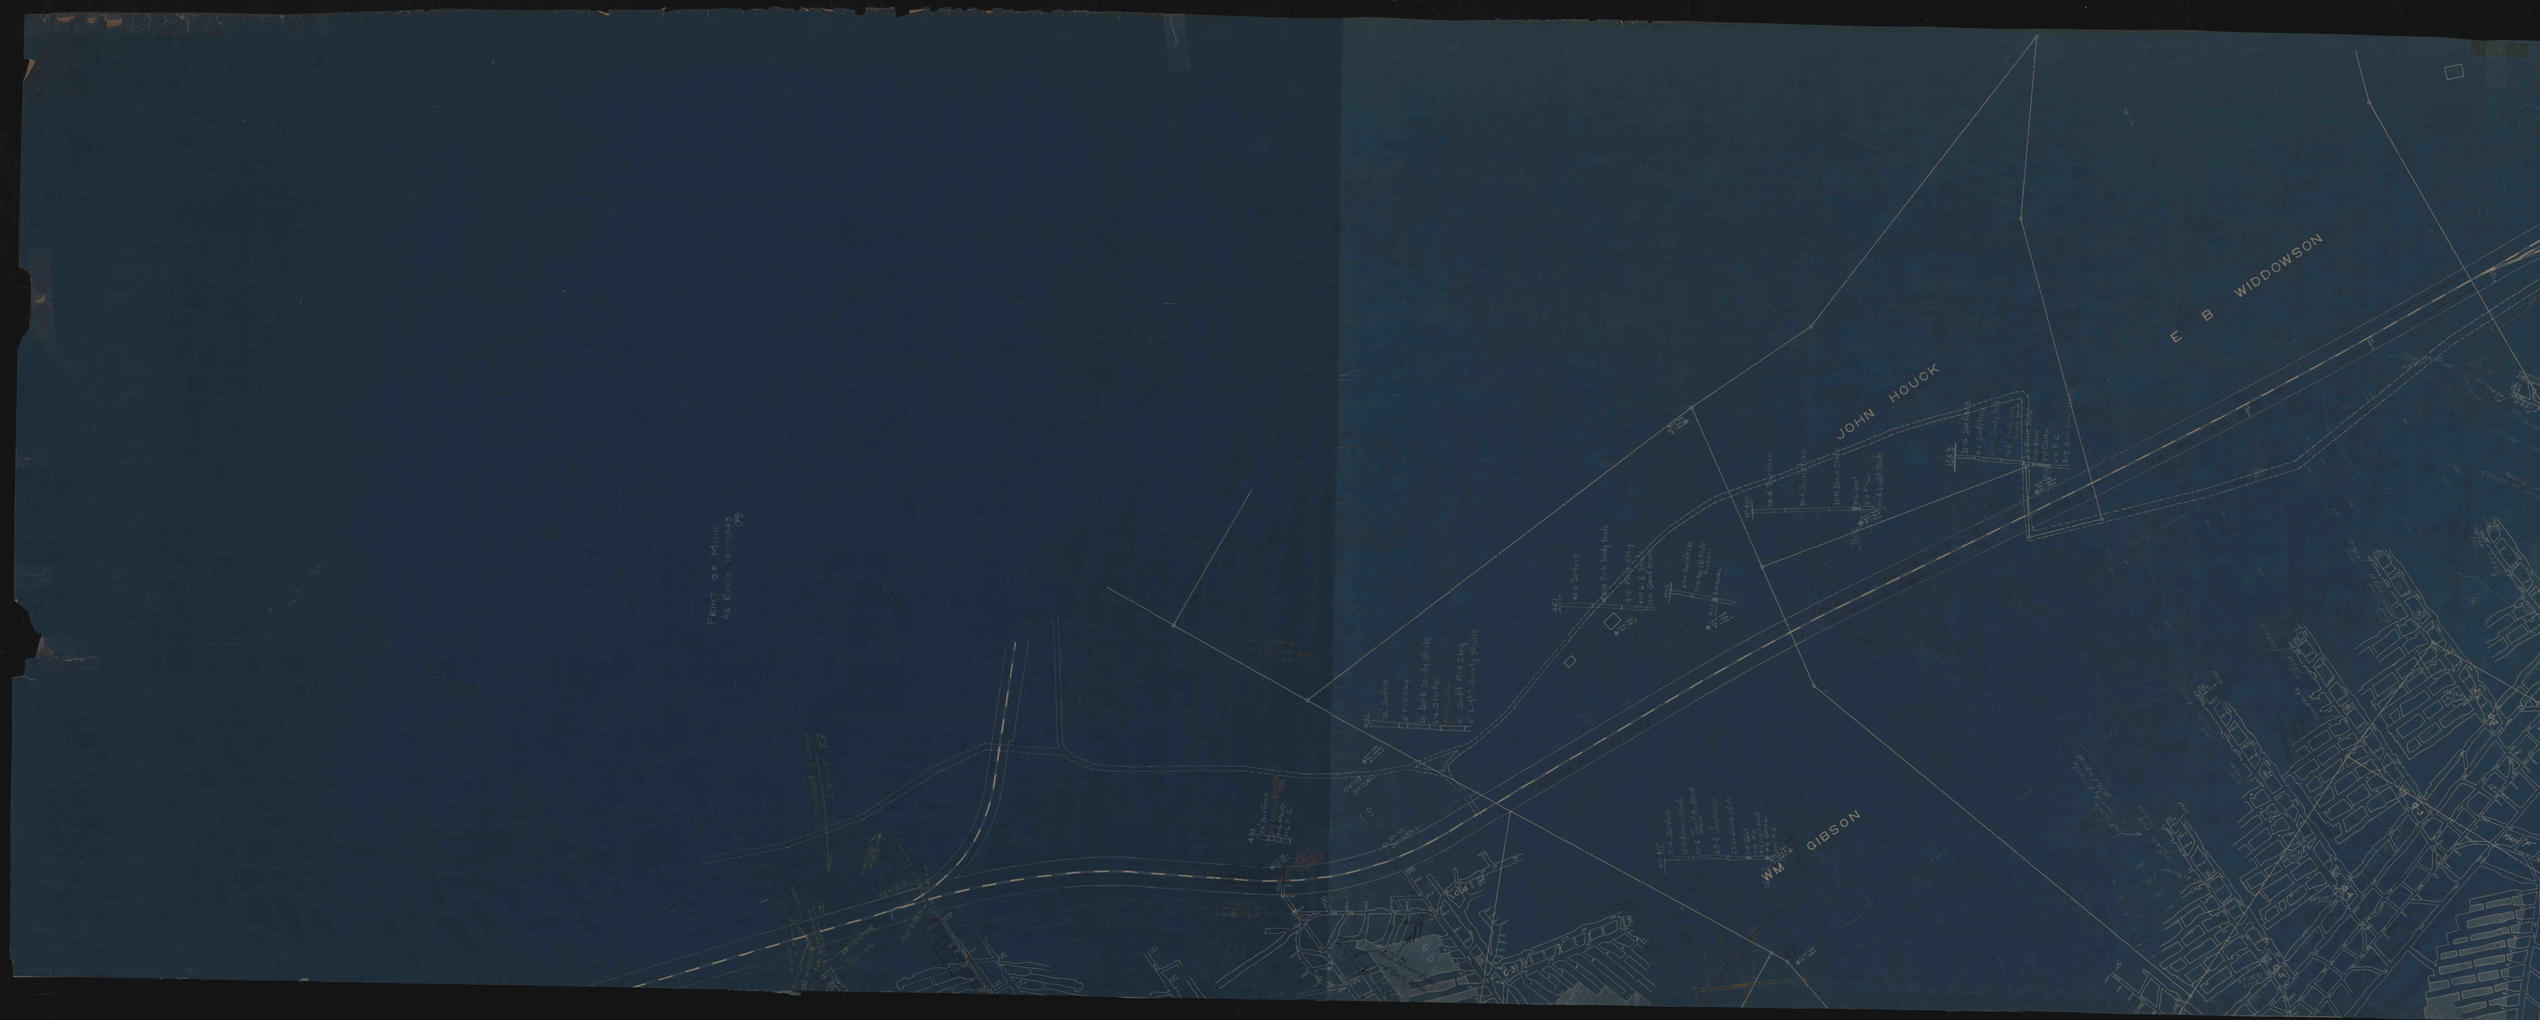
JOHN HOUCK
E B WIDDOWSON
WM GIBSON