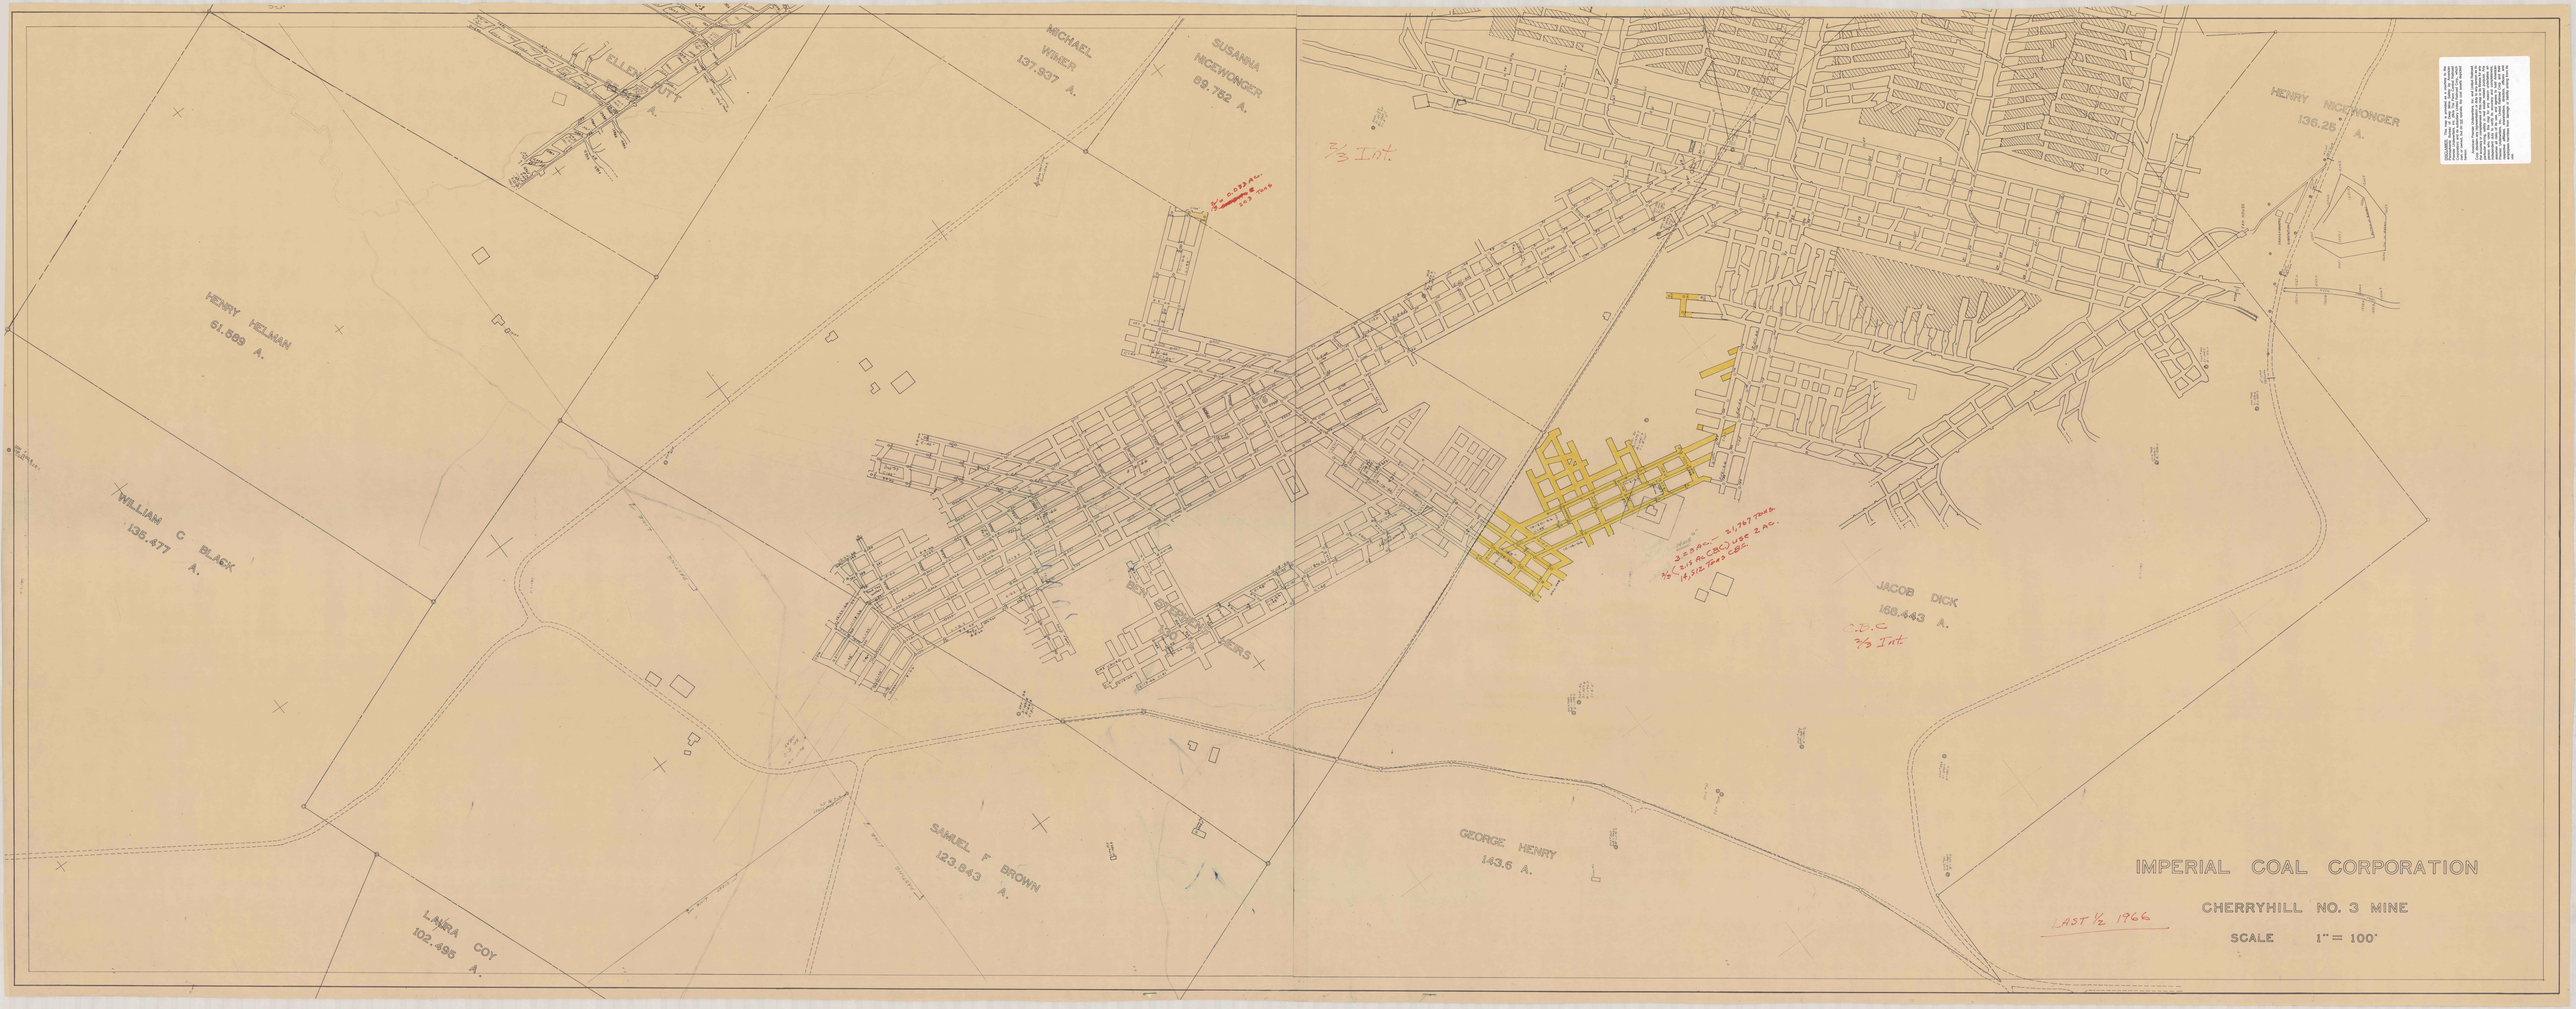
ELLEN
MICHAEL WIMER 137.937 A.
SUSANNA MCEWONGER 89.762 A.
HENRY MCEWONGER 136.25 A.
HENRY HELMAN 61.589 A.
WILLIAM C BLACK 135.477 A.
JACOB DICK 168.643 A.
SAMUEL F BROWN 123.643 A.
GEORGE HENRY 143.6 A.
LAURA COY 102.495 A.
IMPERIAL COAL CORPORATION
CHERRYHILL NO. 3 MINE
SCALE 1" = 100'