



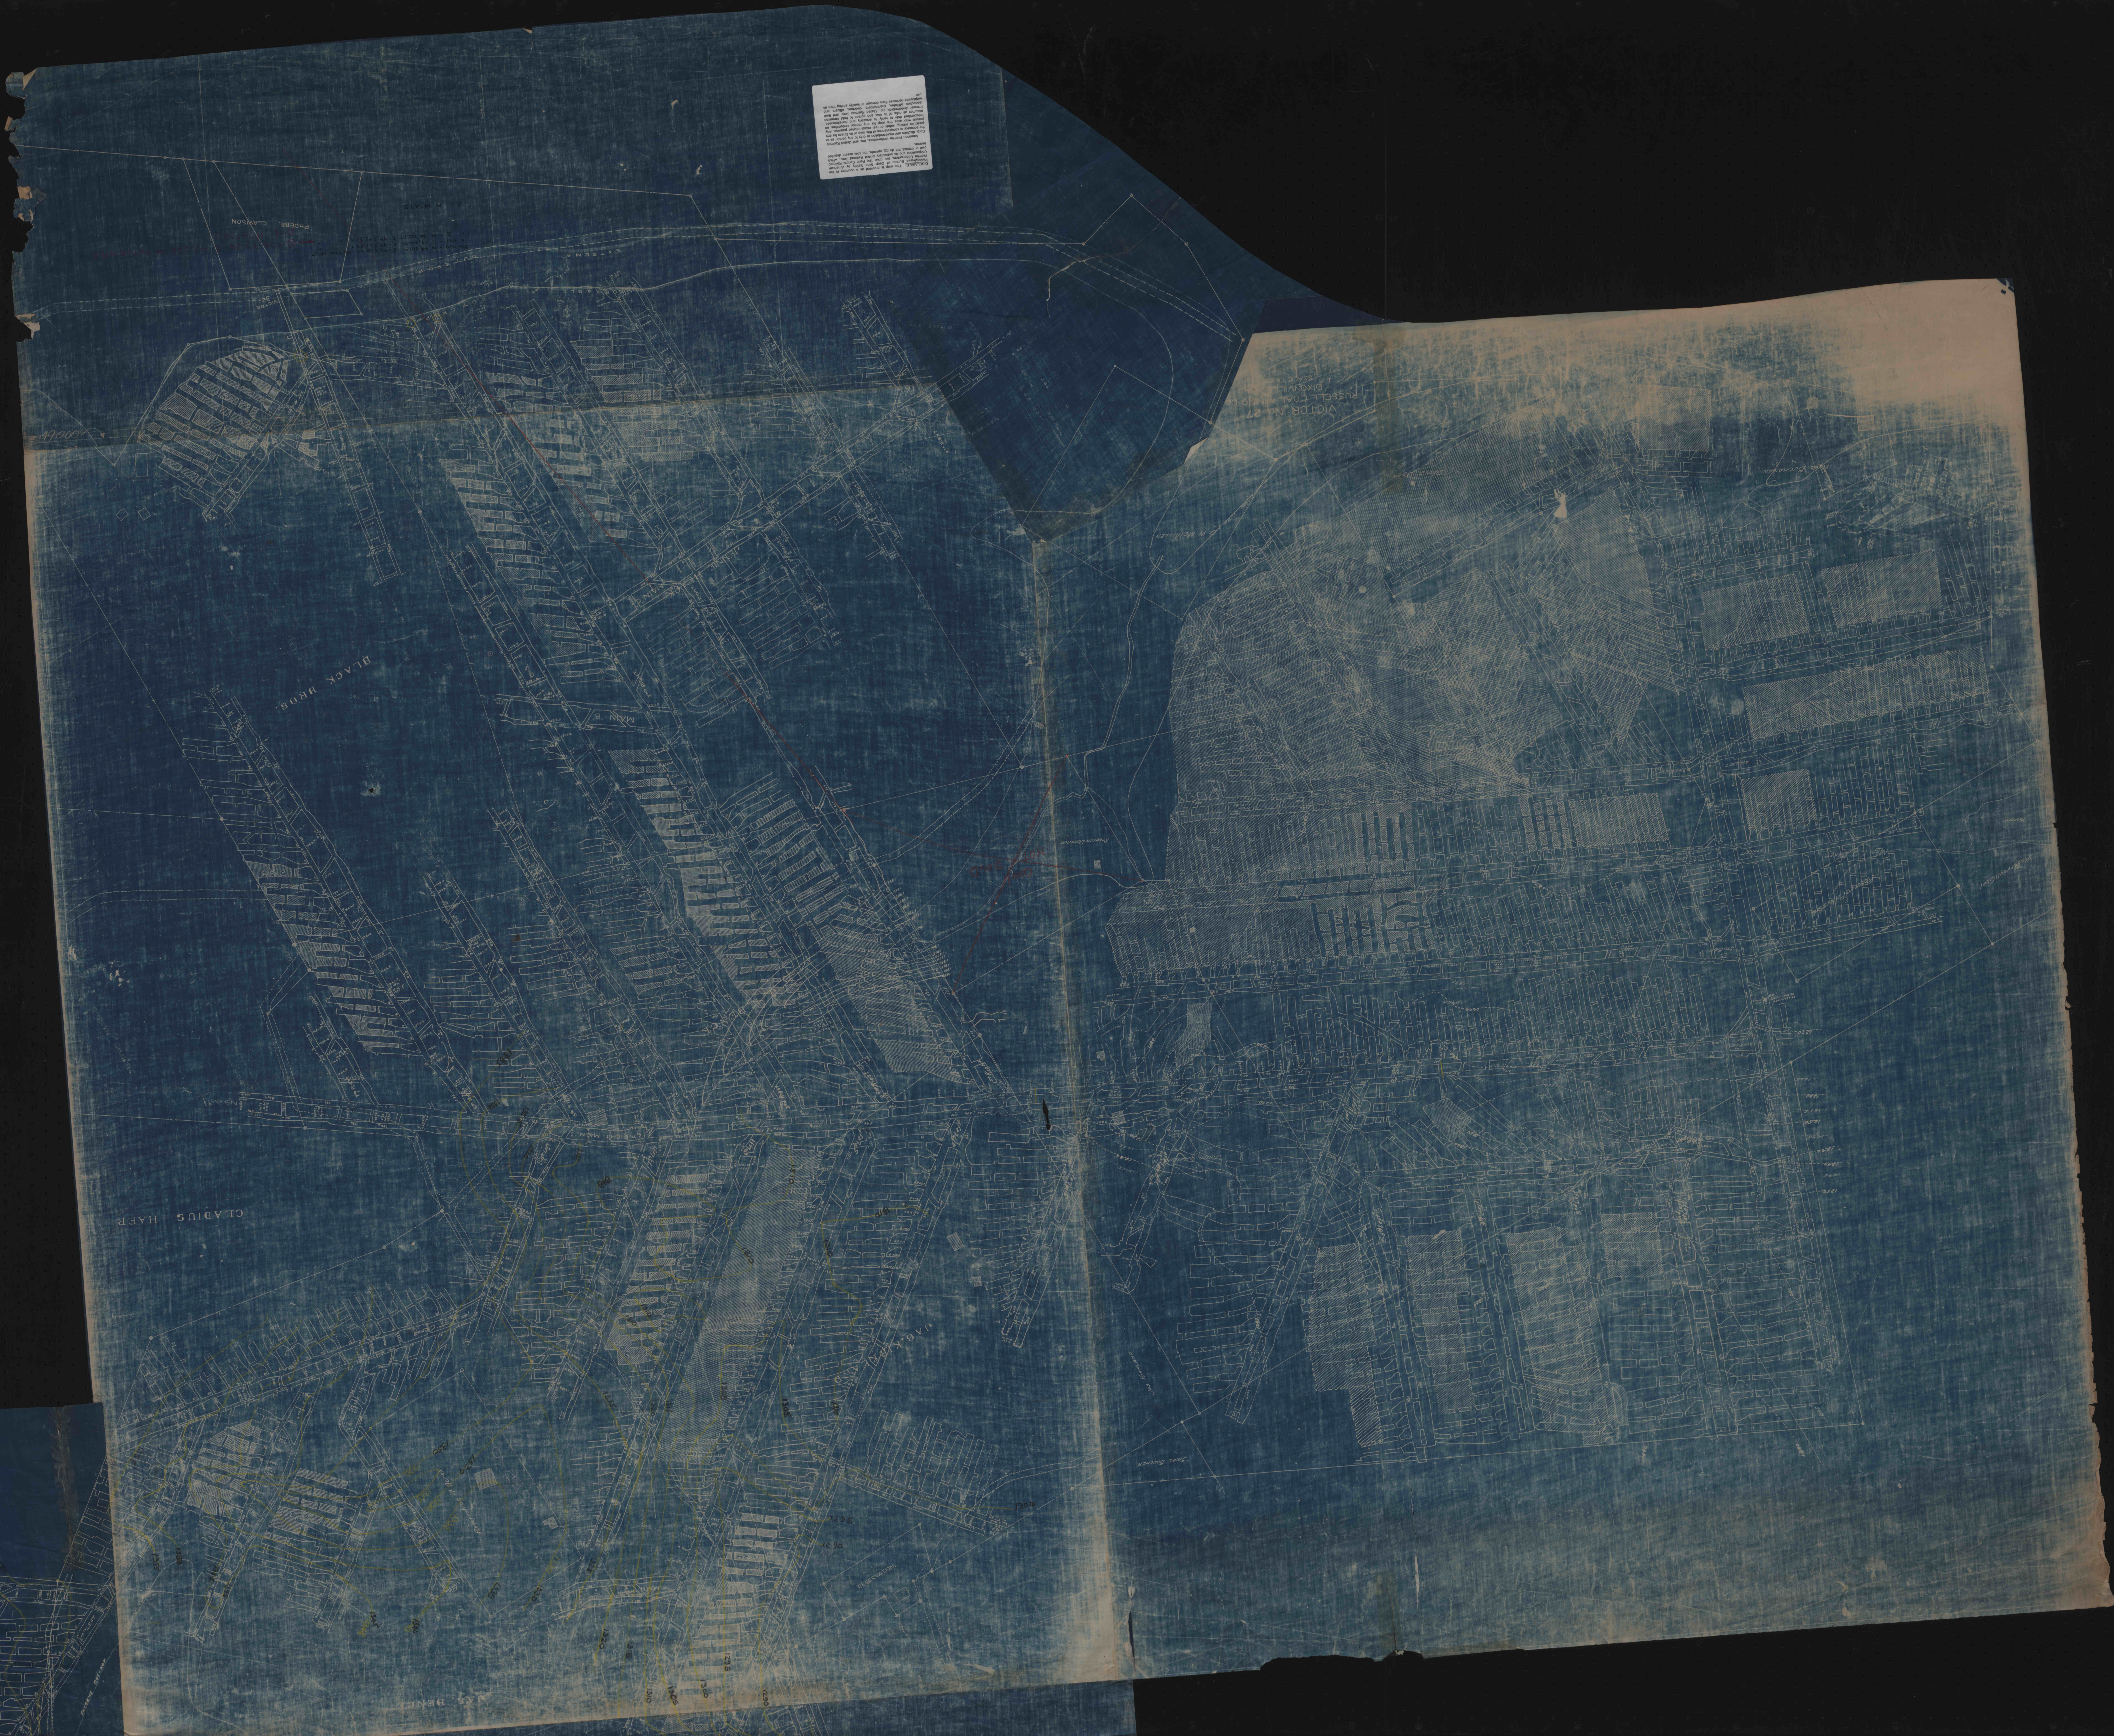

PHOENIX CLAYSON


GLADIUS HAER


W. P. ROWE