


Small white rectangular label with illegible text, possibly a legend or title.

JOS MEARS

SHORT

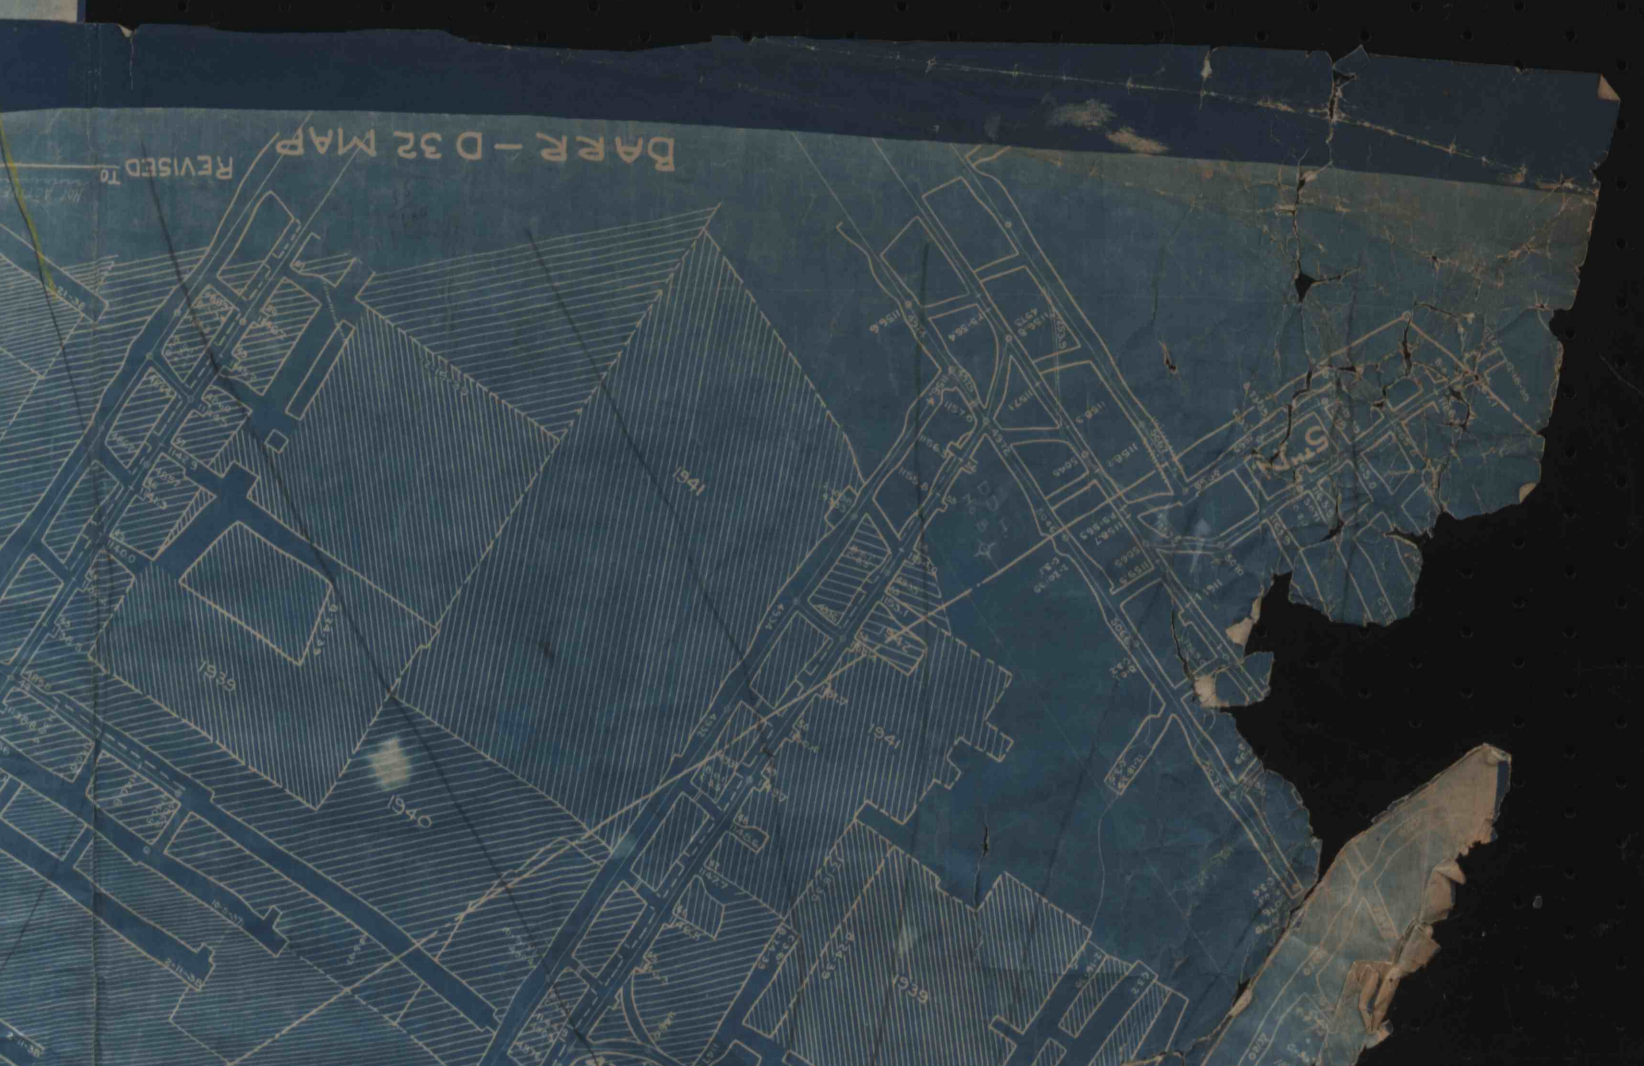

