


L-13

L-14

L-15

L-16

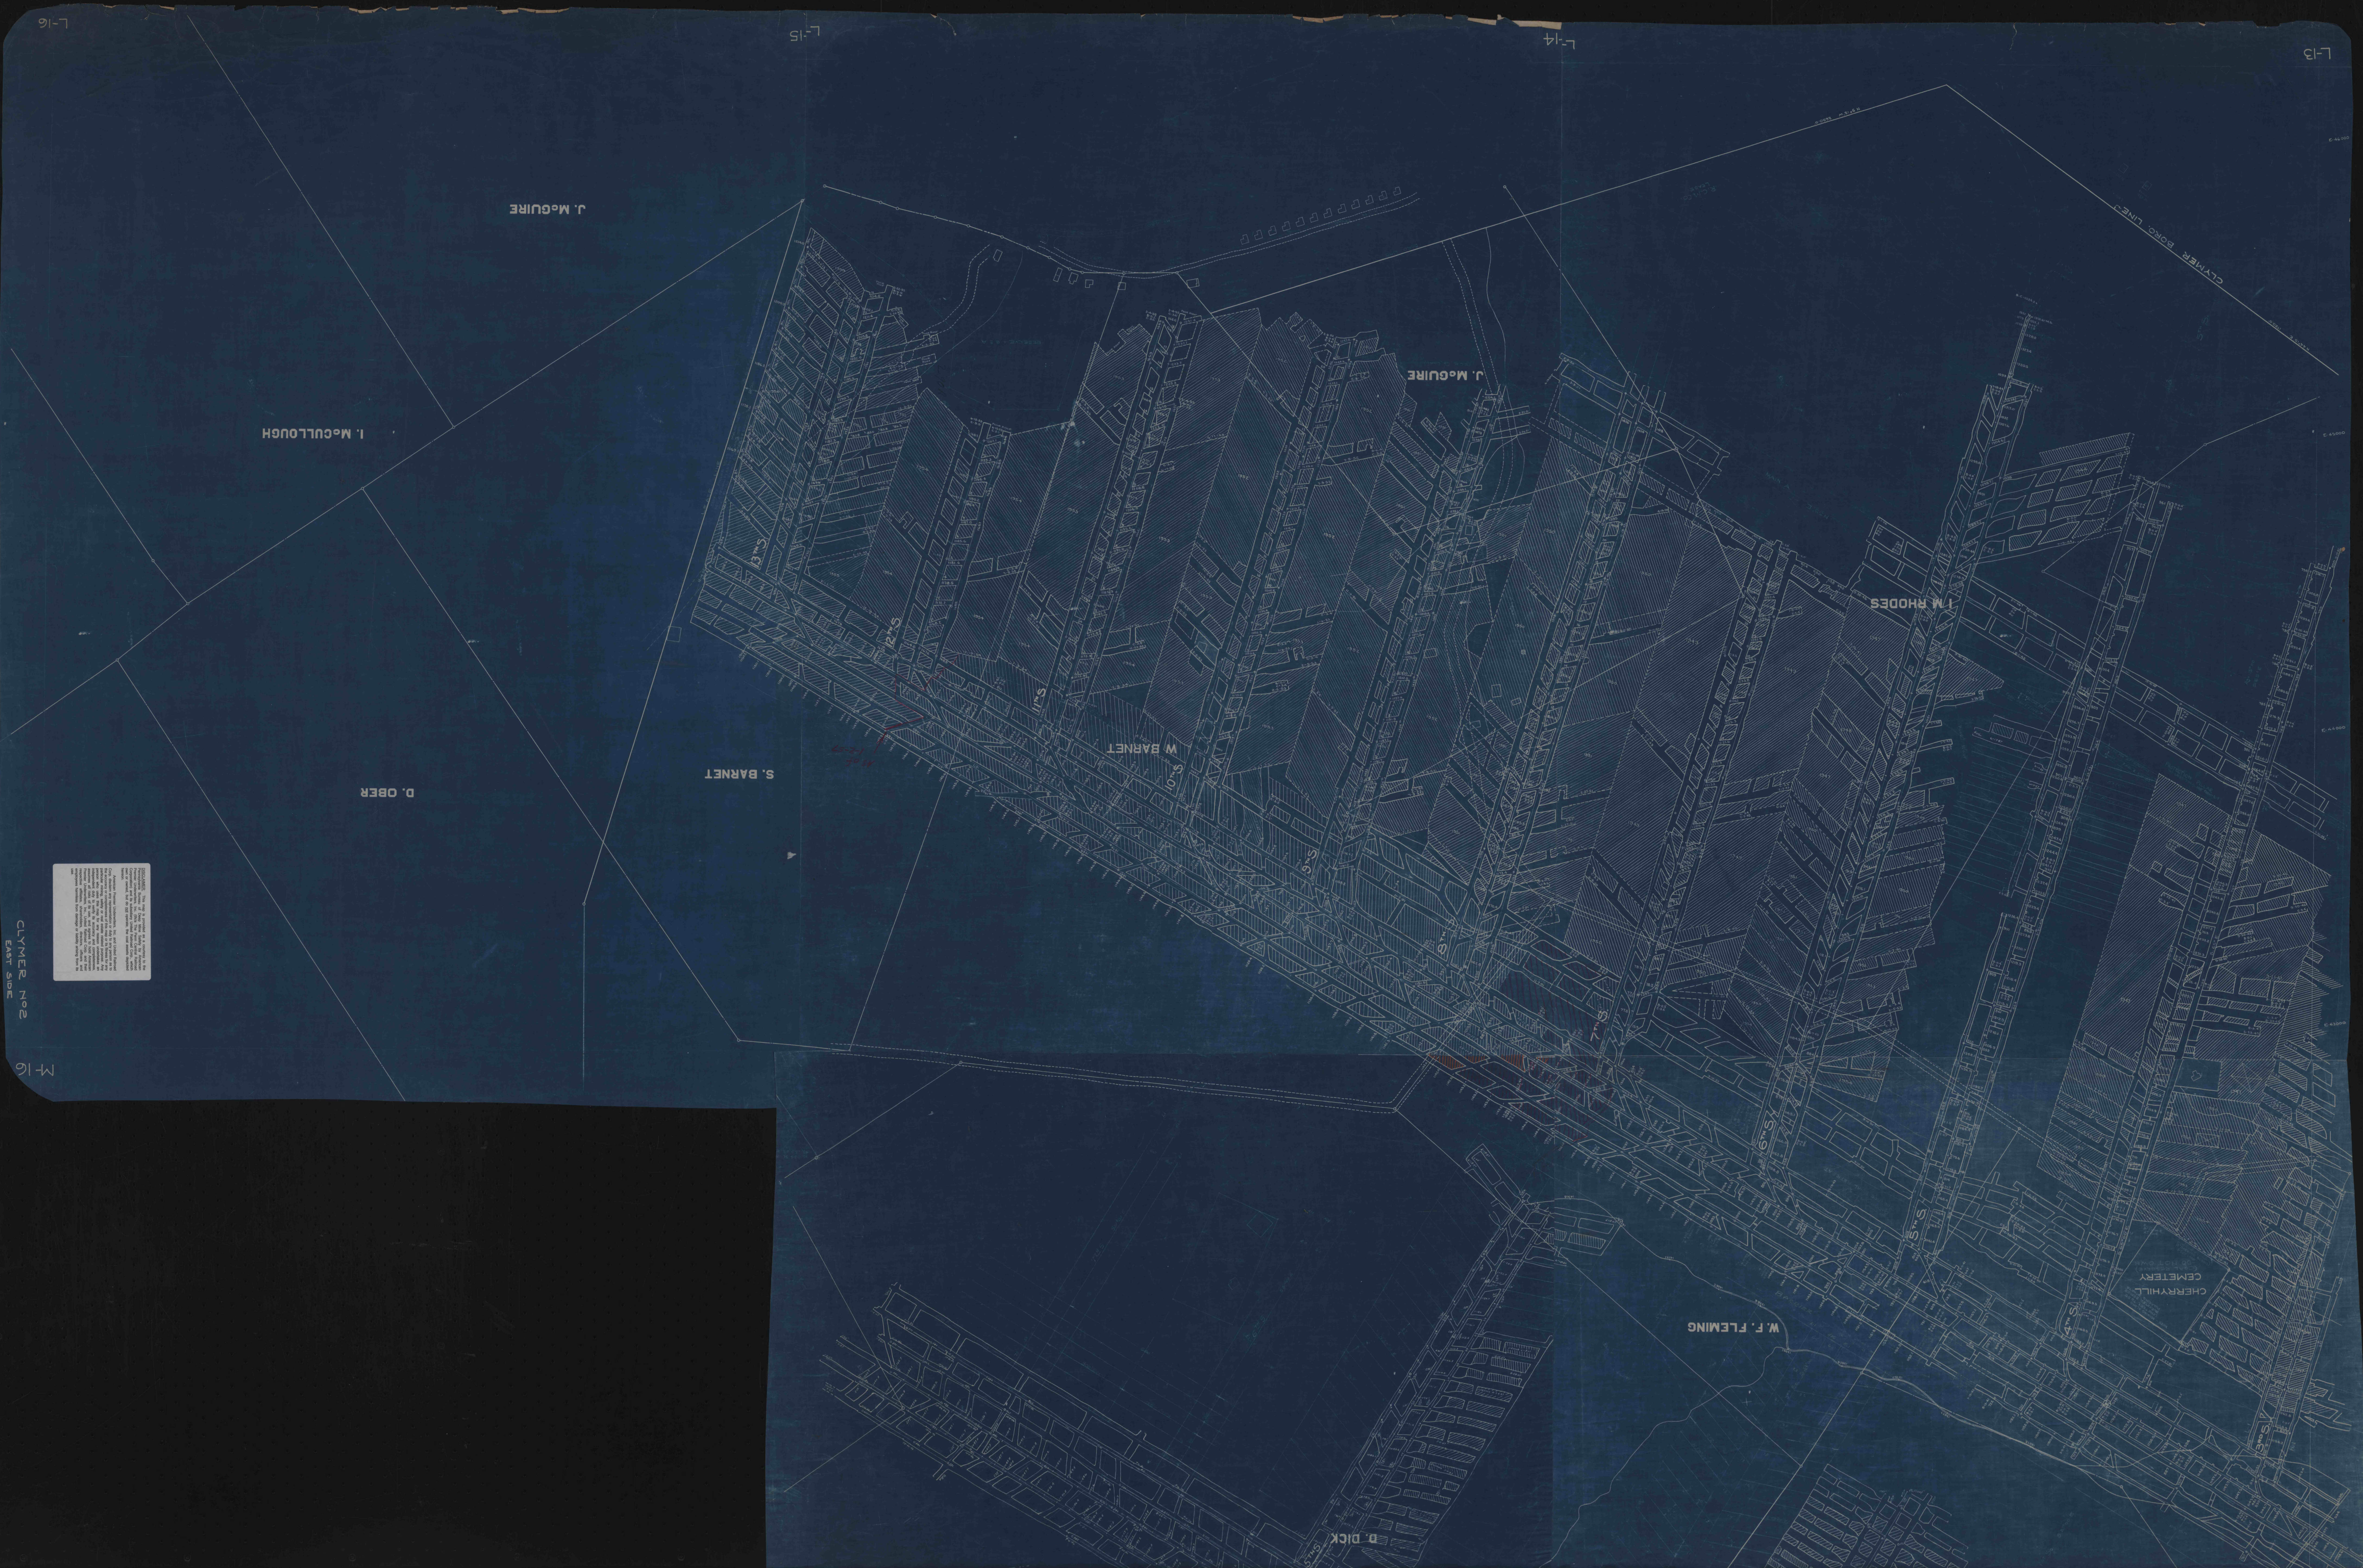

J. MCGUIRE

I. MCGULLOUGH

D. OBER

S. BARNET

W. BARNET

J. MCGUIRE

J. M. RHODES

W. F. FLEMING

CHERRYHILL CEMETERY

D. DICK

CLYMER BORO LINE


CLYMER, No 2
 EAST SIDE

M 16