


104 SOUTH JEWELL

921 SOUTH

2534

175

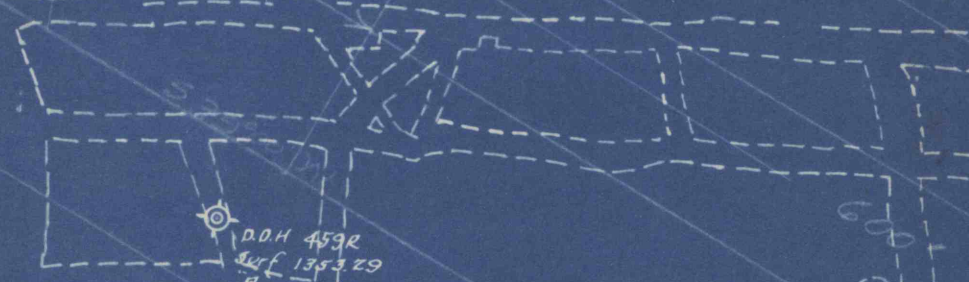

D.D.H. 4592  
B 7053.000

1050

220

EAST

D. OBER

50 BARRETT PLACE

1045


DIVISION LINE 2

1025




1010

1000

990

980

980

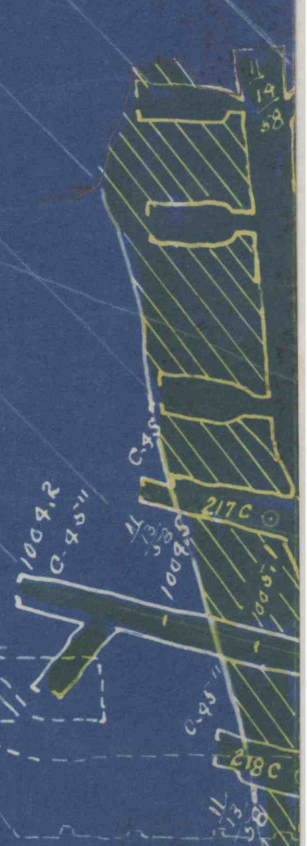


217C

218C

D.D.H. 4458  
Surf. 1222.88  
B 929.58