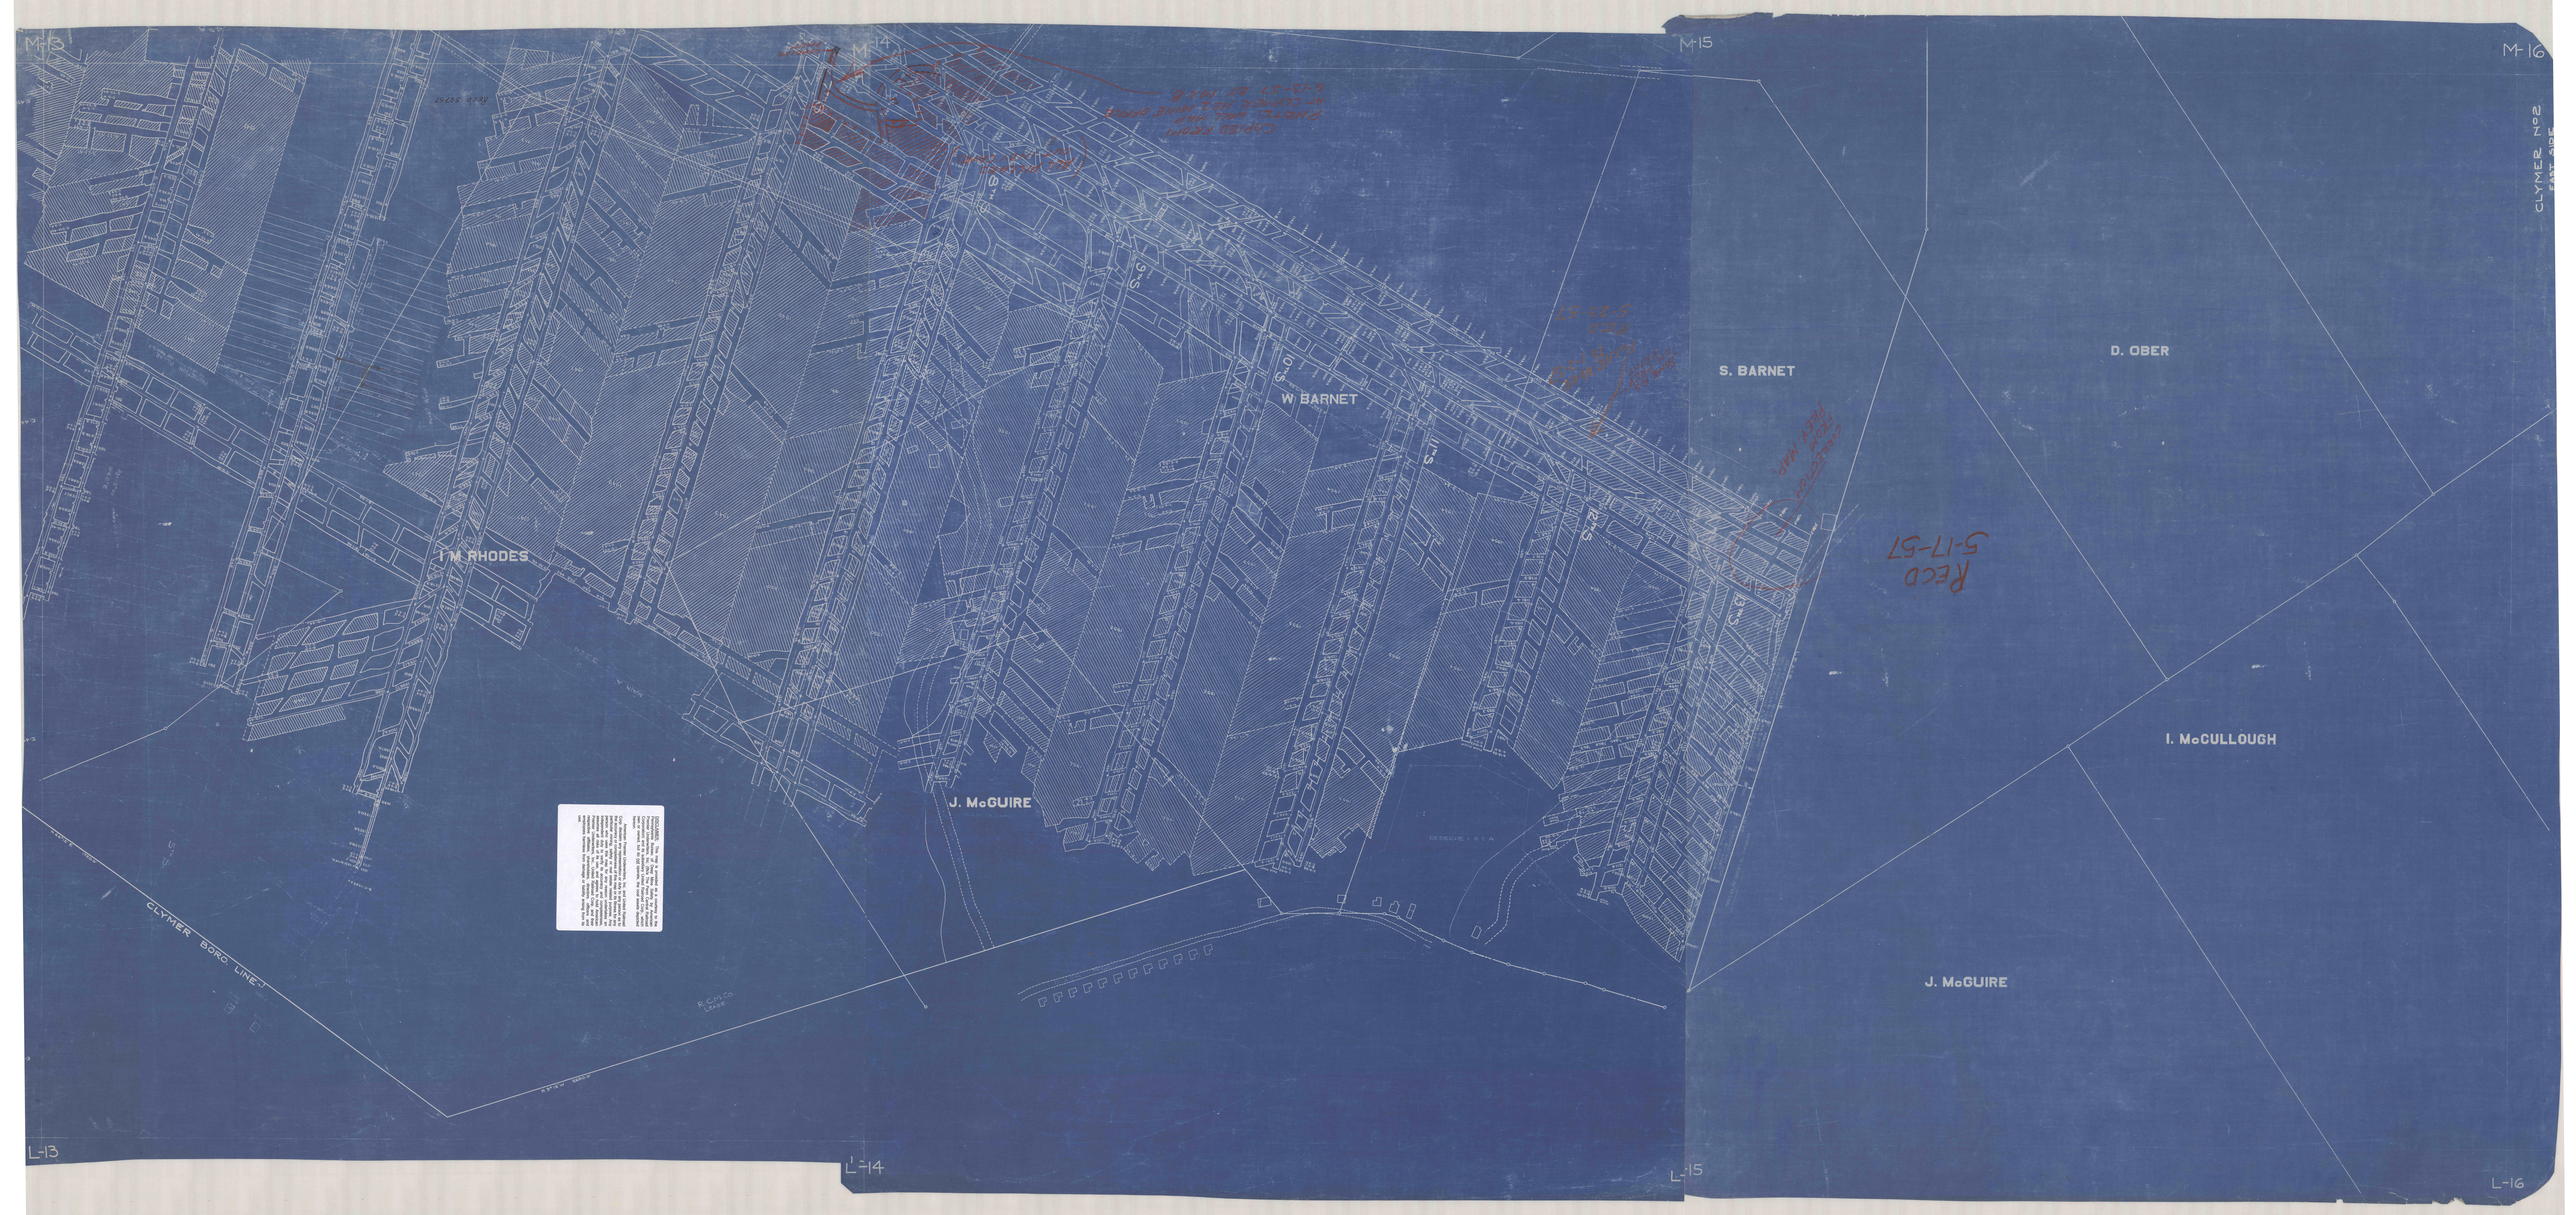
M-13
M-14
M-15
M-16
CLYMER No 2
W. BARNET
S. BARNET
D. OBER
I. M. RHODES
J. McGUIRE
I. McCULLOUGH
J. McGUIRE
CLYMER BORO LINE
L-13
L-14
L-15
L-16
RECD
5-17-57