


DISCLAIMER: This map is provided as a courtesy to the Pennsylvania Bureau of Deep Mine Safety by American Primeur Underwriters, Inc. (The Penn Central Railroad Corporation) and its subsidiary United Railroad Corporation. American Primeur Underwriters, Inc. and United Railroad Corporation are not liable for any damages or losses resulting from the use of this map. American Primeur Underwriters, Inc. and United Railroad Corporation assume all risks of the use and agree to hold innocent persons who use this map for any reason harmless from the accuracy or completeness of this map or its fitness for any purpose. American Primeur Underwriters, Inc. and United Railroad Corporation disclaim any representation or duty to any person as to the accuracy or completeness of this map or its fitness for any purpose.

0-12

CLYMER No 2
WEST SIDE

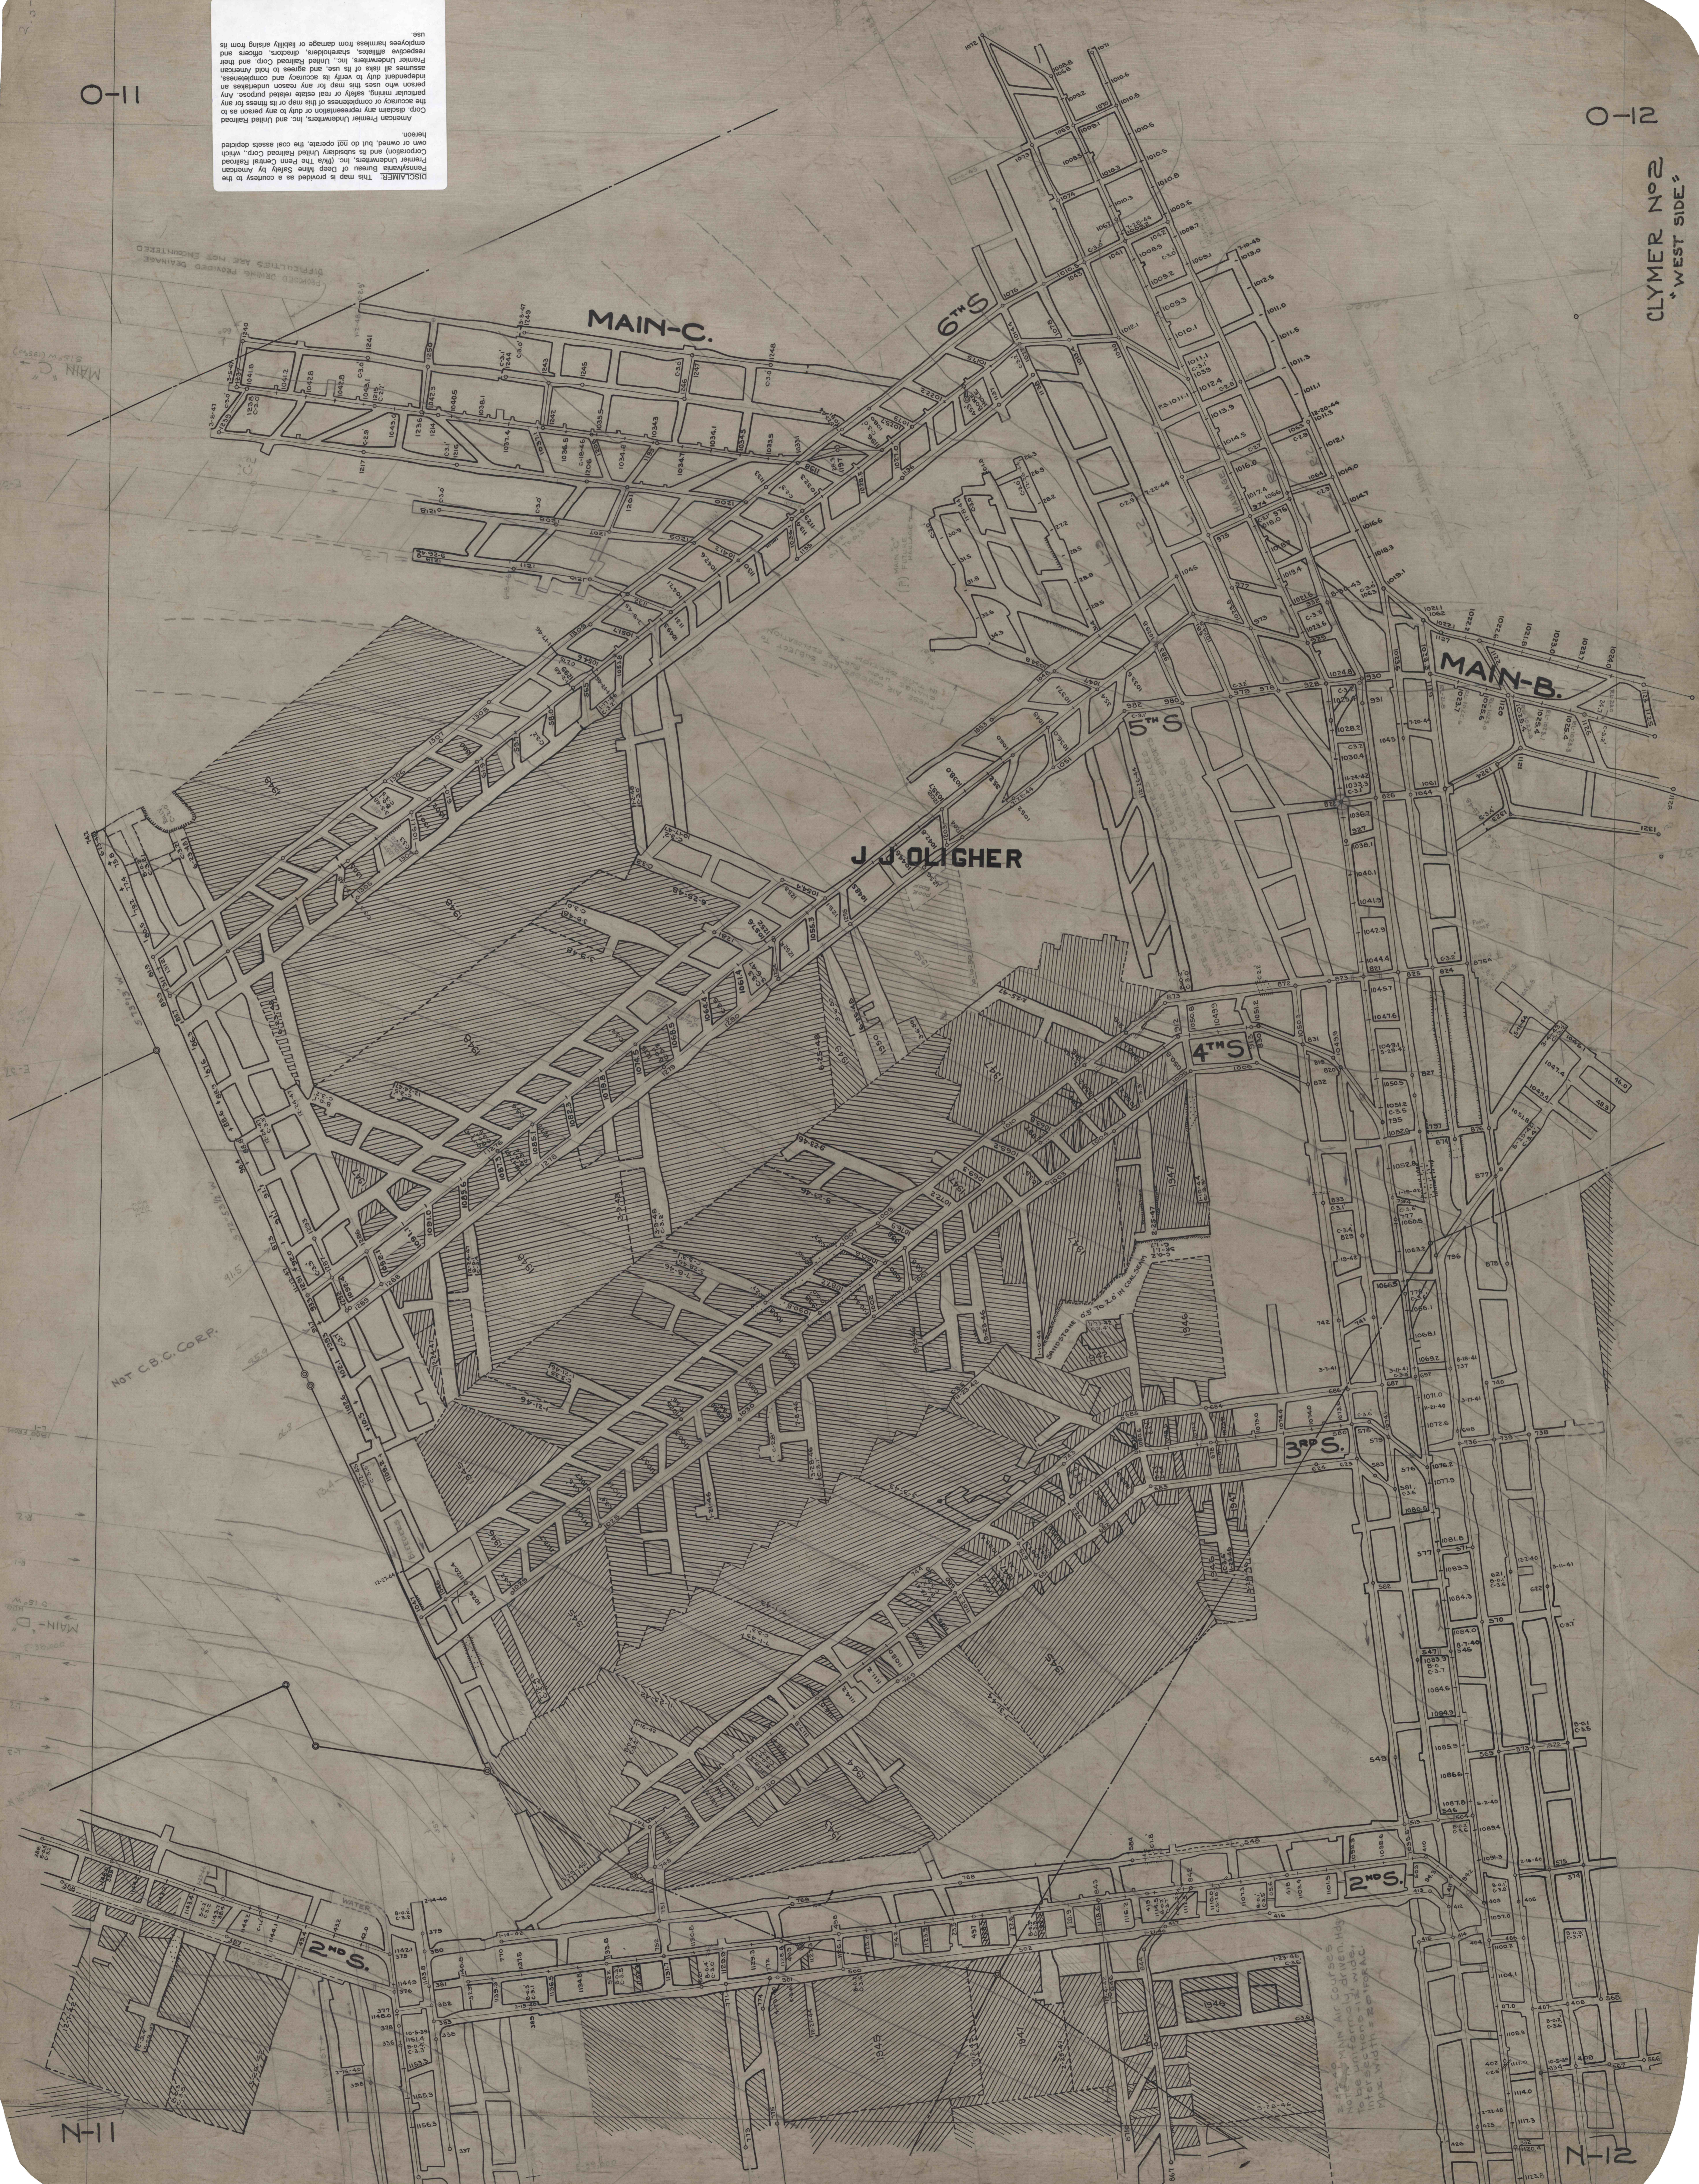

11-0

11-N


NOT C.B.C. CORP.

MAIN-D

11-N