



15A.  
GASTON  
WM. NOW  
PIERCE (FEE)  
TRACT D

CHARLES HUGUS et al  
49 1/2 A.  
NOW

J. LON WINEBARK (FEE)  
TRACT C

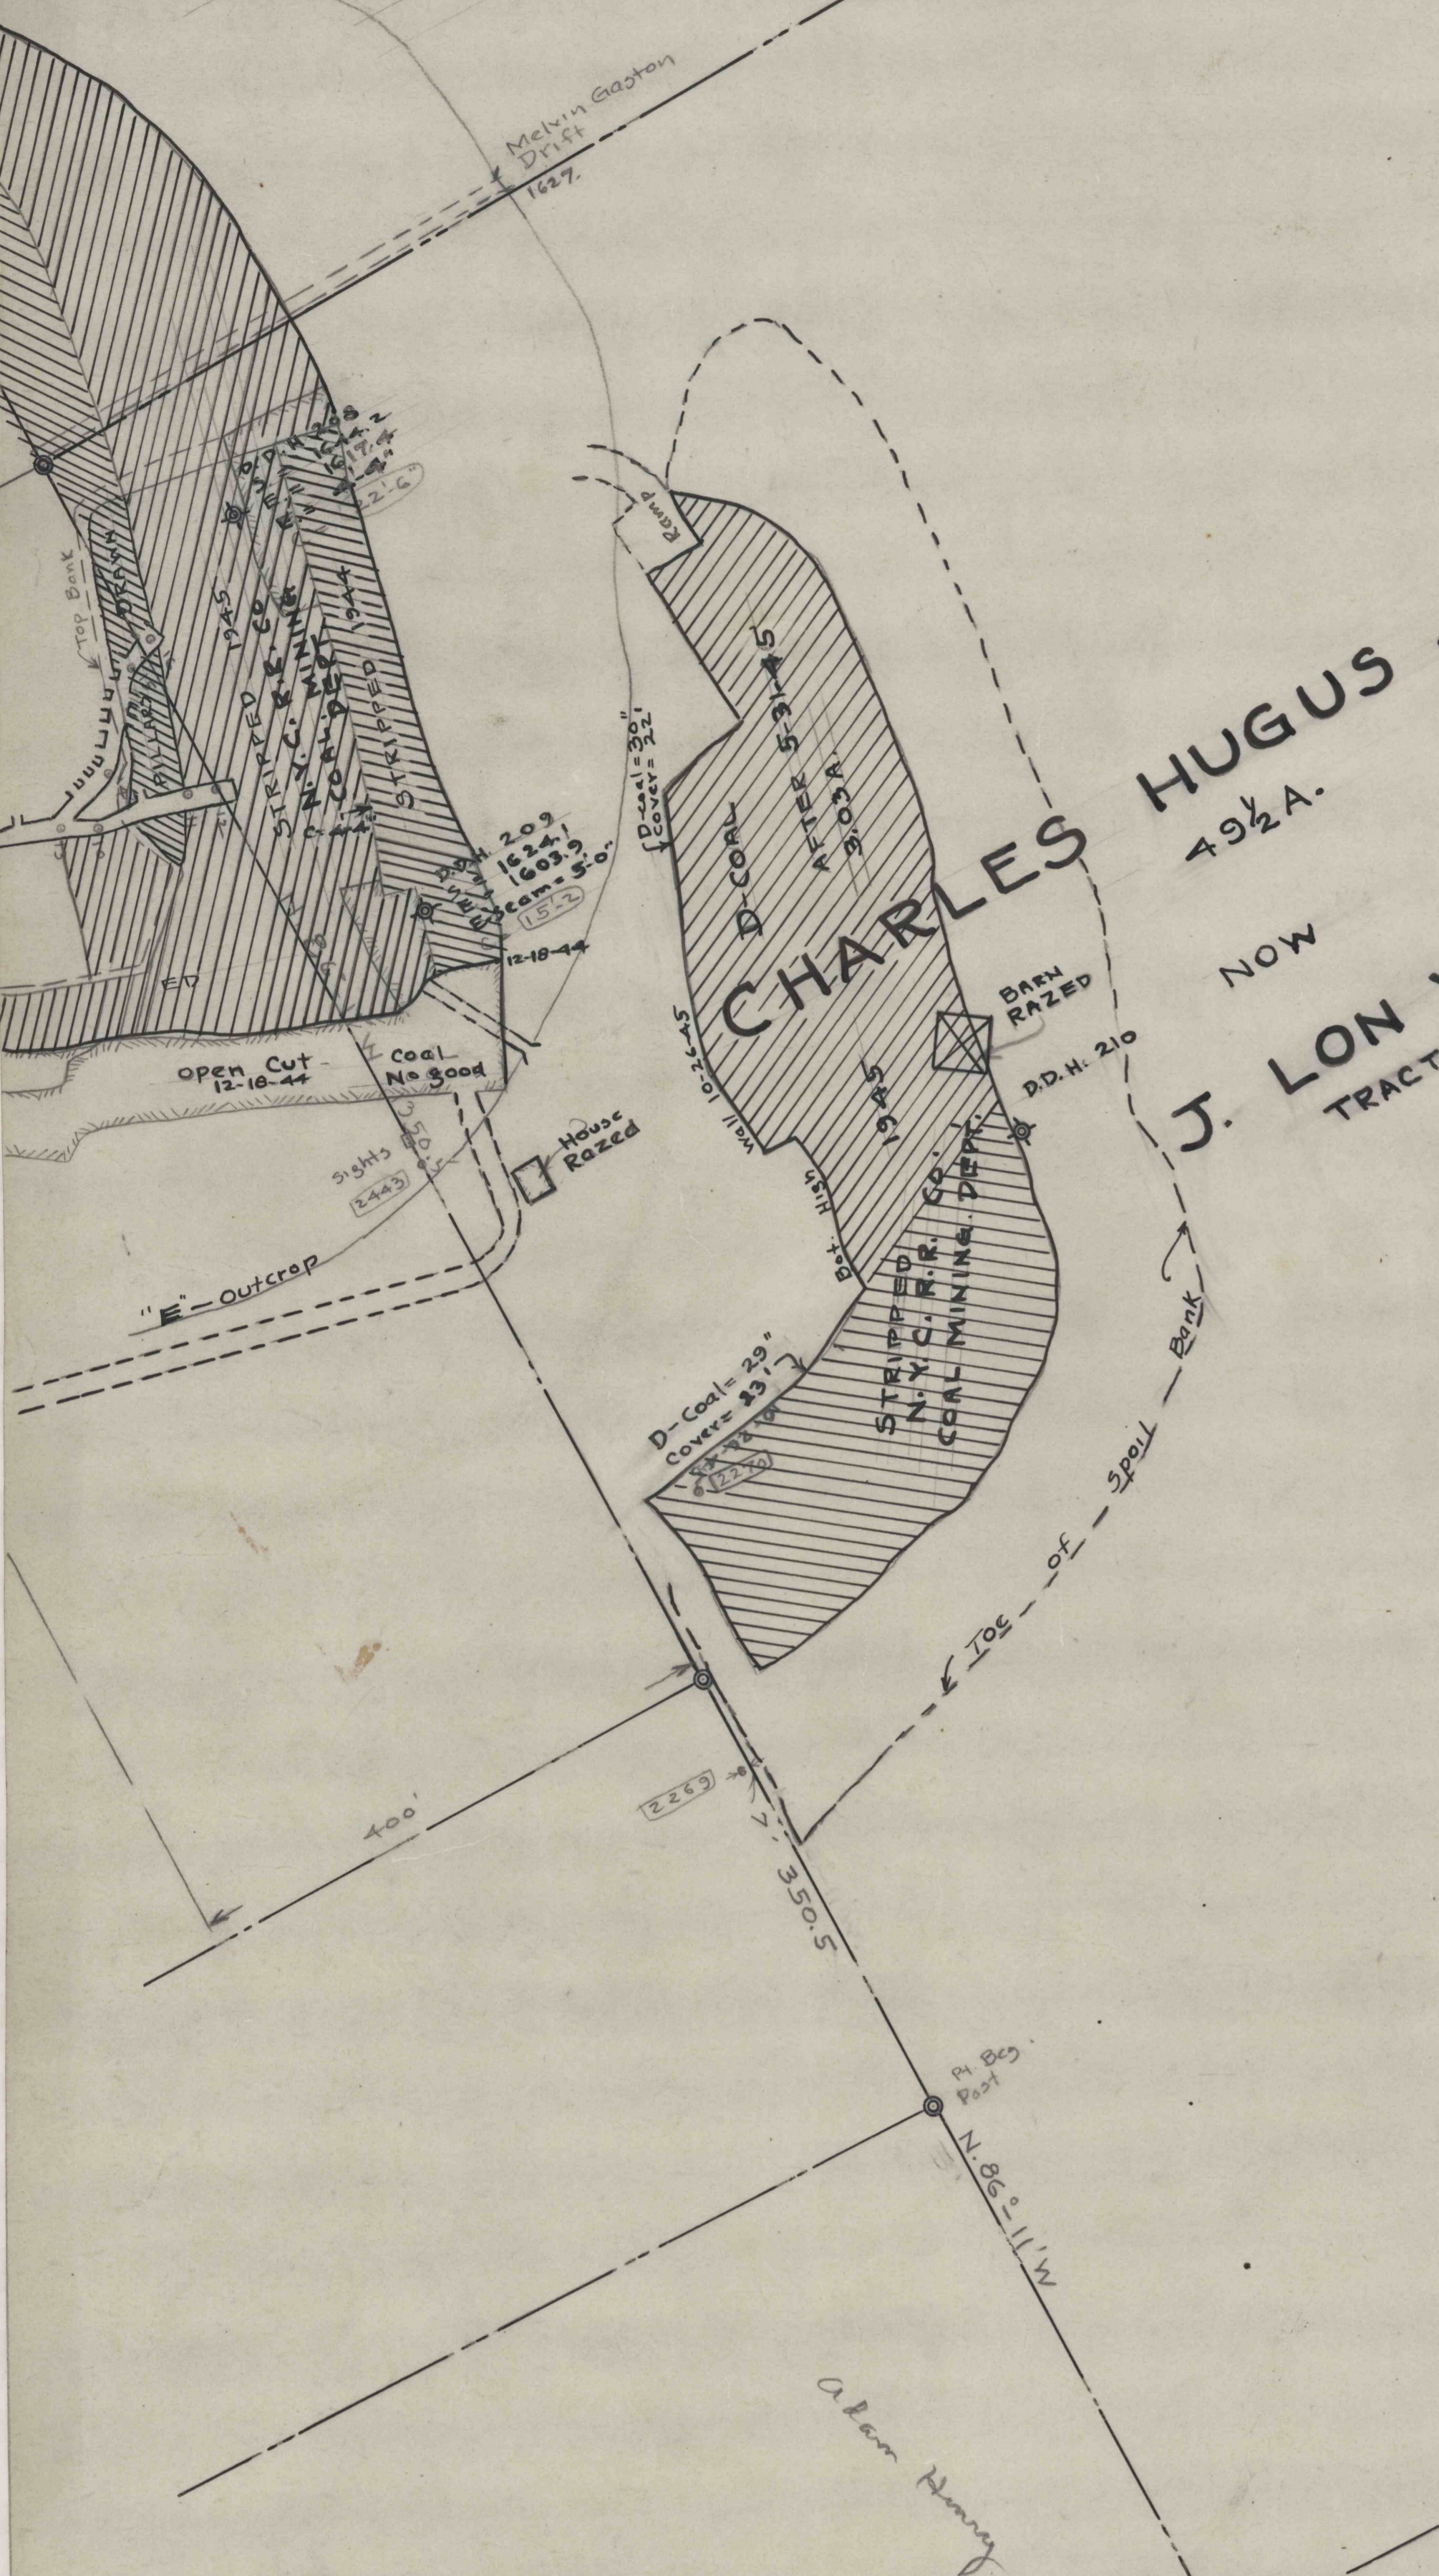

MAP SHOWING OPEN PIT MINE  
N.Y.C.R.R. CO. - COAL MINING DEPT.  
CANOE TOWNSHIP - INDIANA COUNTY, PA.  
SCALE 1" = 100'      OCTOBER 1, 1946.

LEGEND :- ACRES OF COAL STRIPPED SINCE 5-31-45. 

**DISCLAIMER:** This map is provided as a courtesy to the Pennsylvania Bureau of Deep Mine Safety by American Premier Underwriters, Inc. (fka The Penn Central Railroad Corporation) and its subsidiary United Railroad Corp., which own or owned, but do not operate, the coal assets depicted hereon.

American Premier Underwriters, Inc. and United Railroad Corp. disclaim any representation or duty to any person as to the accuracy or completeness of this map or its fitness for any particular mining, safety or real estate related purpose. Any person who uses this map for any reason undertakes an independent duty to verify its accuracy and completeness. American Premier Underwriters, Inc., United Railroad Corp. and their respective affiliates, shareholders, directors, officers and employees harmless from damage or liability arising from its use.

*John Henry*

*John Henry*

*A. S. Martin*

*Alan Henry*