



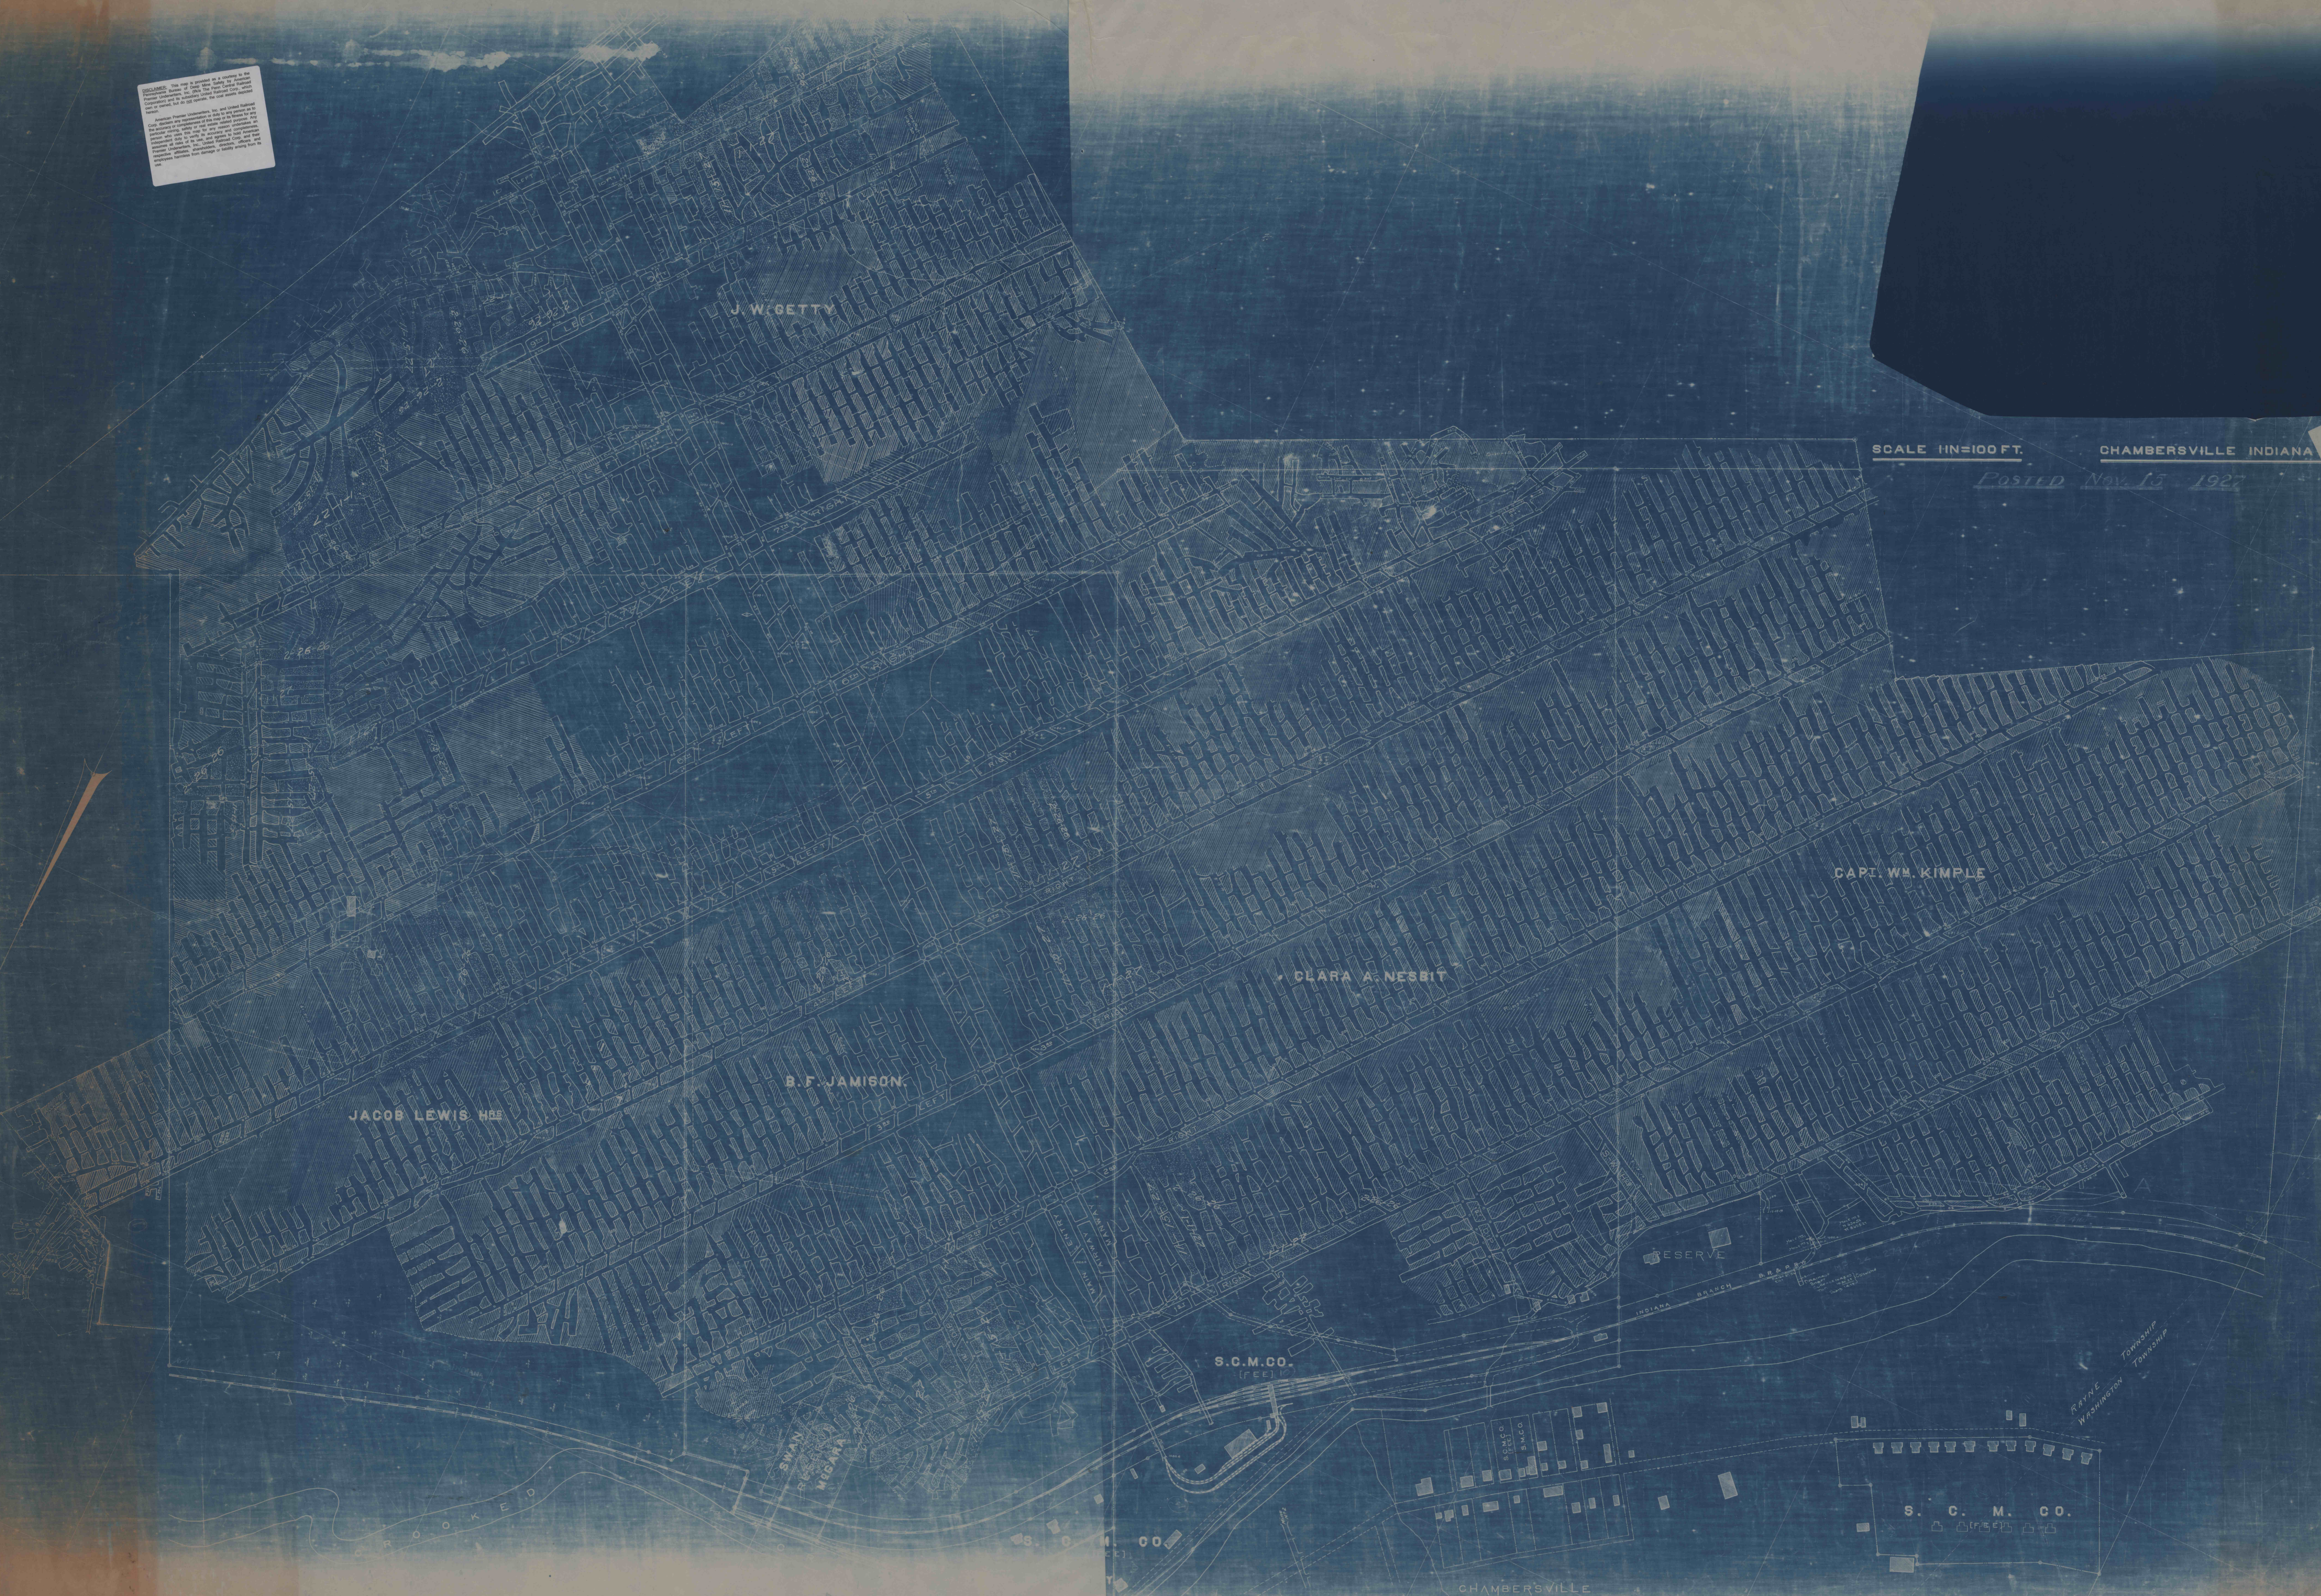

SCALE 1"=100 FT. CHAMBERSVILLE INDIANA

POSTED Nov. 15 1927

JACOB LEWIS HRE

B. F. JAMISON

CLARA A. NESBIT

CAPT. WM. KIMPLE

S. C. M. CO.
(FEE) L

RESERVE

S. C. M. CO.

CHAMBERSVILLE

RAYNE
WASHINGTON
TOWNSHIP