




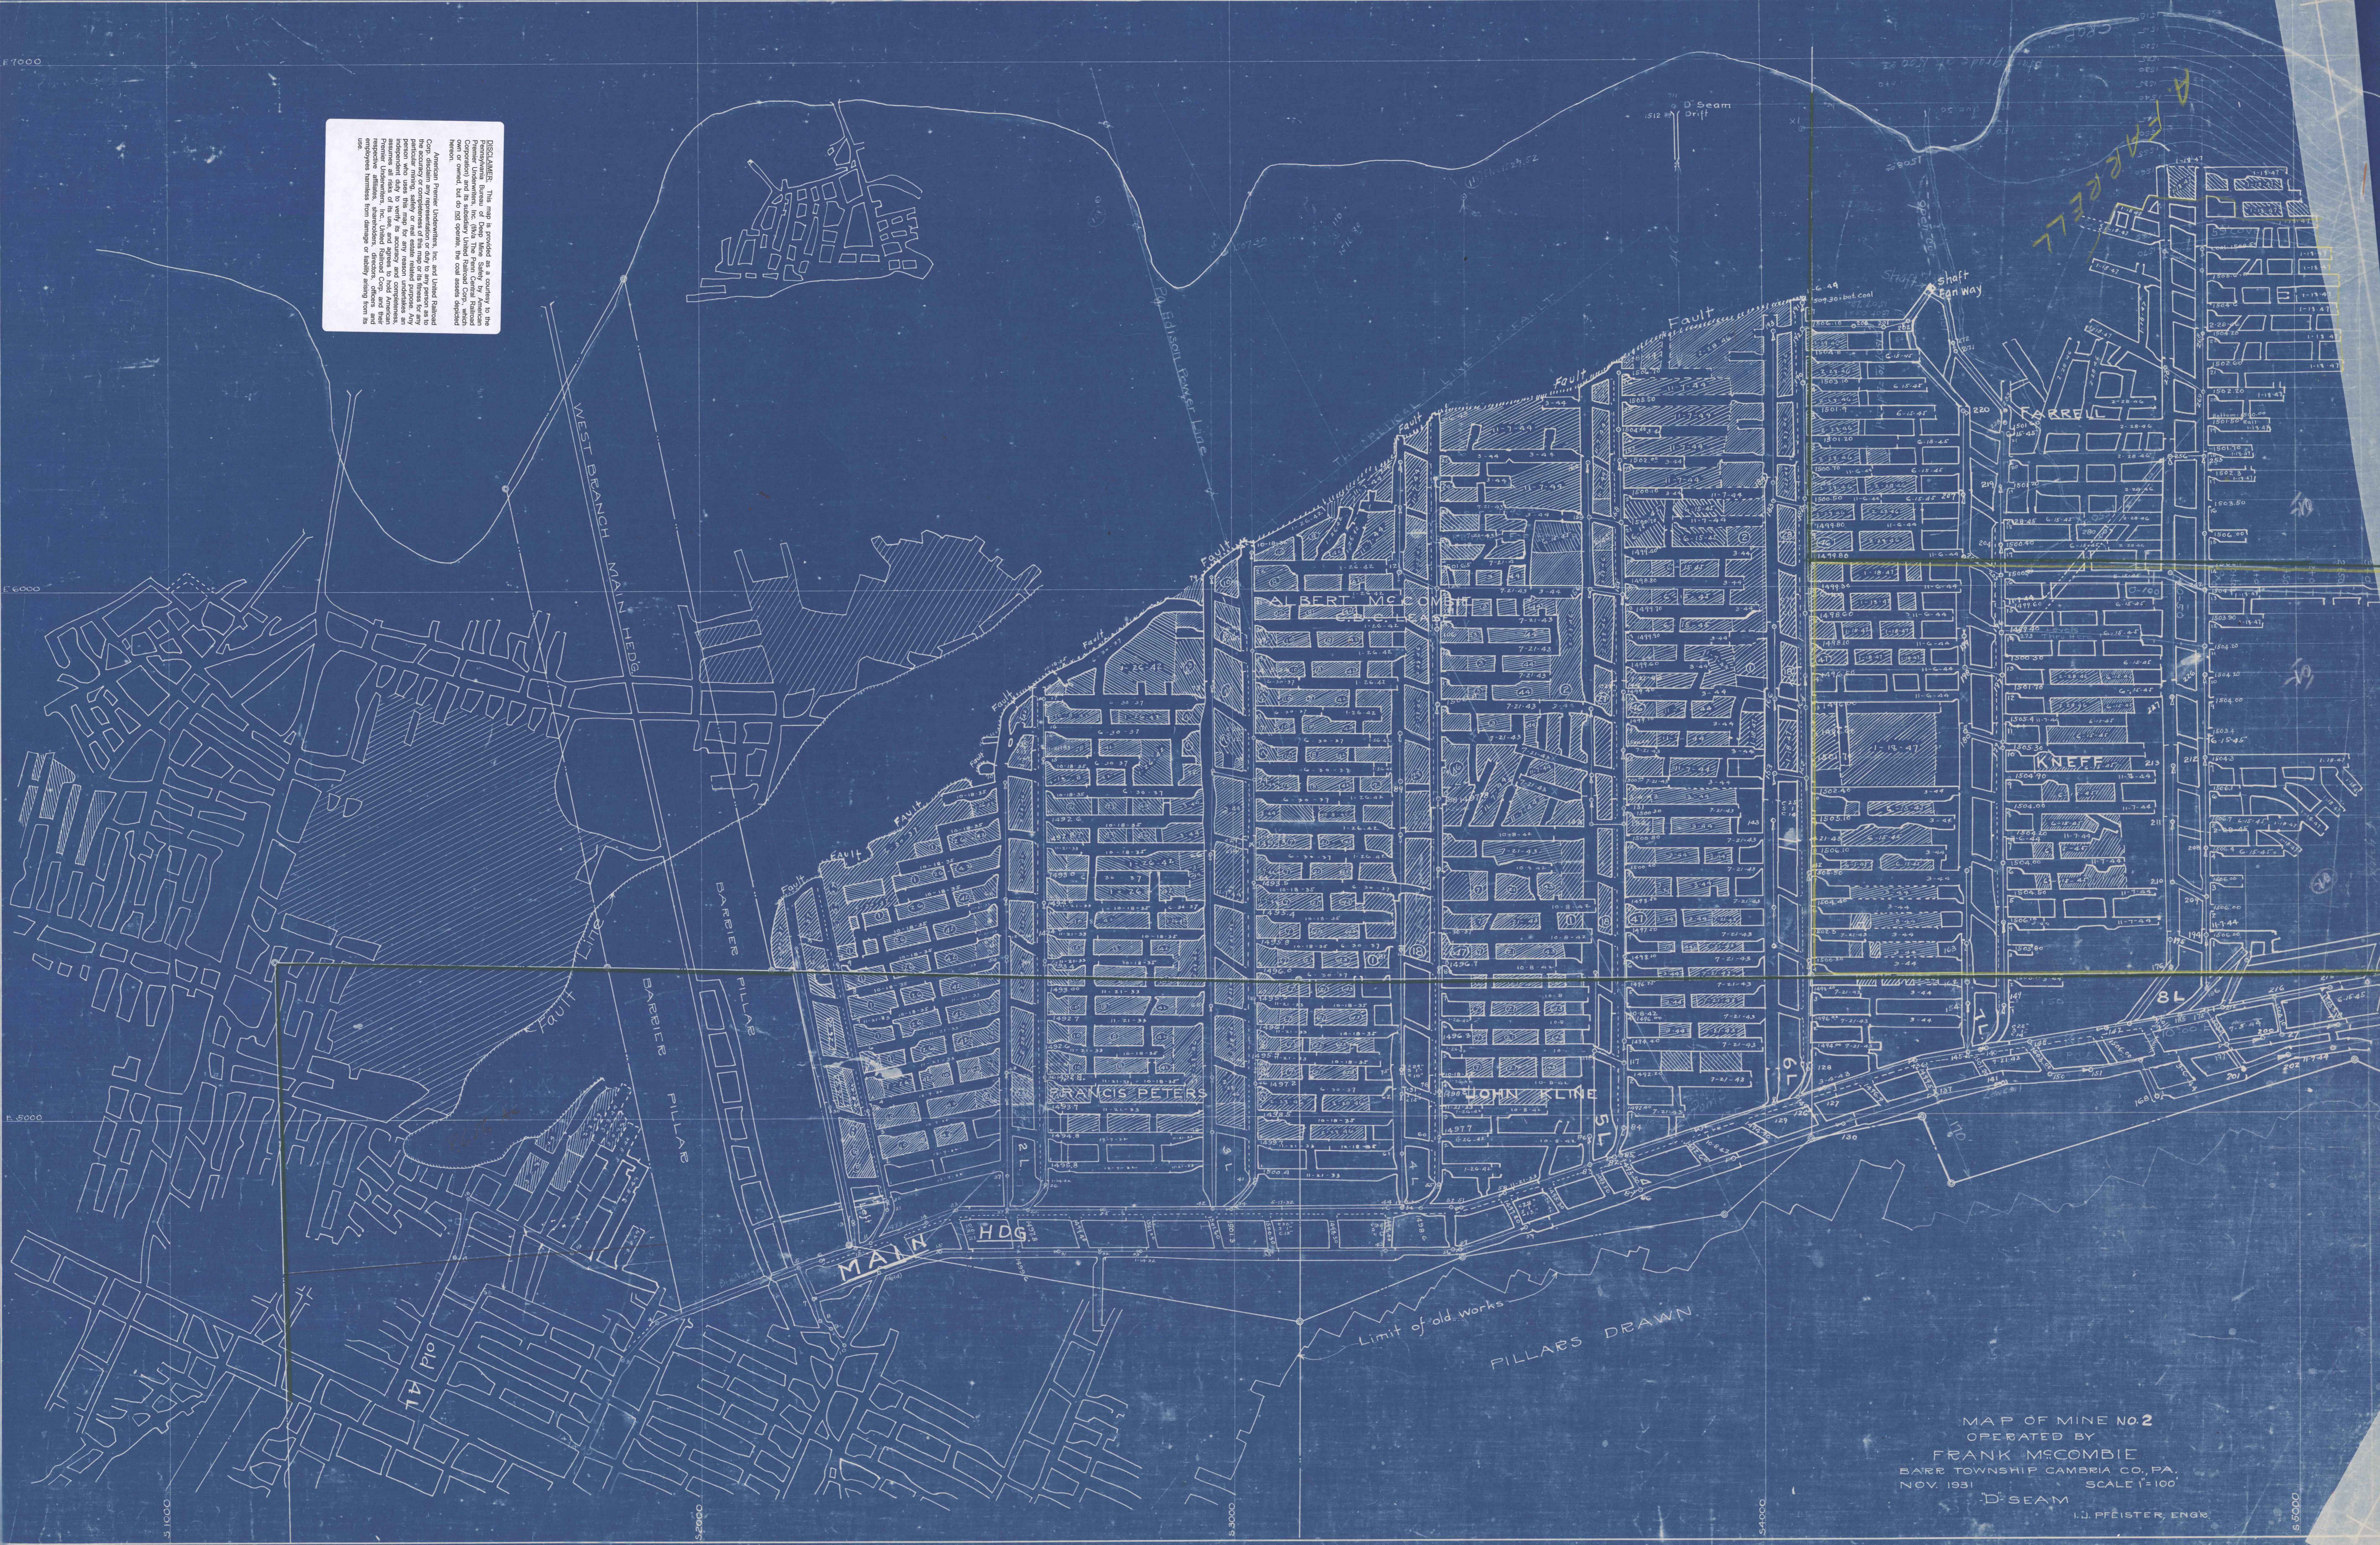

MAP OF MINE No. 2
 OPERATED BY
 FRANK MCOMBIE
 BAIR TOWNSHIP CAMBRIA CO., PA.
 NOV. 1931 SCALE 1"=100'
 D SEAM
 I. J. PFISTER, ENGR.