


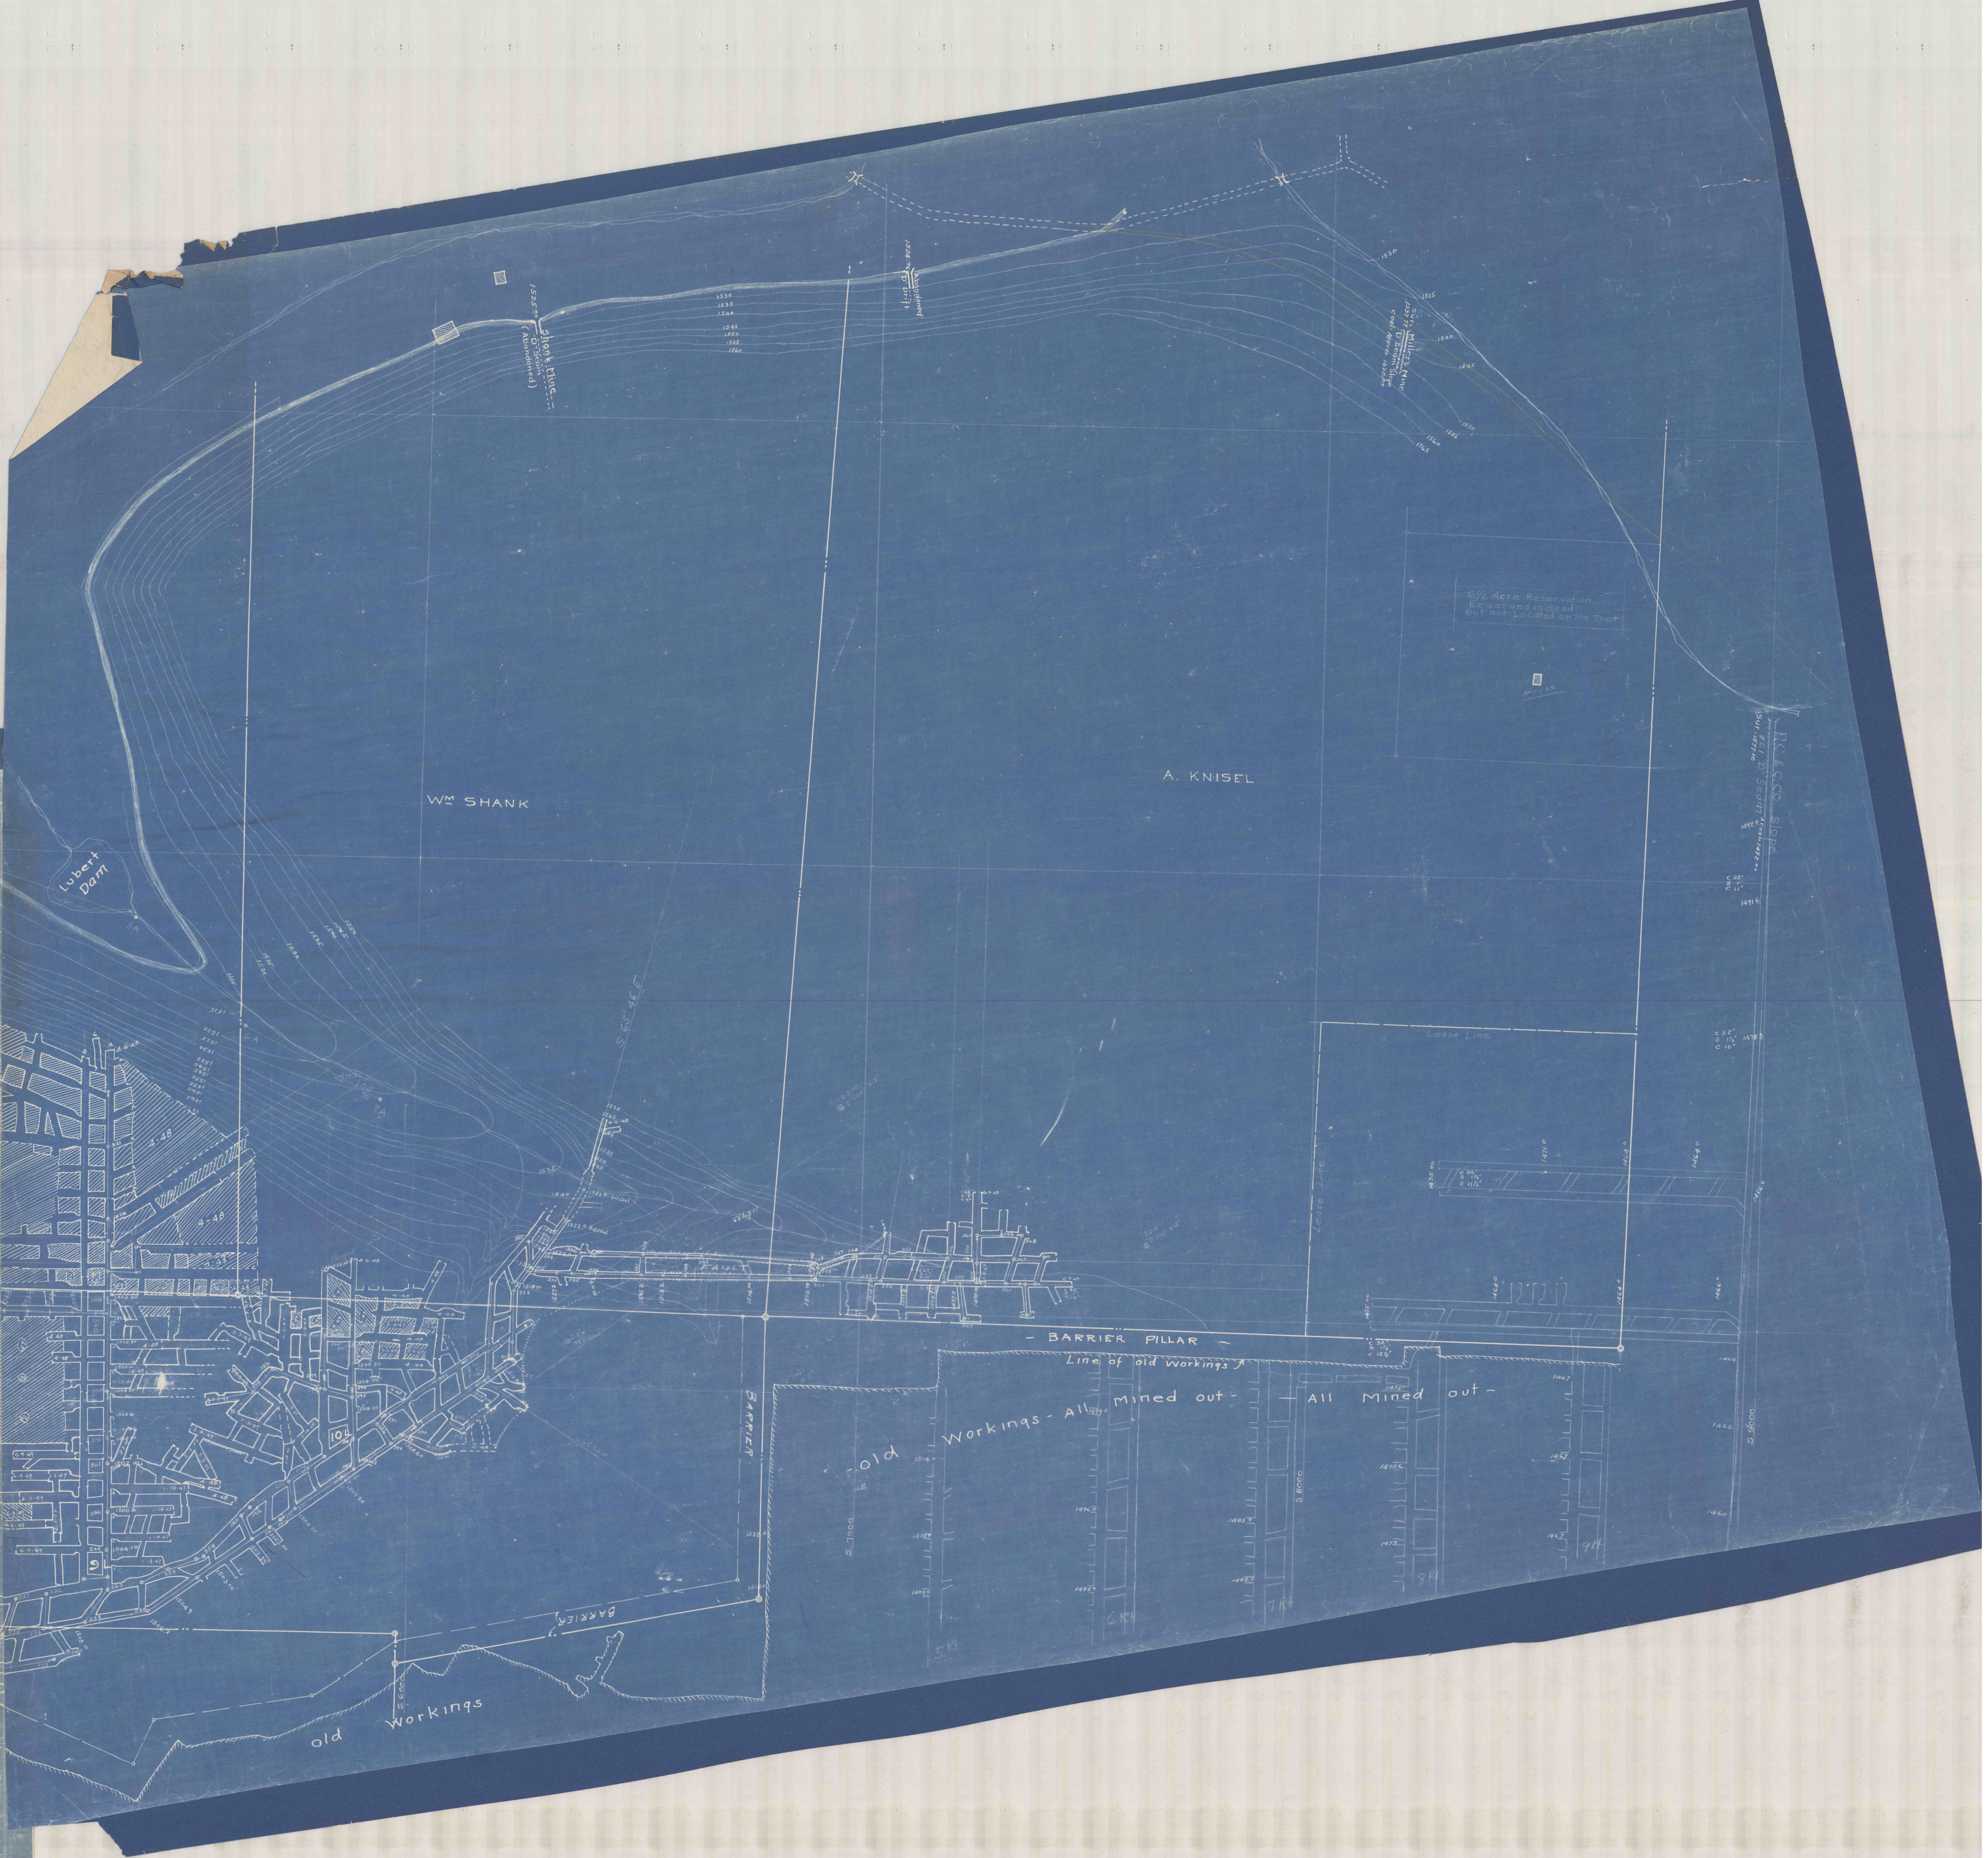

MAP OF MINE NO 2
 OPERATED BY
 FRANK McCOMBIE
 BARK TOWNSHIP CAMBERIA CO. PA.
 NOV. 1931 SCALE 1"=100'
 D SEAM
 L.J. PFISTER, ENGR.



185 DRAWN