



HOMER BASHFORTH
 75.14 ACRES DEED FEBRUARY 26, 1943
 FORMERLY - EMMA W. SMAL.

HOMER BASHFORTH TRACTS
 HEMPFIELD TWP., WESTMORELAND CO. PA.
 DEEP MINING AND
 PROPOSED STRIPPING
 OPERATION NO. 1.
S. & M. COAL CO.
 SCALE ~ 1"=100'
 JULY 22, 1949
 REVISED TO OCT. 7, 1950
 ENGINEER
Paul W. ...

STRIPPING DATA.
 STARTED OPERATION - JULY 11, 1949
 NET TONS COAL - 4430
 ACRES COAL EXTRACTED - 1.07
 AVERAGE OVERBURDEN - 36"
 AVE. COAL THICKNESS - 4.80
 ACRES OF LAND AFFECTED - 4.80
 READY FOR FINAL INSPECTION - OCT. 7, 1950
 COMPLETION REPORT - OCT. 14, 1950
 OPERATION FILE NO. 973; BOND NO. 889.




HOMER BASHFORTH
 FORMERLY - GEORGE F. KEATLEY
 64.3 A. DEED - JANUARY 11, 1949

24" COVER
 D.M. NO. 2
 DATE - 12-16-47
 COAL - 1153.2 - 137R.

12" DRILLED WITH AUGERS
 DATE - 12-16-47
 COAL SHOULD BE AT 1150.0 OR 5' BELOW SURFACE

6" SURFACE
 1-2 SANDSTONE
 1-4 YELLOW CLAY
 0-8 BROWN SANDY SHALE
 3-0 COAL
 BLOCKED CORE BARREL

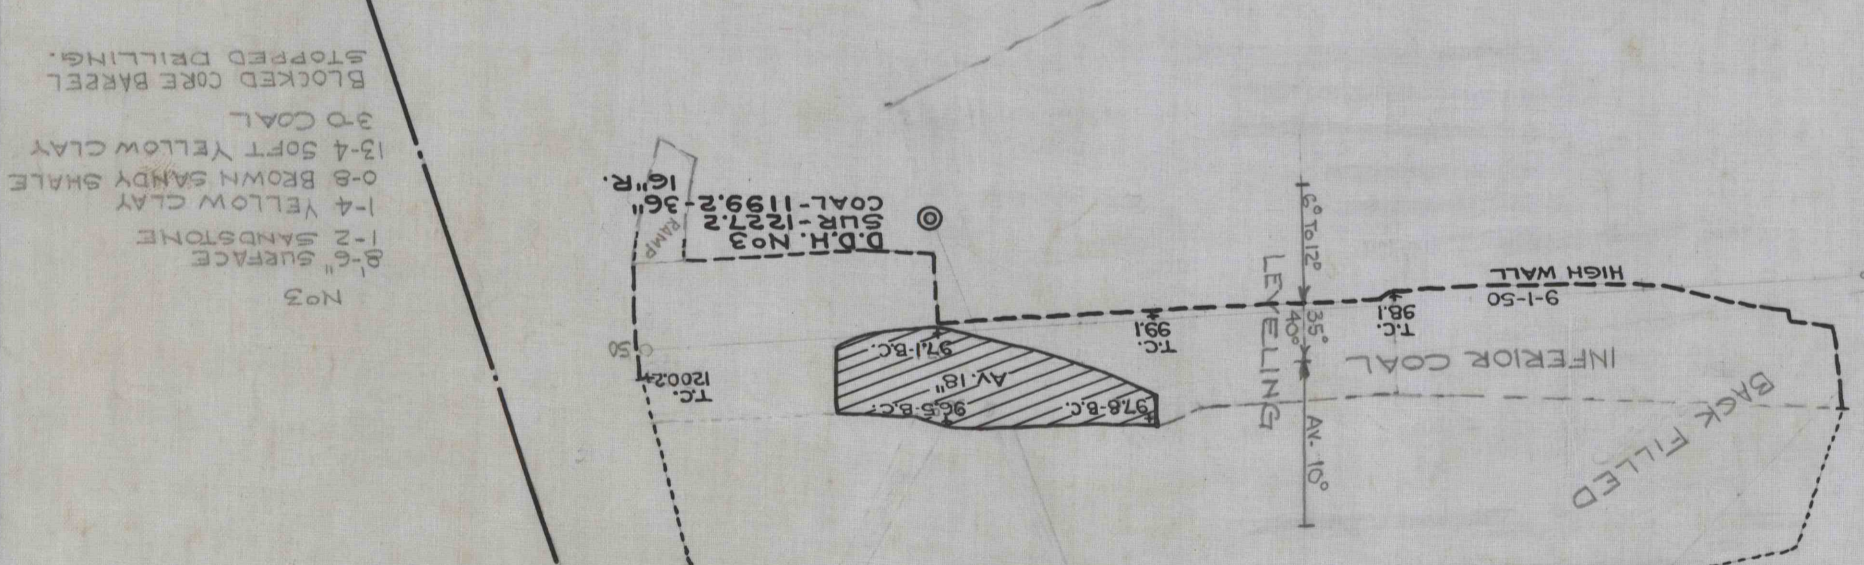


