




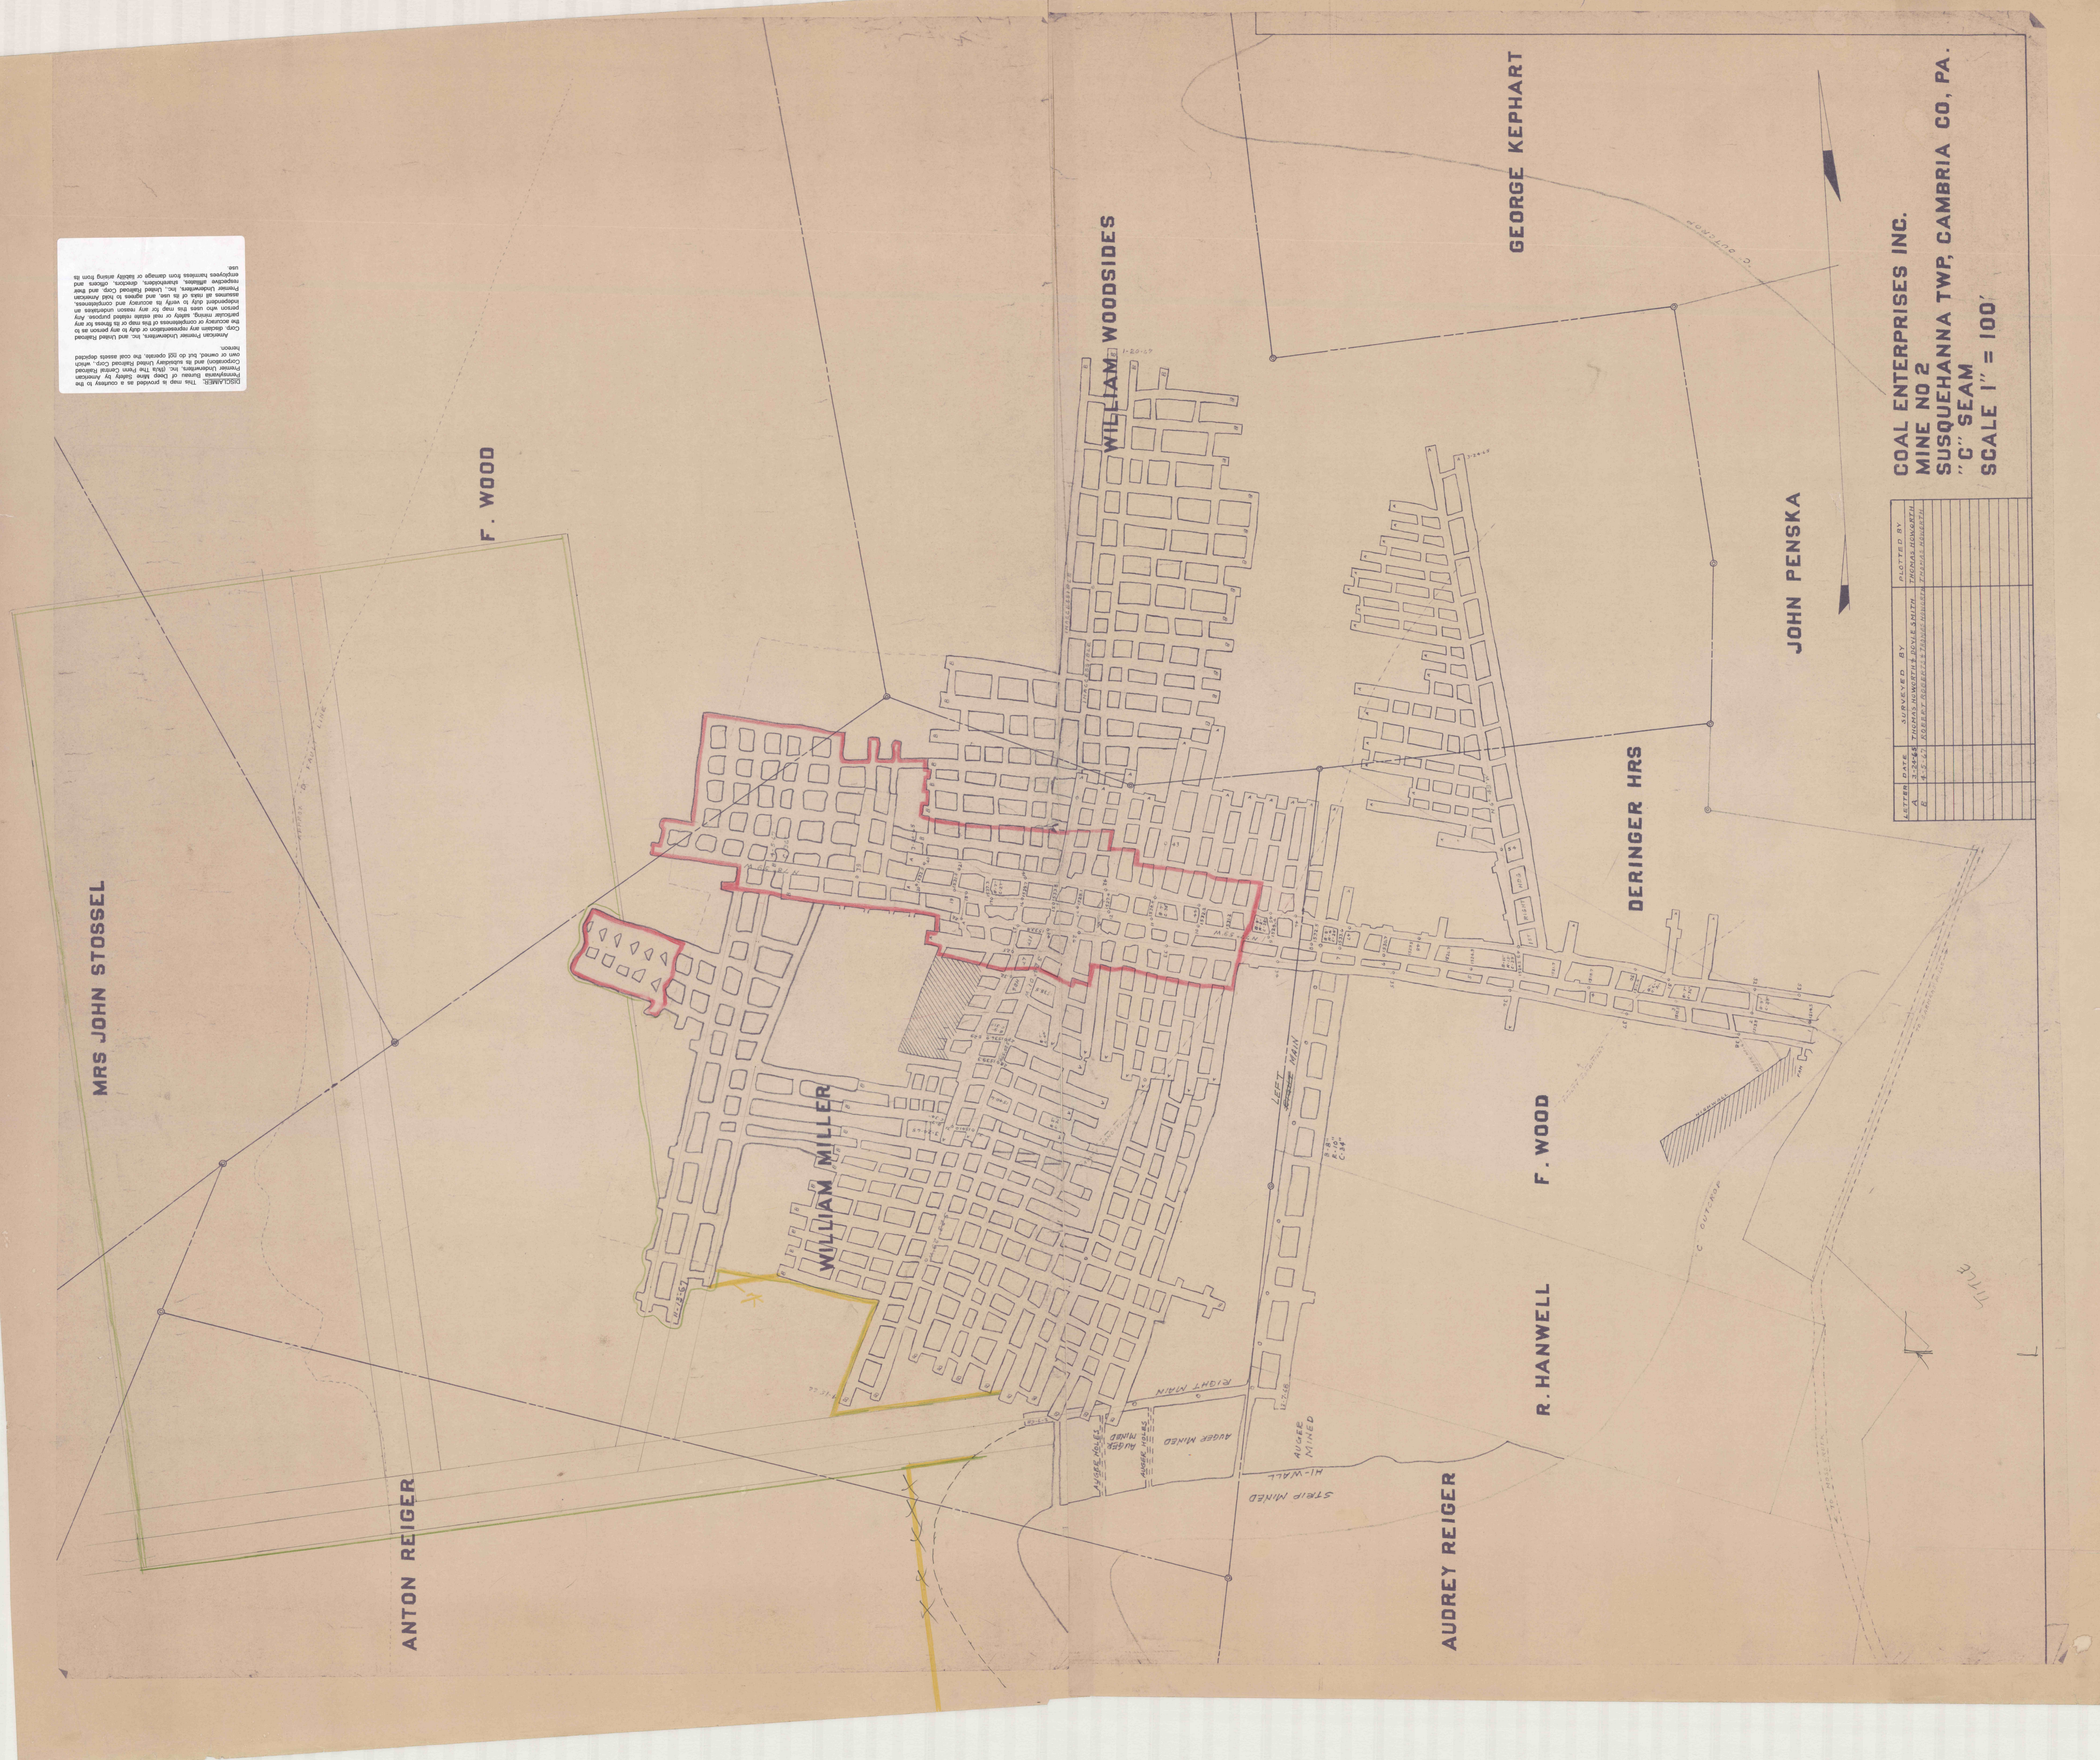

LETTER	DATE	SURVEYED BY	PLOTTED BY
C			
D			
E			
COAL ENTERPRISES INC.
 MINE NO 2
 SUSQUEHANNA TWP, CAMBRIA CO, PA.
 "C" SEAM
 SCALE 1" = 100'

TITLE