


W. SALTS GIVER

SMITH

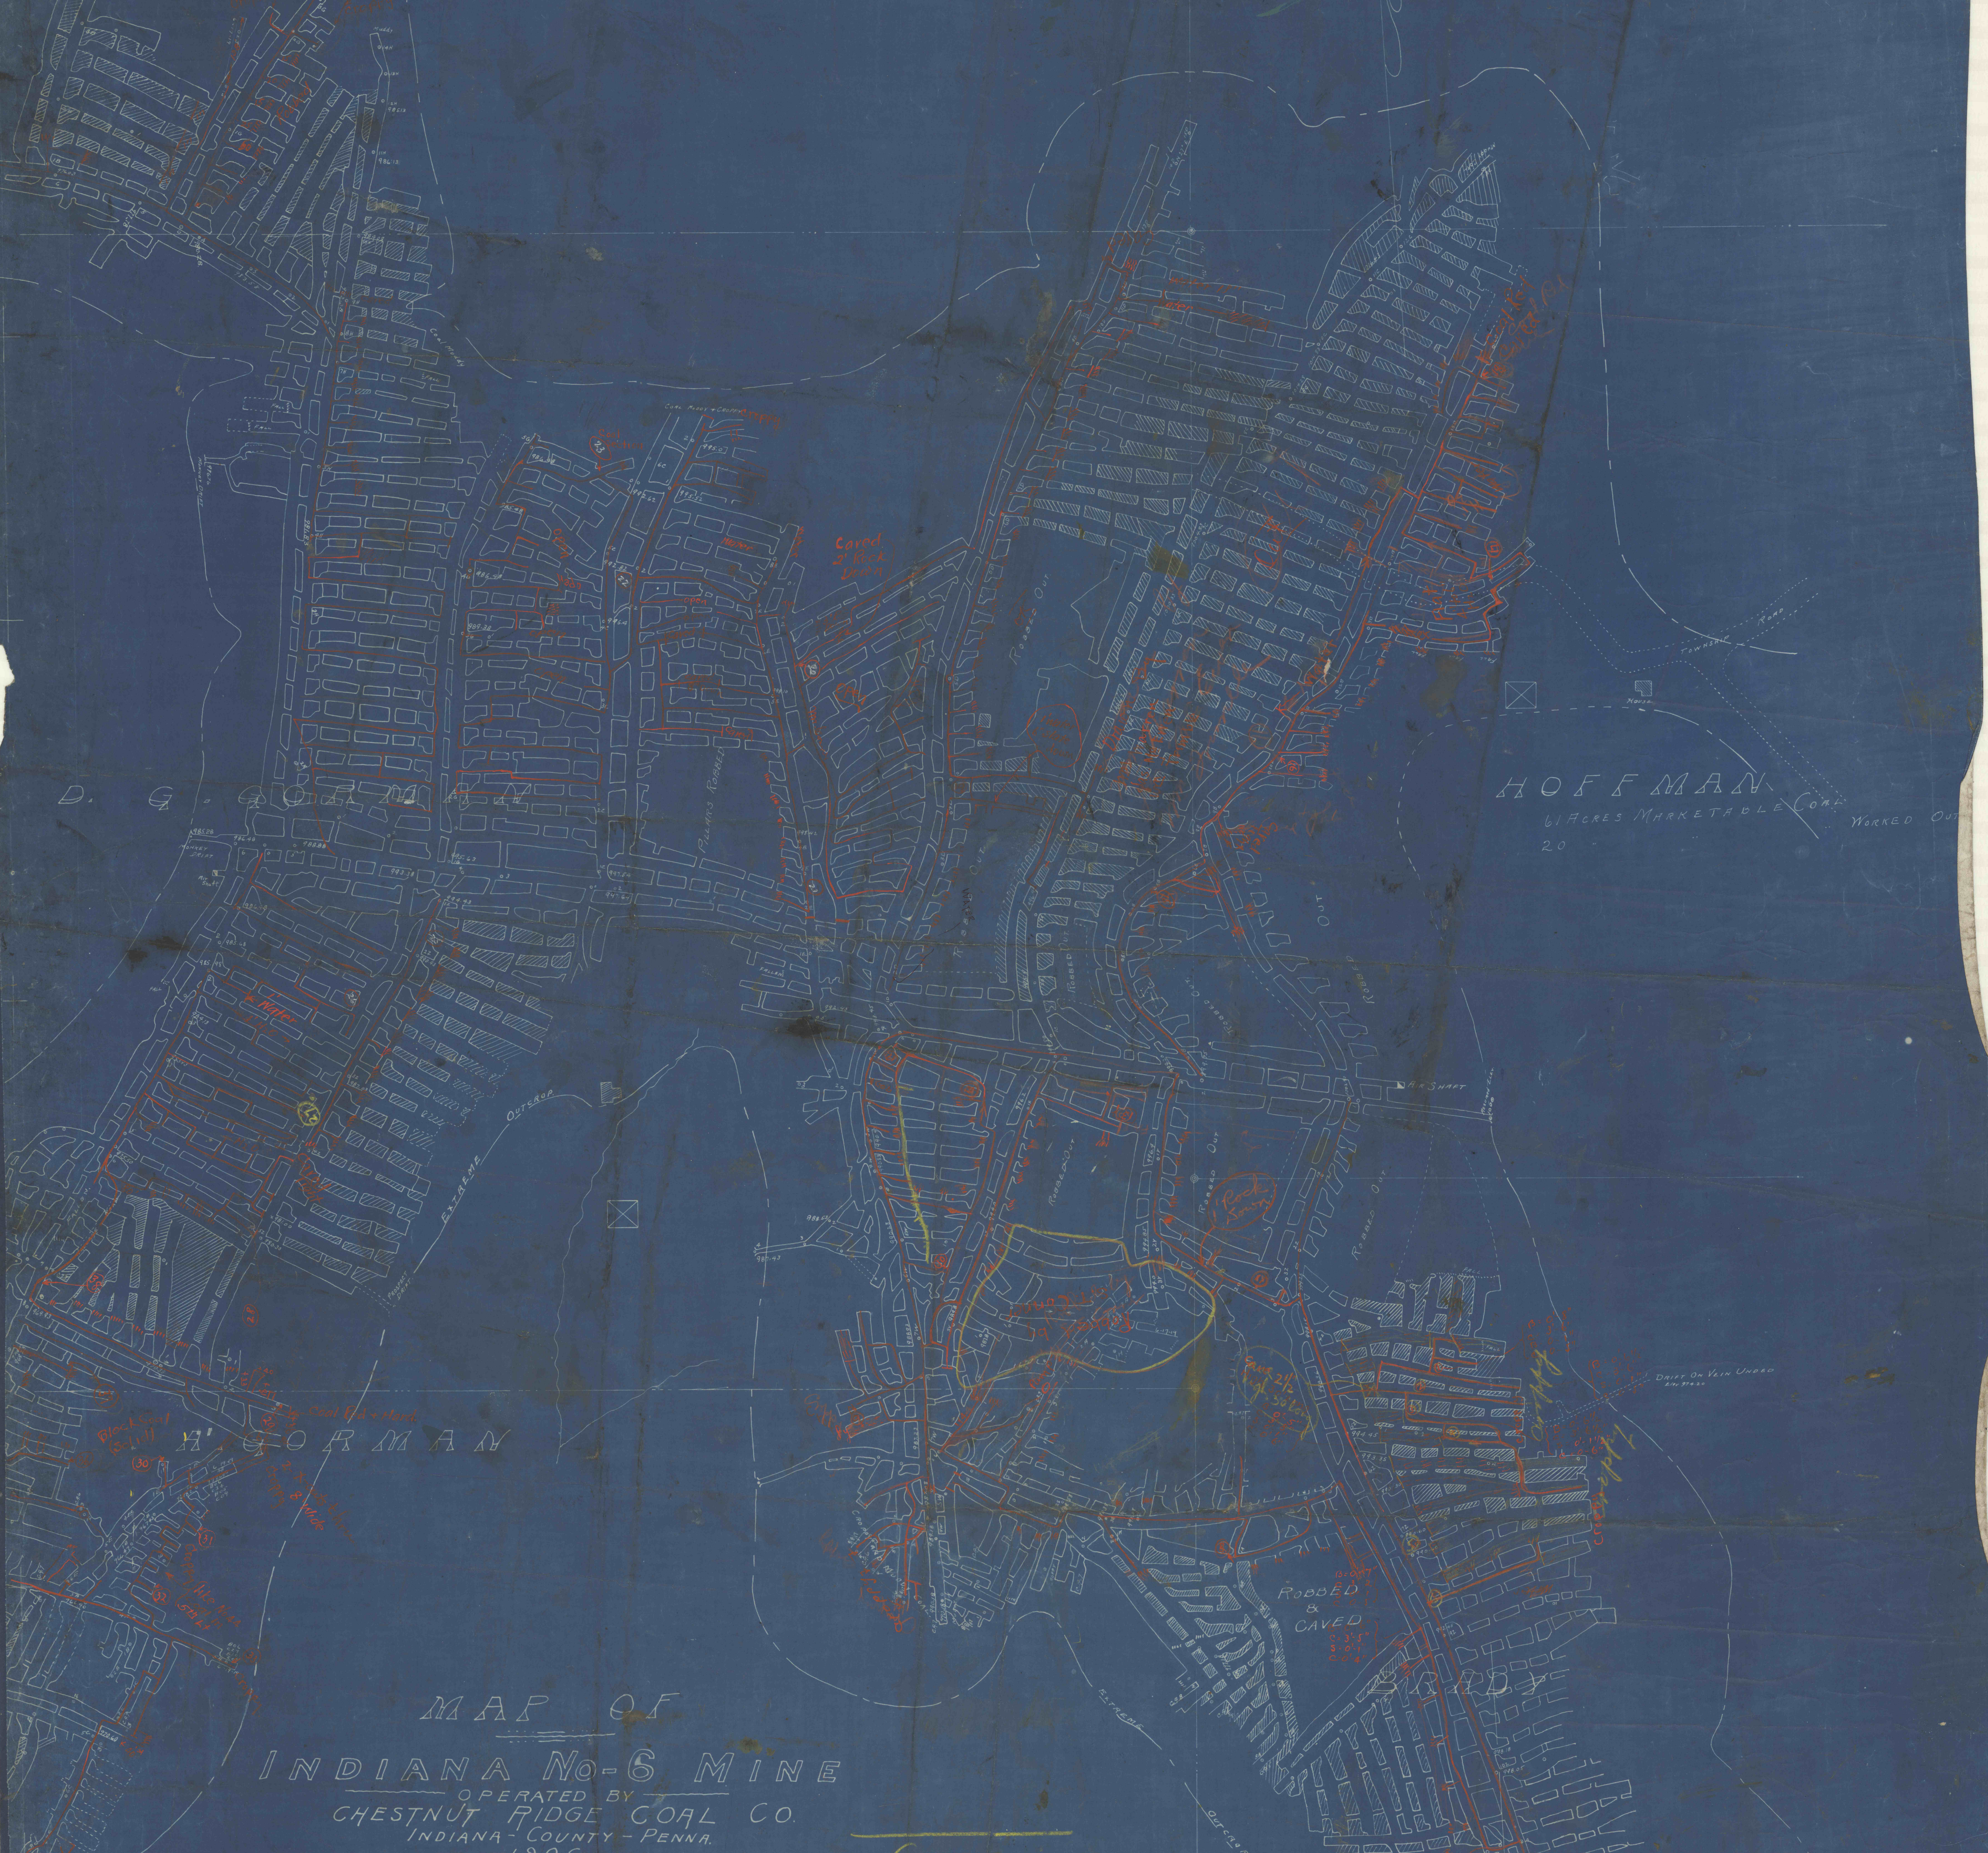

MAP OF  
 INDIANA No. 6 MINE  
 OPERATED BY  
 CHESTNUT RIDGE COAL CO.  
 INDIANA - COUNTY - PENNA.  
 1906

SCALE 1" = 100'  
 SURVEYED TO JUNE 29<sup>th</sup> 1916  
 AUGUST 10<sup>th</sup> 1917  
 Geo. H. Ayres, Engineer  
 Philadelphia, Pa.

DISCLAIMER: This map is provided as a courtesy to the Pennsylvania Bureau of Deep Mine Safety by American Premier Underwriters, Inc. (via The Penn Central Railroad Corporation) and its subsidiary United Railroad Corp., which own or owned, but do not operate, the coal assets depicted hereon.

American Premier Underwriters, Inc. and United Railroad Corp. disclaim any representation or duty to any person as to the accuracy or completeness of this map or its fitness for any particular mining, safety or real estate related purpose. Any person who uses this map for any reason understands an independent duty to verify its accuracy and completeness, assumes all risks of its use, and agrees to hold American Premier Underwriters, Inc., United Railroad Corp., and their respective affiliates, shareholders, directors, officers and employees harmless from damage or liability arising from its use.

For Coal Sections  
 See Level 1 Book  
 Patton Div. Vol. 435  
 Pages 16+17

Aug 15 1919

(32) - Represents No. and Place Coal Sample was measured

HLS

ROLL WITH A-1  
 B-268

Brady  
 15

15  
 water  
 coal not dropped  
 in tray

HOFFMAN  
 61 ACRES MARKETABLE COAL  
 20 WORKED OUT

ROBBED & CAVED

Drift on vein underground

Carroll  
 20  
 100

D. G. GORMAN

GORMAN