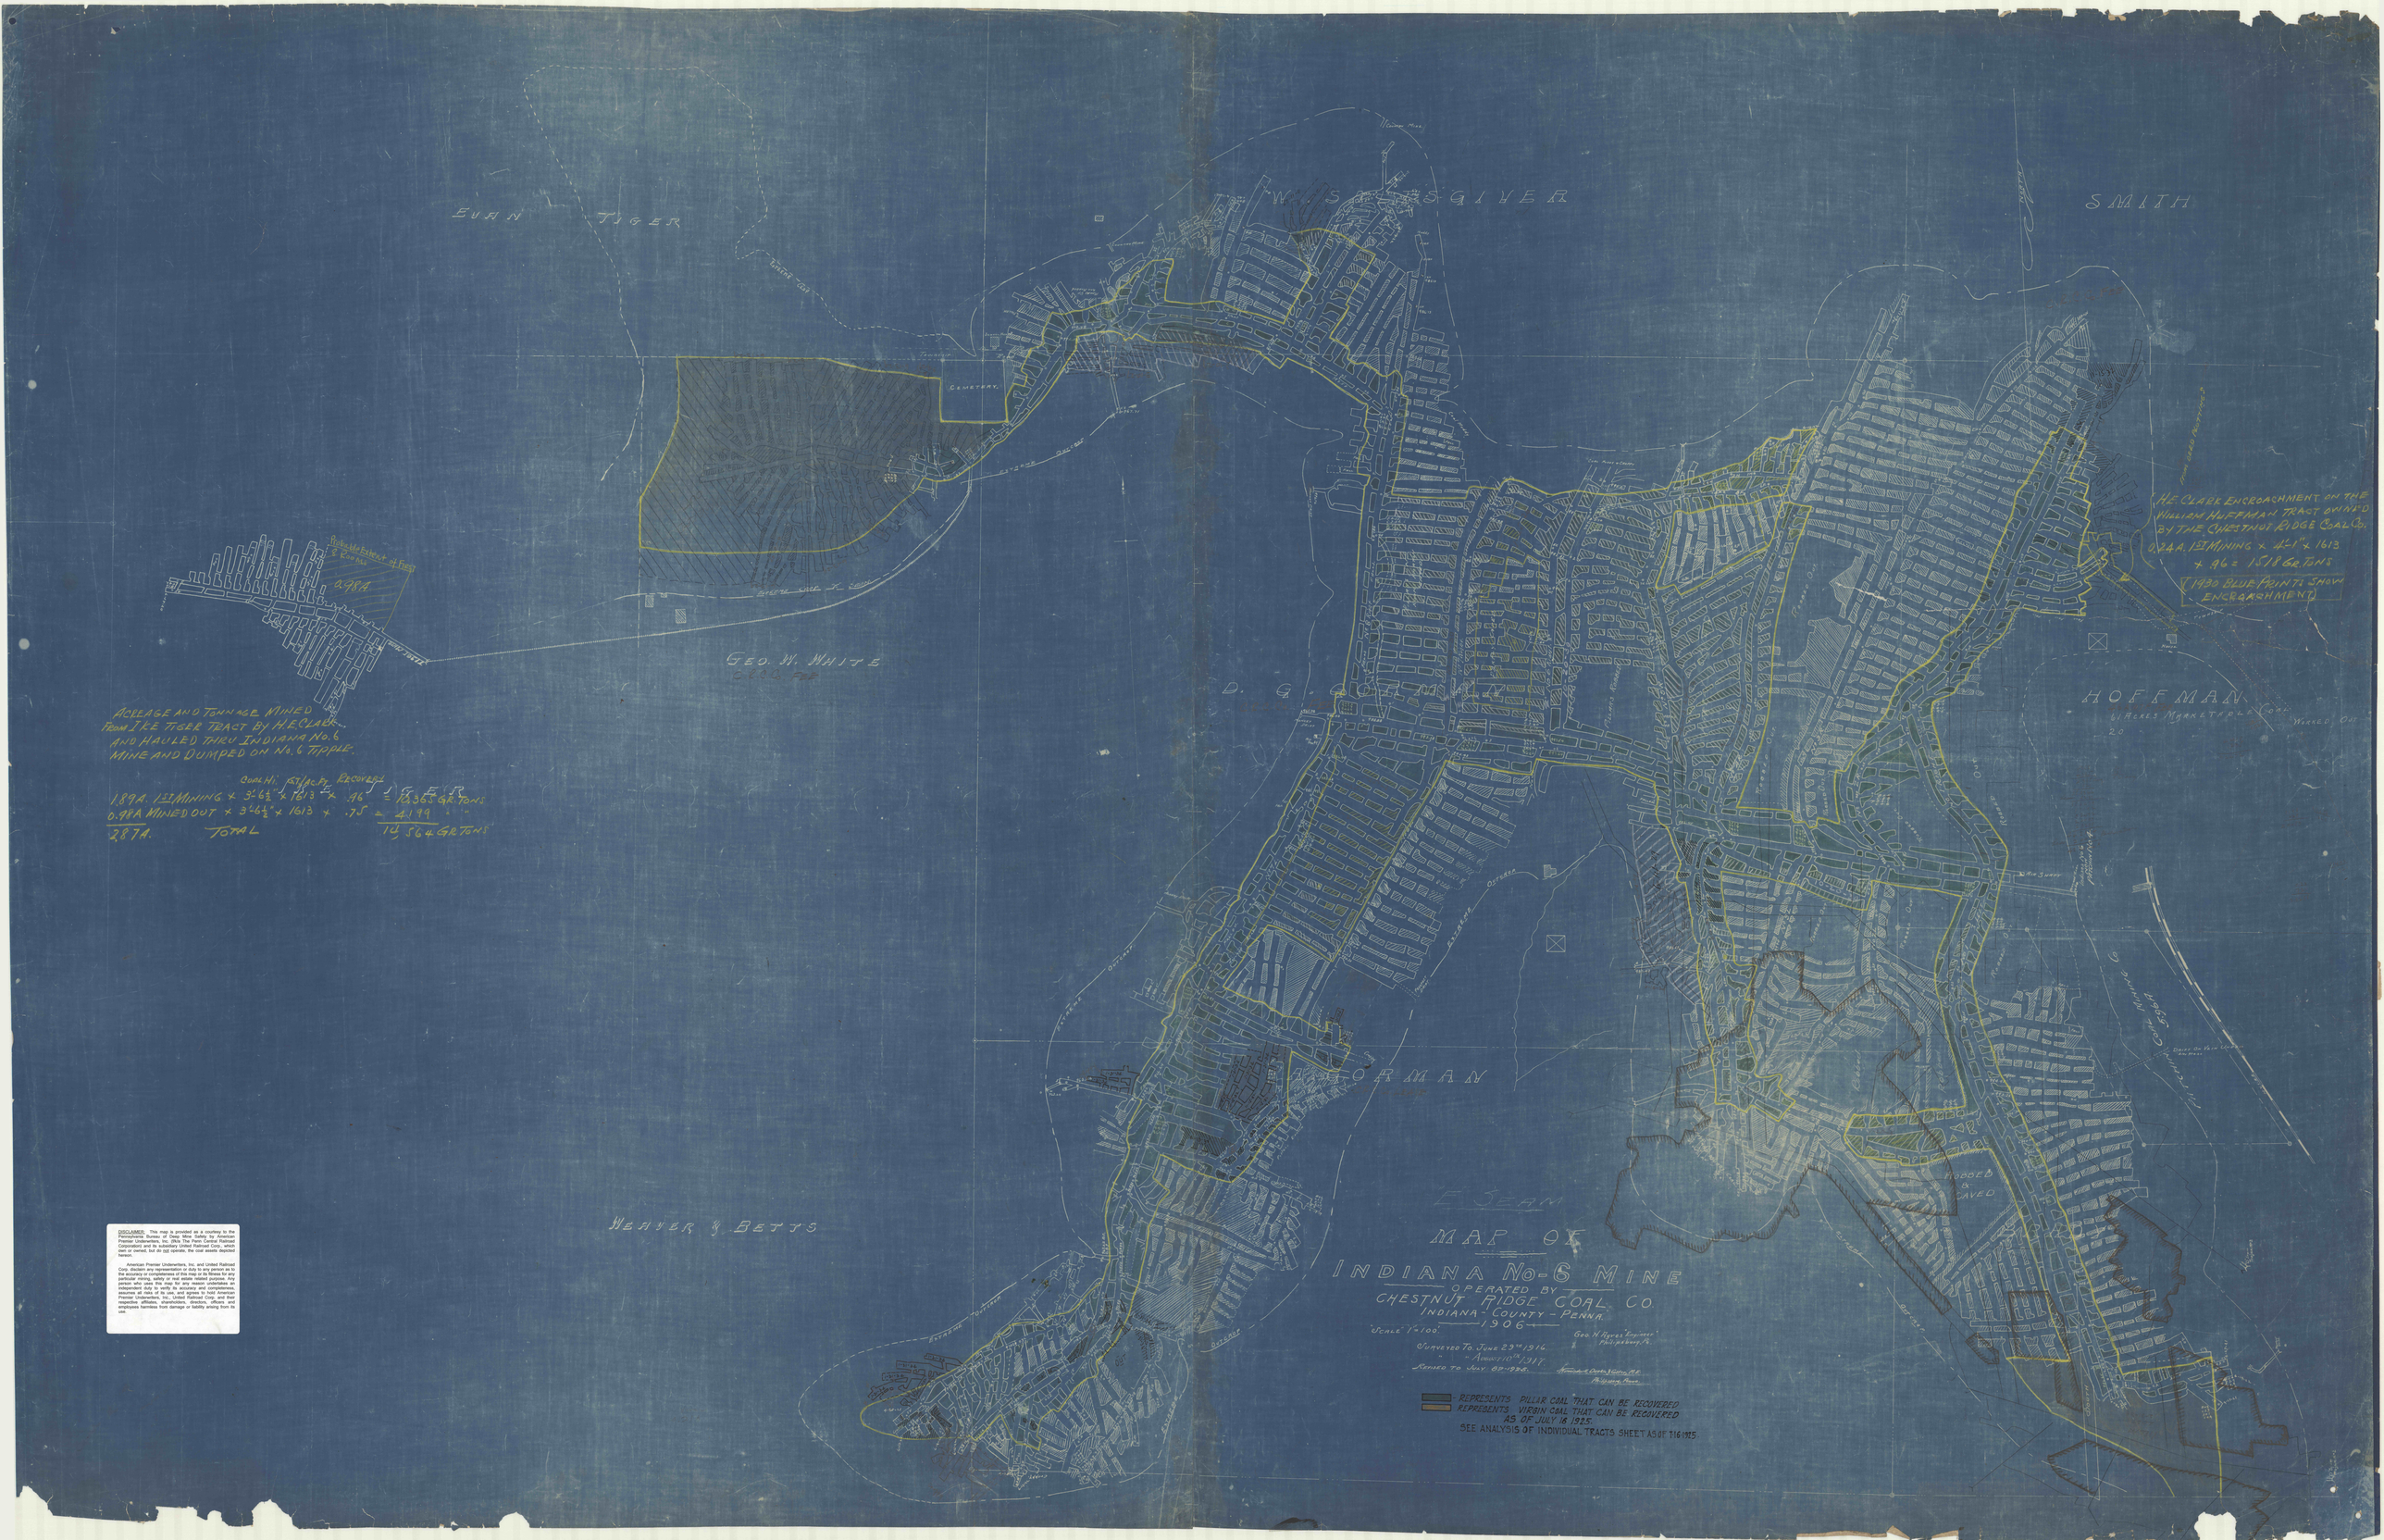
EVAN TIGER
WM. SEGLER
SMITH
CEMETERY
GEO. W. WHITE
D. G.
HOFFMAN
WEAVER & BETTS
H.E. CLARK ENCROACHMENT ON THE WILLIAM HUFFMAN TRACT OWNED BY THE CHESTNUT RIDGE COAL CO.
2.24 A. 1ST MINING × 4'-1" × 1613 × .96 = 1,518 GR. TONS
[1930 BLUE PRINT SHOWS ENCROACHMENT]
ACREAGE AND TONNAGE MINED FROM IKE TIGER TRACT BY H.E. CLARK AND HAULED THRU INDIANA No. 6 MINE AND DUMPED ON No. 6 TIPPLE.
COAL HT. FT/AC. FT. RECOVERY
1.89 A. 1ST MINING × 3'-6½" × 1613 × .96 = 12,365 GR. TONS
0.98 A. MINED OUT × 3'-6½" × 1613 × .75 = 4,199 " "
2.87 A. TOTAL 16,564 GR. TONS
MAP OF
INDIANA No. 6 MINE
OPERATED BY
CHESTNUT RIDGE COAL CO.
INDIANA COUNTY - PENNA.
1906
SCALE 1" = 100'
SURVEYED TO JUNE 29TH 1916
" " AUGUST 10TH 1917
REVISED TO JULY 8TH 1925
GEO. H. HYNES ENGINEER
PHILIPSBURG, PA.
REPRESENTS PILLAR COAL THAT CAN BE RECOVERED
REPRESENTS VIRGIN COAL THAT CAN BE RECOVERED
AS OF JULY 16 1925.
SEE ANALYSIS OF INDIVIDUAL TRACTS SHEET AS OF 7/16/1925
DISCLAIMER: This map is provided as a courtesy to the Pennsylvania Bureau of Deep Mine Safety by American Premier Underwriters, Inc. Office. The Pittsburgh Railroad Corporation and its subsidiary United Railroad Corp., which own or owned, but do not operate, the coal assets depicted hereon.
American Premier Underwriters, Inc. and United Railroad Corp. make no representations or warranties of any kind as to the accuracy or completeness of this map or its fitness for any particular mining, safety or real estate related purpose. Any person who uses this map for any reason undertakes an independent duty to verify its accuracy and completeness. Accordingly, all of the foregoing entities and American Premier Underwriters, Inc., United Railroad Corp. and their respective affiliates, shareholders, directors, officers and employees harmless from damage or liability arising from its use.