

Mulvihill Sub-sta.  
1-300 KVA Rectifier  
56'x60' x 12' deep  
From Pine No. 1 Tipples

PINE No. 1 - DIE SECTION  
Buildings 38'x40' 4830'  
from Pine No. 1 Tipples

Douglass Sub-Sta.  
1-300 KVA Rectifier

McDonnell Sub-Sta.  
1-300 KVA Motor Gen.

Inside Sub-Sta.  
1-300 KVA Rectifier


1350'± 200'± from Pine No. 1 Tipples

1550'± 875'± from Pine No. 1 Tipples

SARAH A. ROBERTS  
124.35 AC.

JOSEPH GLENN  
72.42 AC.

MARY K. GLENN  
0.21 AC. Sur.

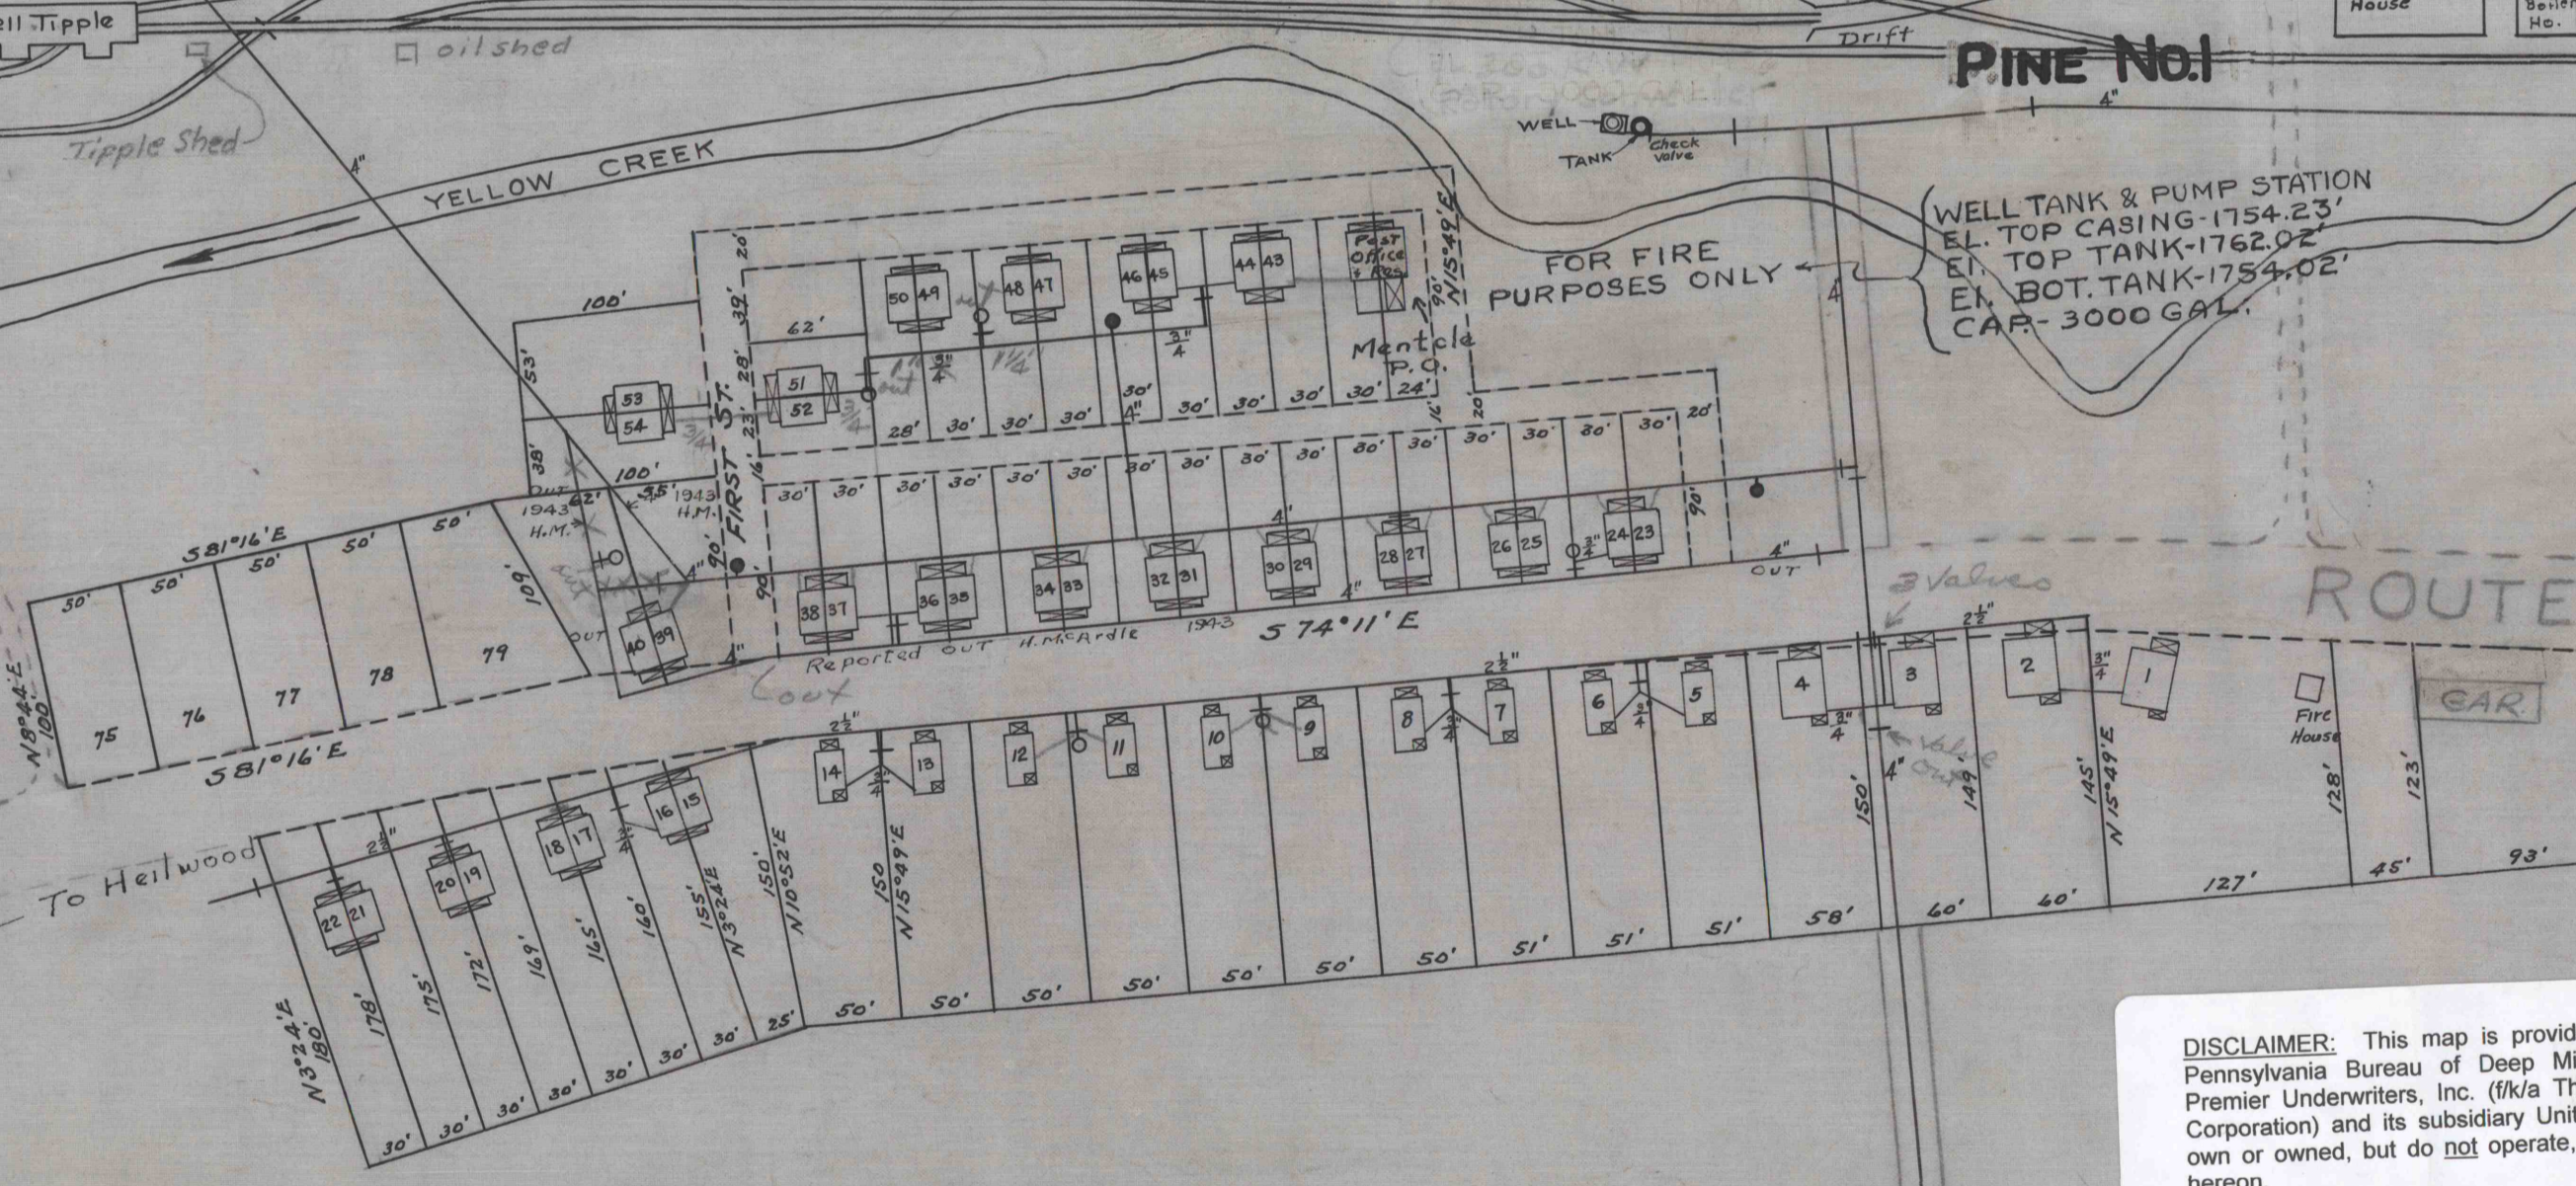



FOR FIRE PURPOSES ONLY  

S.B. GRIFFITH  
93.906 AC. Sur.

W. H. MARTIN  
183.83 AC.

ROBERT MITCHELL  
Fee 44.97 AC.

MAP SHOWING  
WATER LINES & SEWER LINES  
CLEMENT PLANT  
OF  
RED LANDS COAL CO.  
HEILWOOD DIVISION  
HEILWOOD IND. CO. PA.

SCALE 1"=100' DEC. 1929

LEGEND  
Water Lines (dashed)  
Sewer Lines (solid)  
Water Hydrant  
Fire Hydrant  
Cistern  
Deep Well

NAME OF TRACT	ACRES SOLD TENNSITE	ACRES RESERVED TENNSITE	ACRES PLANT SITE	ACRES TOTAL
S.B. GRIFFITH	6.90	2.38	17.20	26.48
ROBERT MITCHELL			10.19	10.19
MARY K. GLENN			0.21	0.21
GRAND TOTALS	6.90	2.38	27.60	36.88