


NO. 3

DISCLAIMER: This map is provided as a courtesy to the Pennsylvania Bureau of Deep Mine Safety by American Corporation and its subsidiary United Railroad Corporation. American Premier Underwriters, Inc. and United Railroad Corp. disclaim any representation or duty to any person as to the accuracy or completeness of this map or its fitness for any particular mining, safety or other purpose. Any person who uses this map for any reason understands and assumes all risks of its use, and agrees to hold American Premier Underwriters, Inc., United Railroad Corp. and their respective affiliates, shareholders, directors, officers and employees harmless from damage or liability arising from its use.

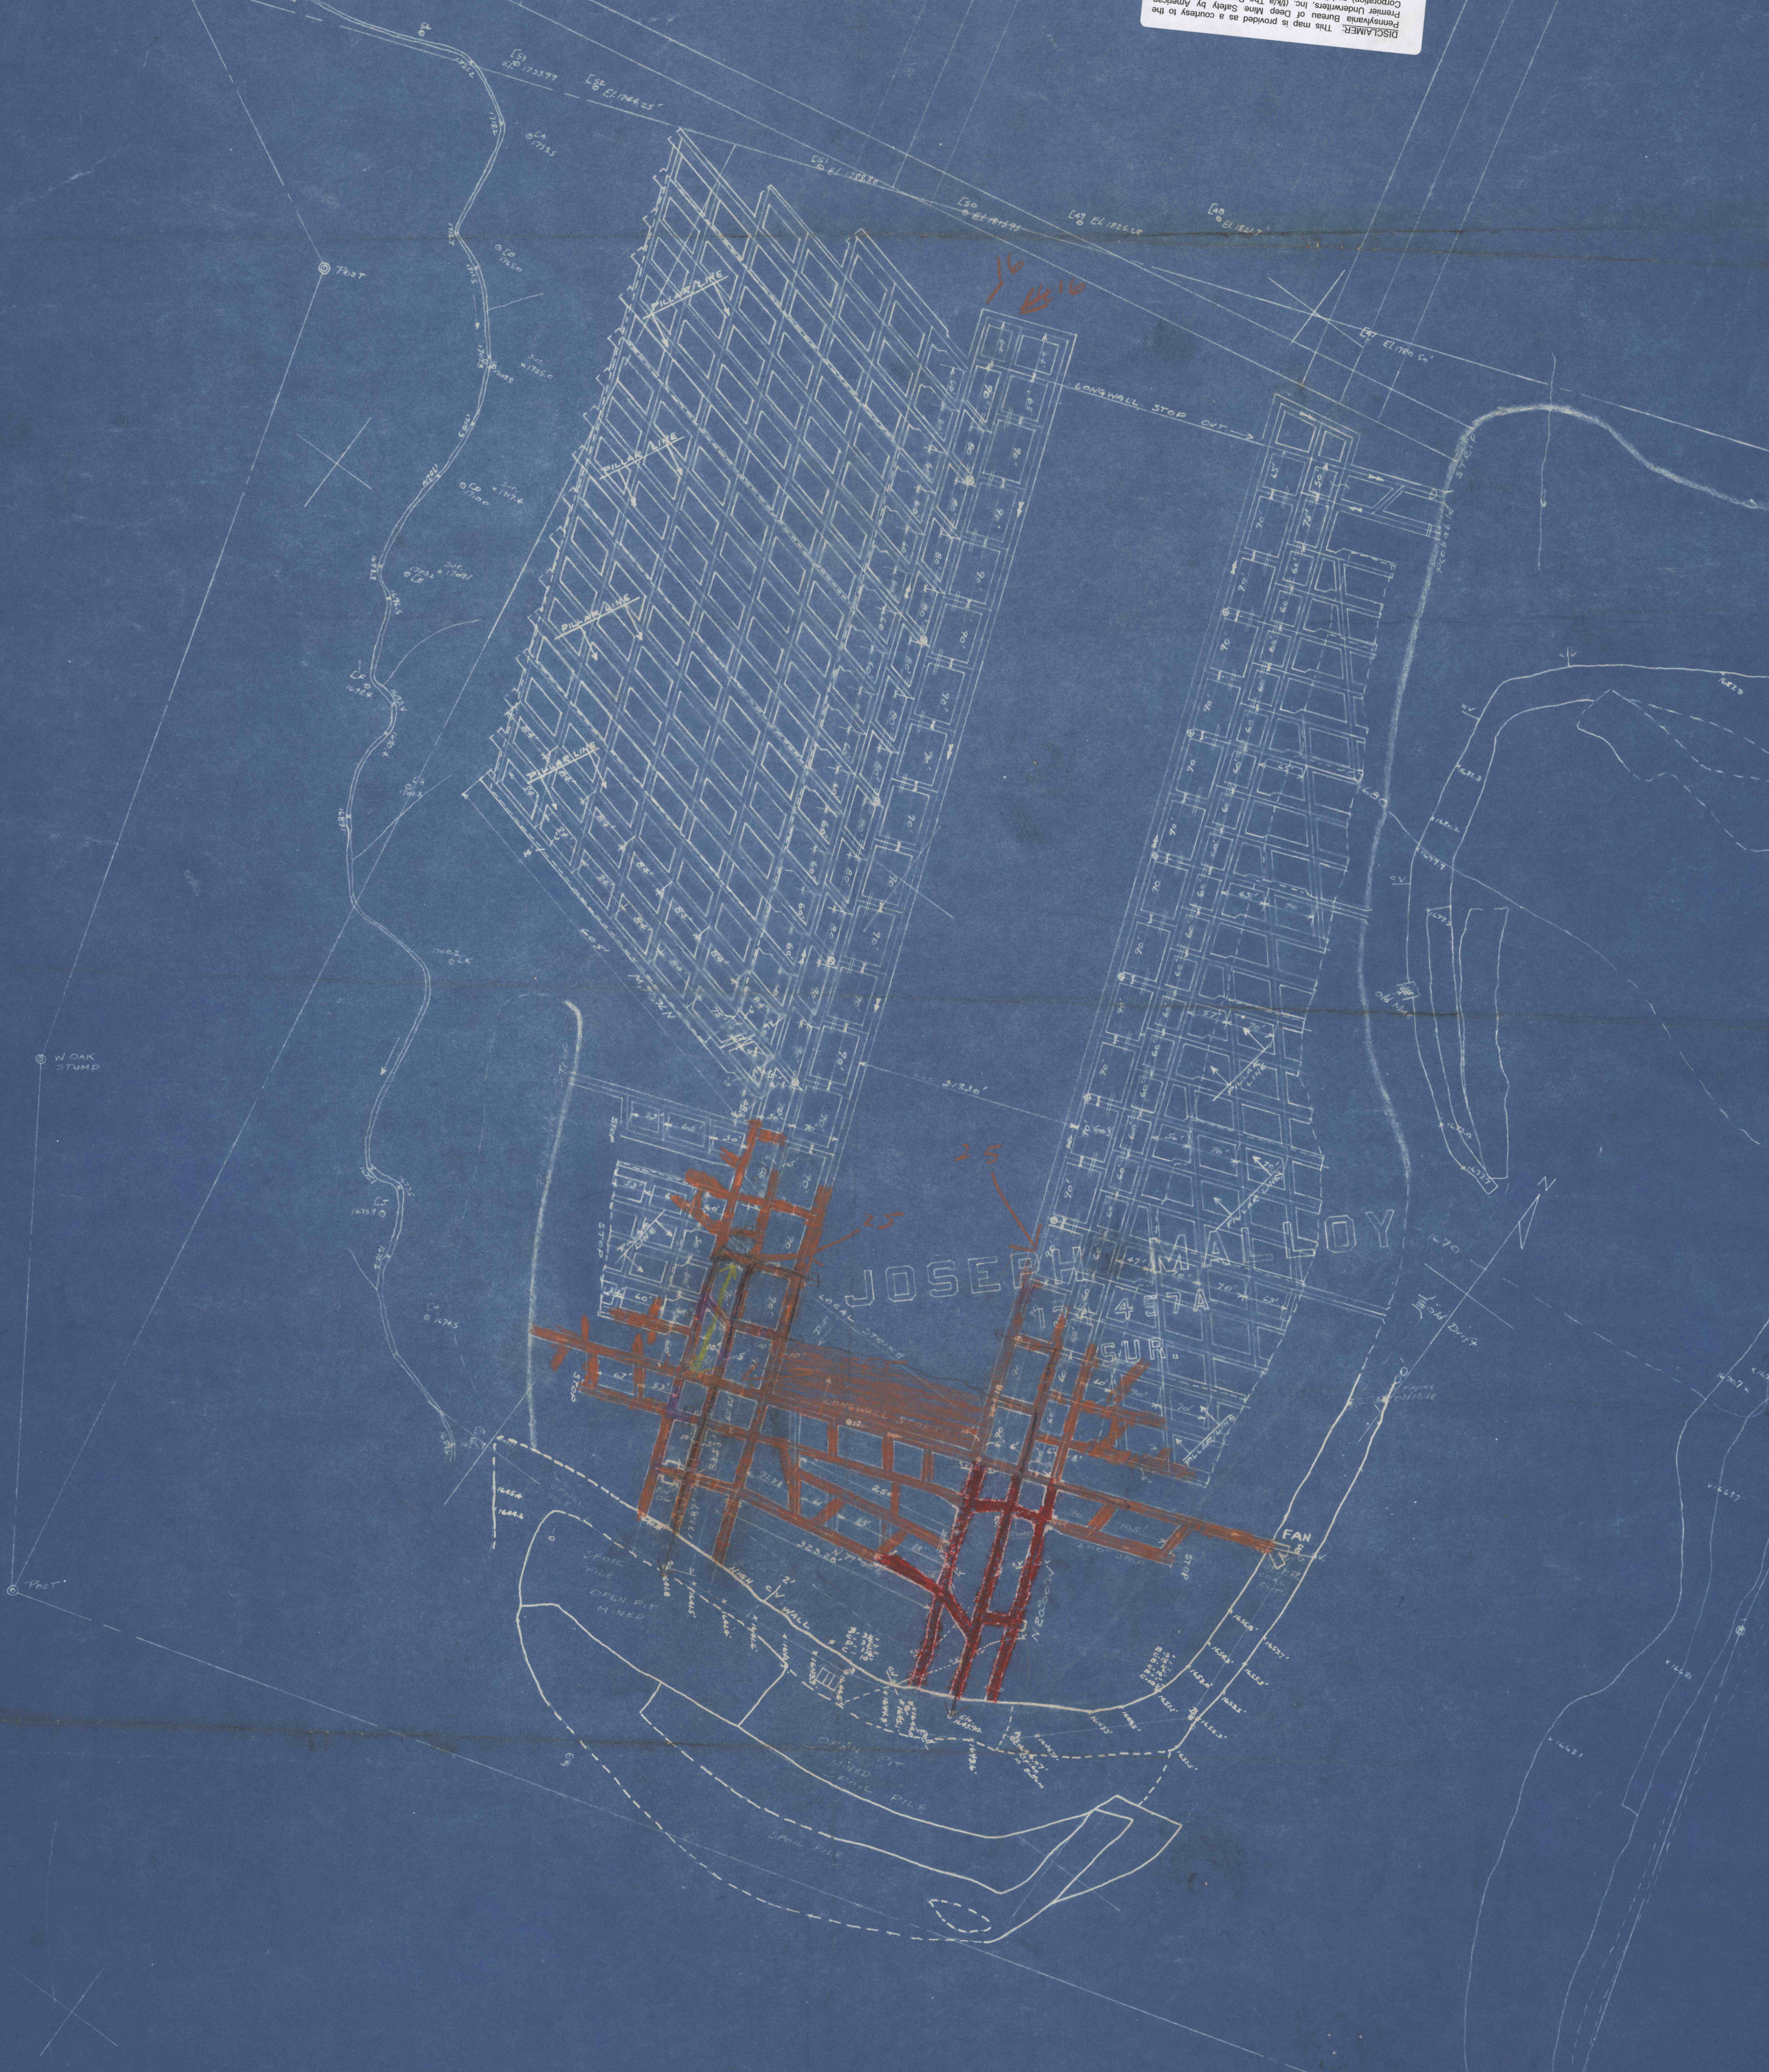

PINE TWP COAL CO., INC.  
HELLWOOD PA  
PROJECTIONS FOR HIGHWALL  
MECHANICAL MINING  
Date - 8-2-59  
Scale - 1" = 100'  
REVISED - 10-15-59

*Do Not Destroy  
This was last Map  
Marked by Foreman at  
wall at mine*