


LINETREE
BLAZED SIGN
STOPS

APPROX 1ST
NOT LOCATED

DEEP
APPROX 1ST
NOT LOCATED

Old Turnway

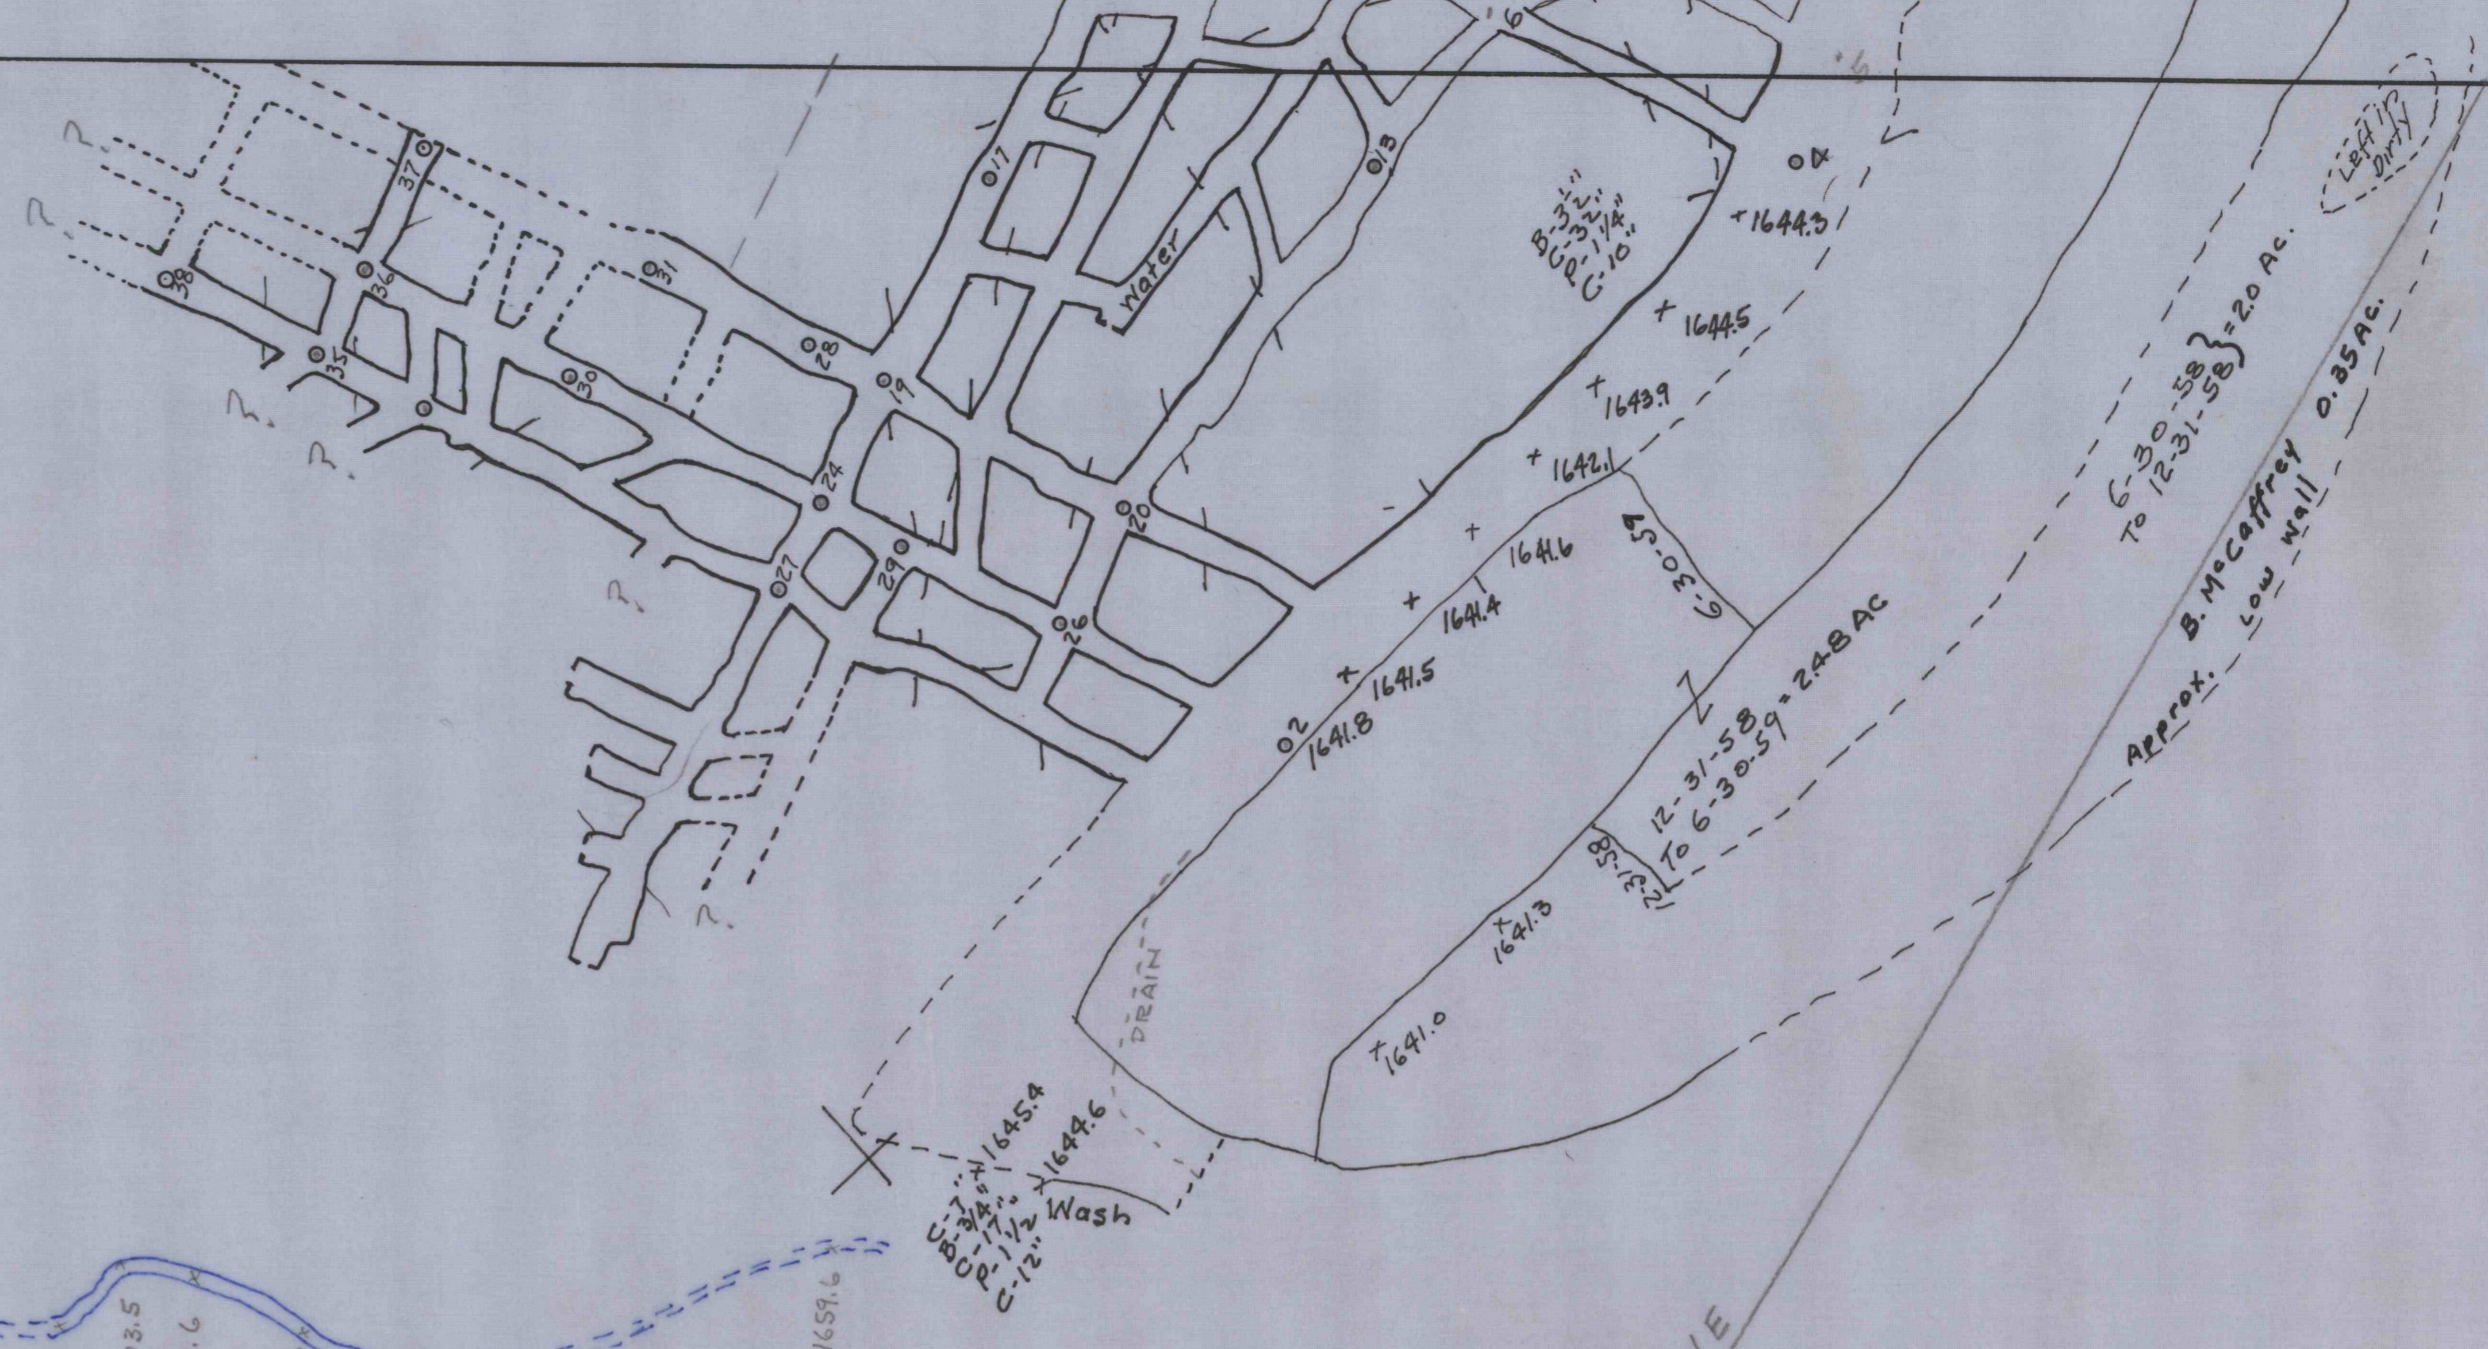

APPROX LINE

APPROX. 200 AC
TO MICHAEL'S
APPROX. LOW WALL

X

X

X

X

X