



H 12

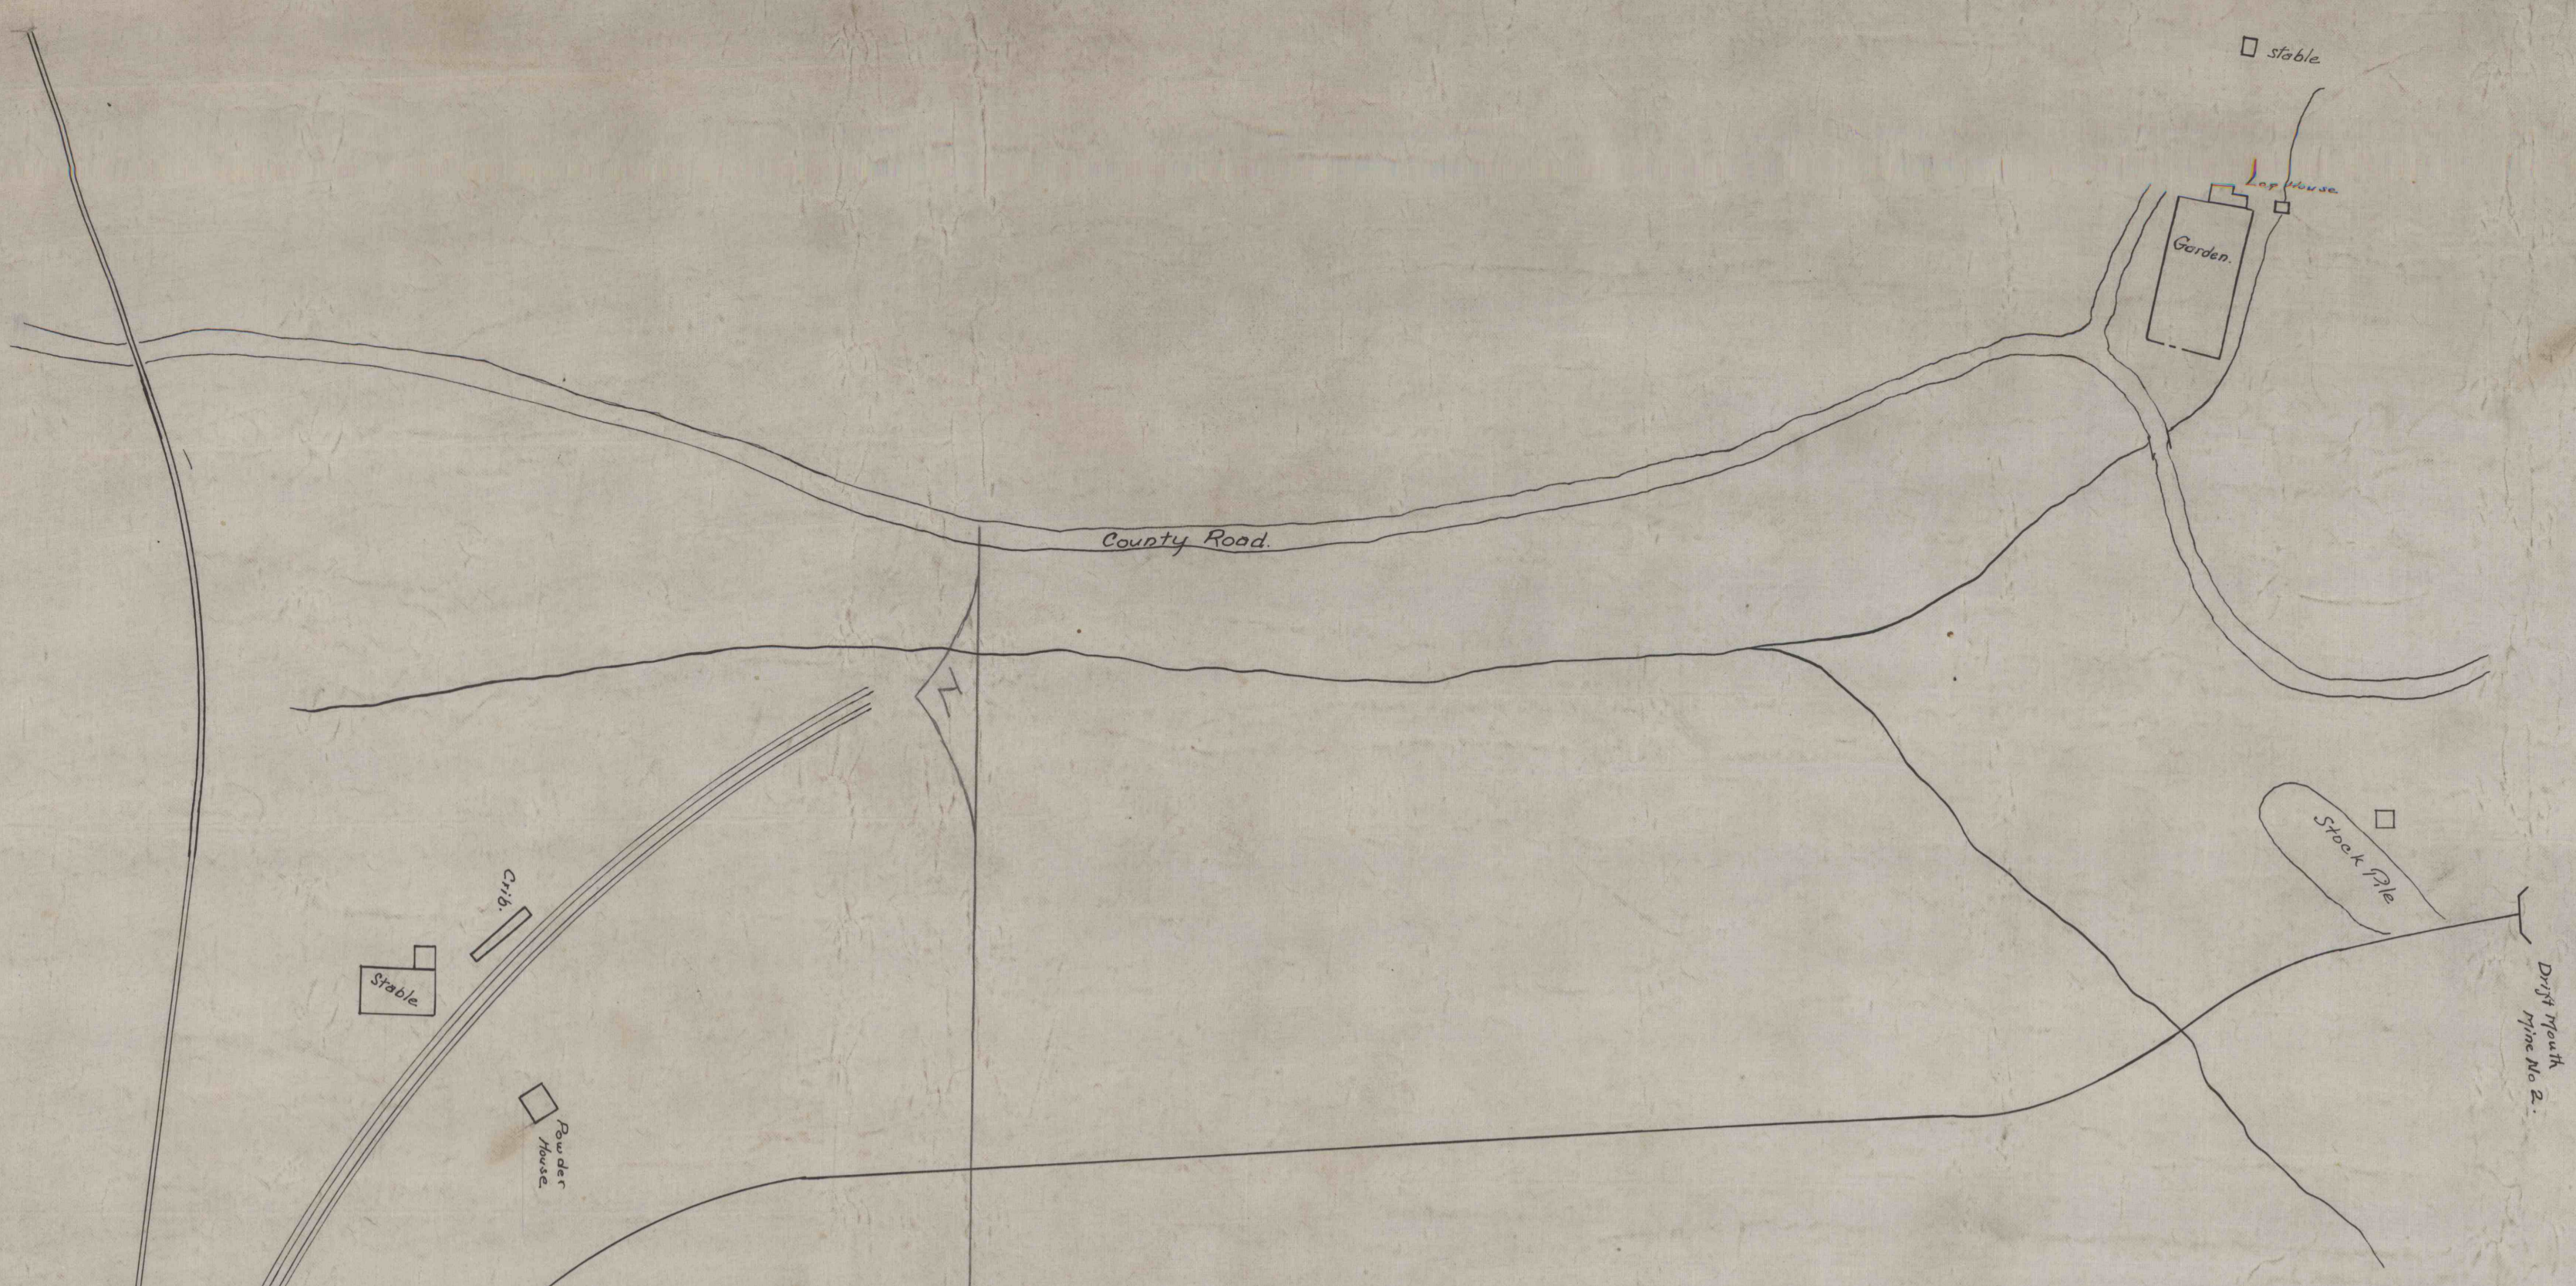


MAP
 of
 HOUSES AT
 Mine No. 1,
 Dixonville Pa.
 June 20, 1907
 H. S. KENNEDY
 Scale
 100' = 1"

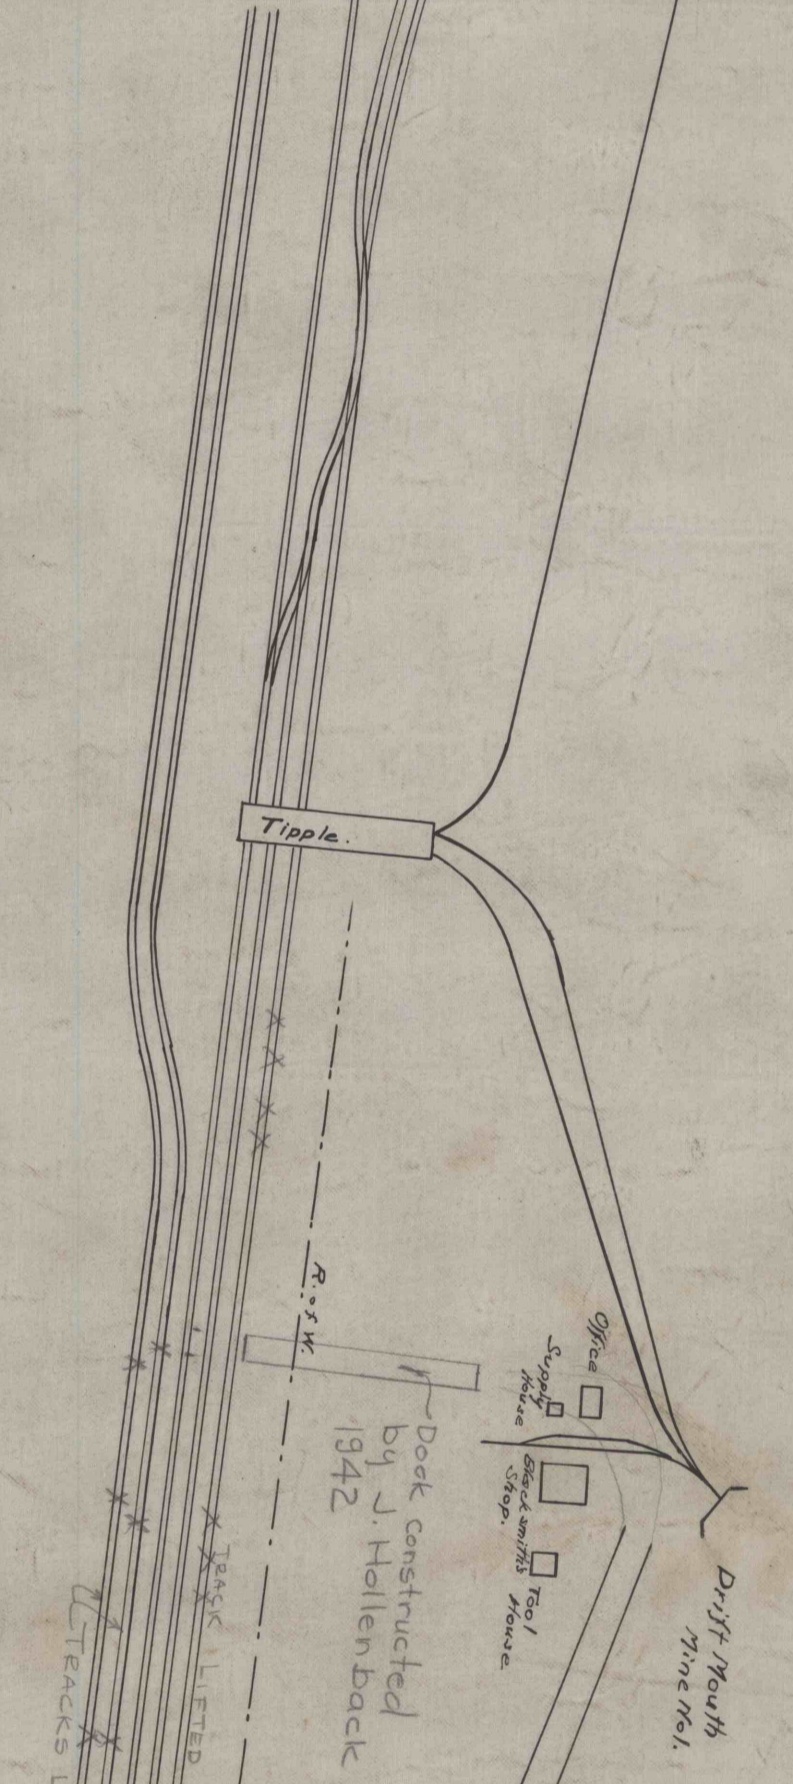

380' To
 Corral Location
 Paper
 Tack

380' To
 Ox Stand

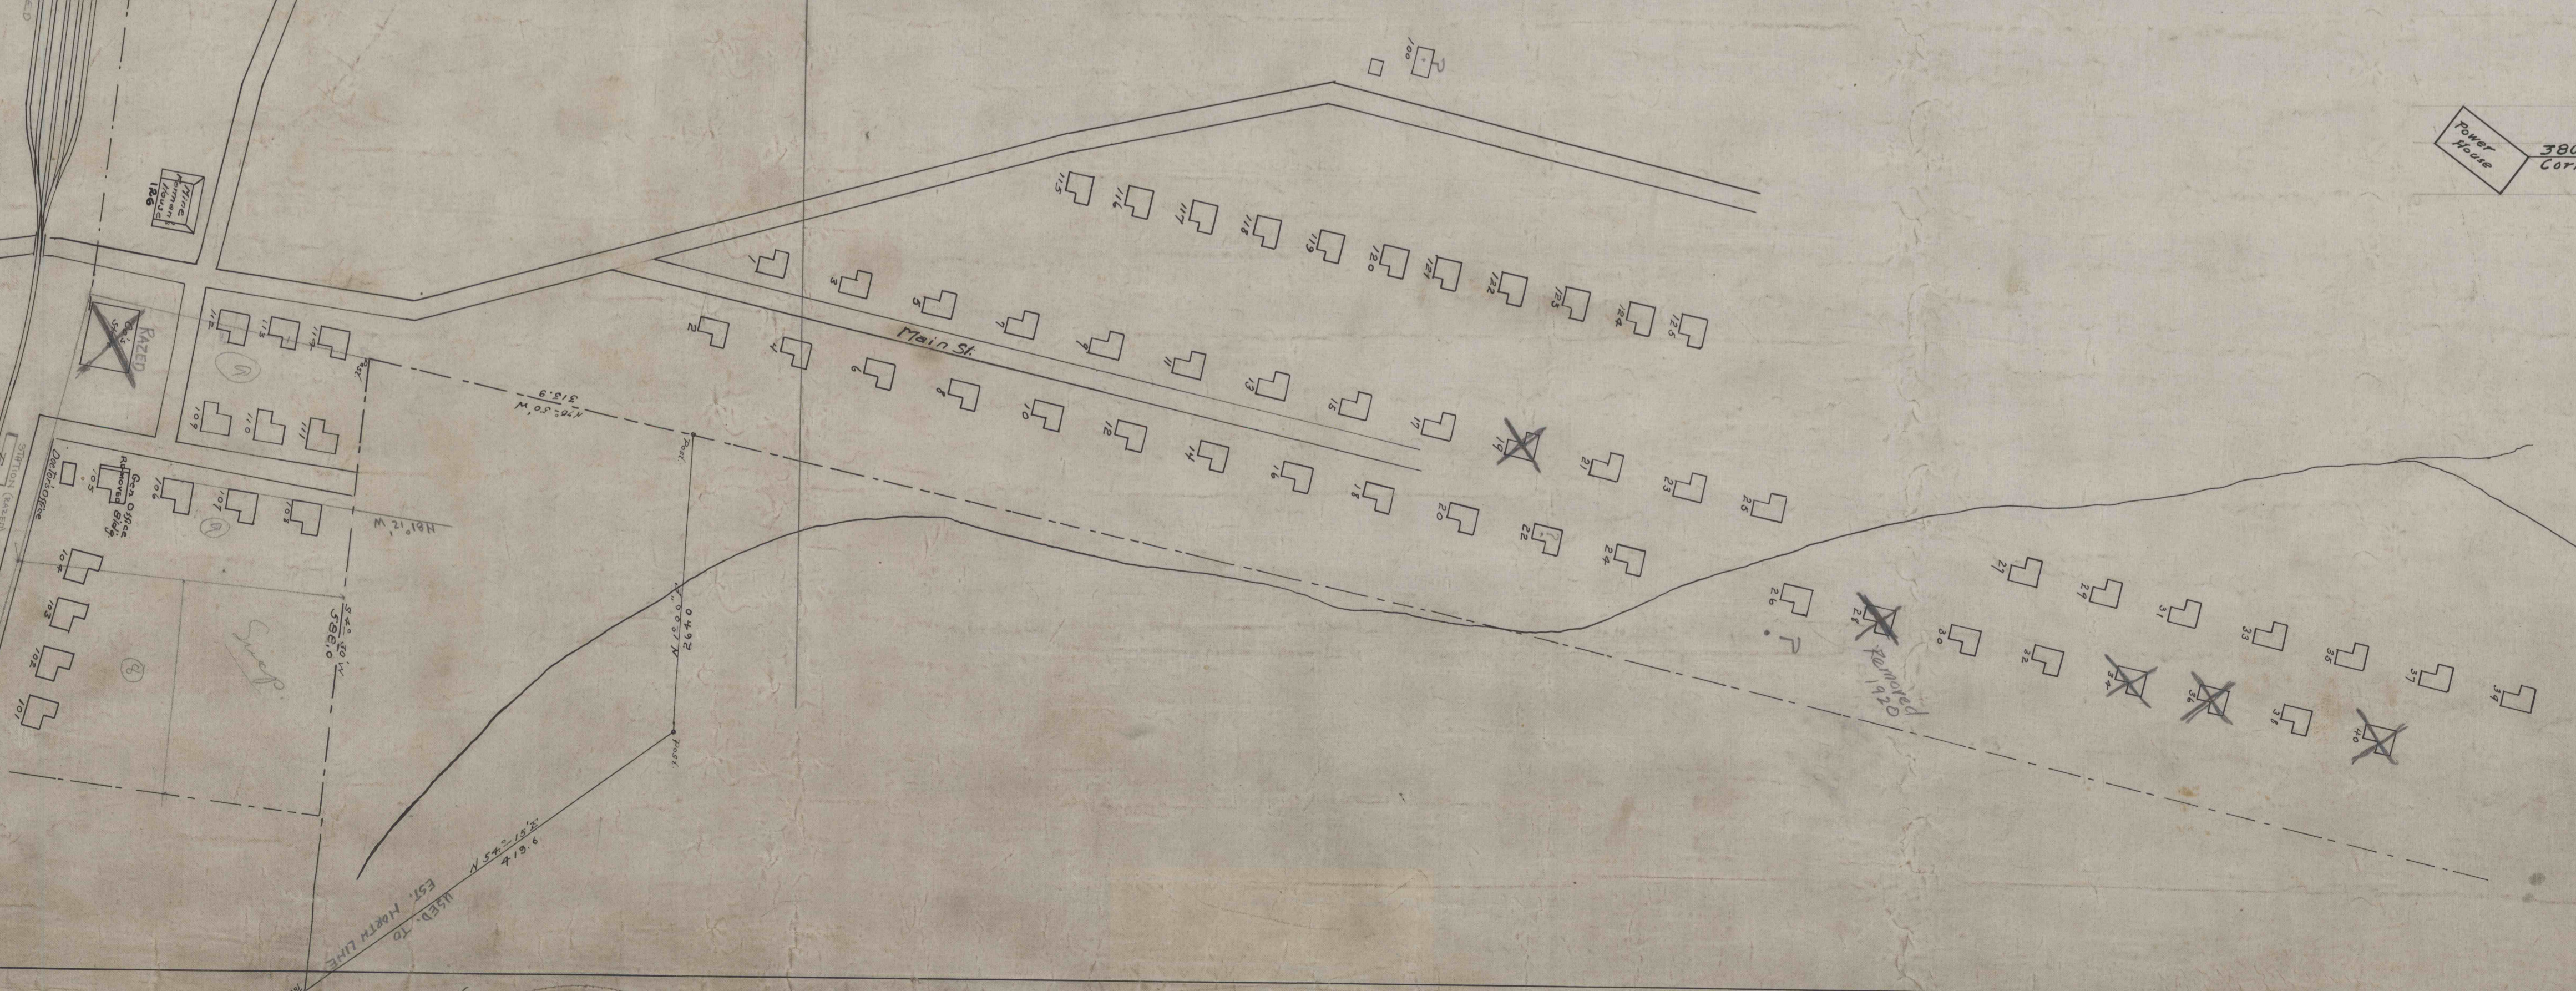

FILE (A) 105
 D.A. 2-408