



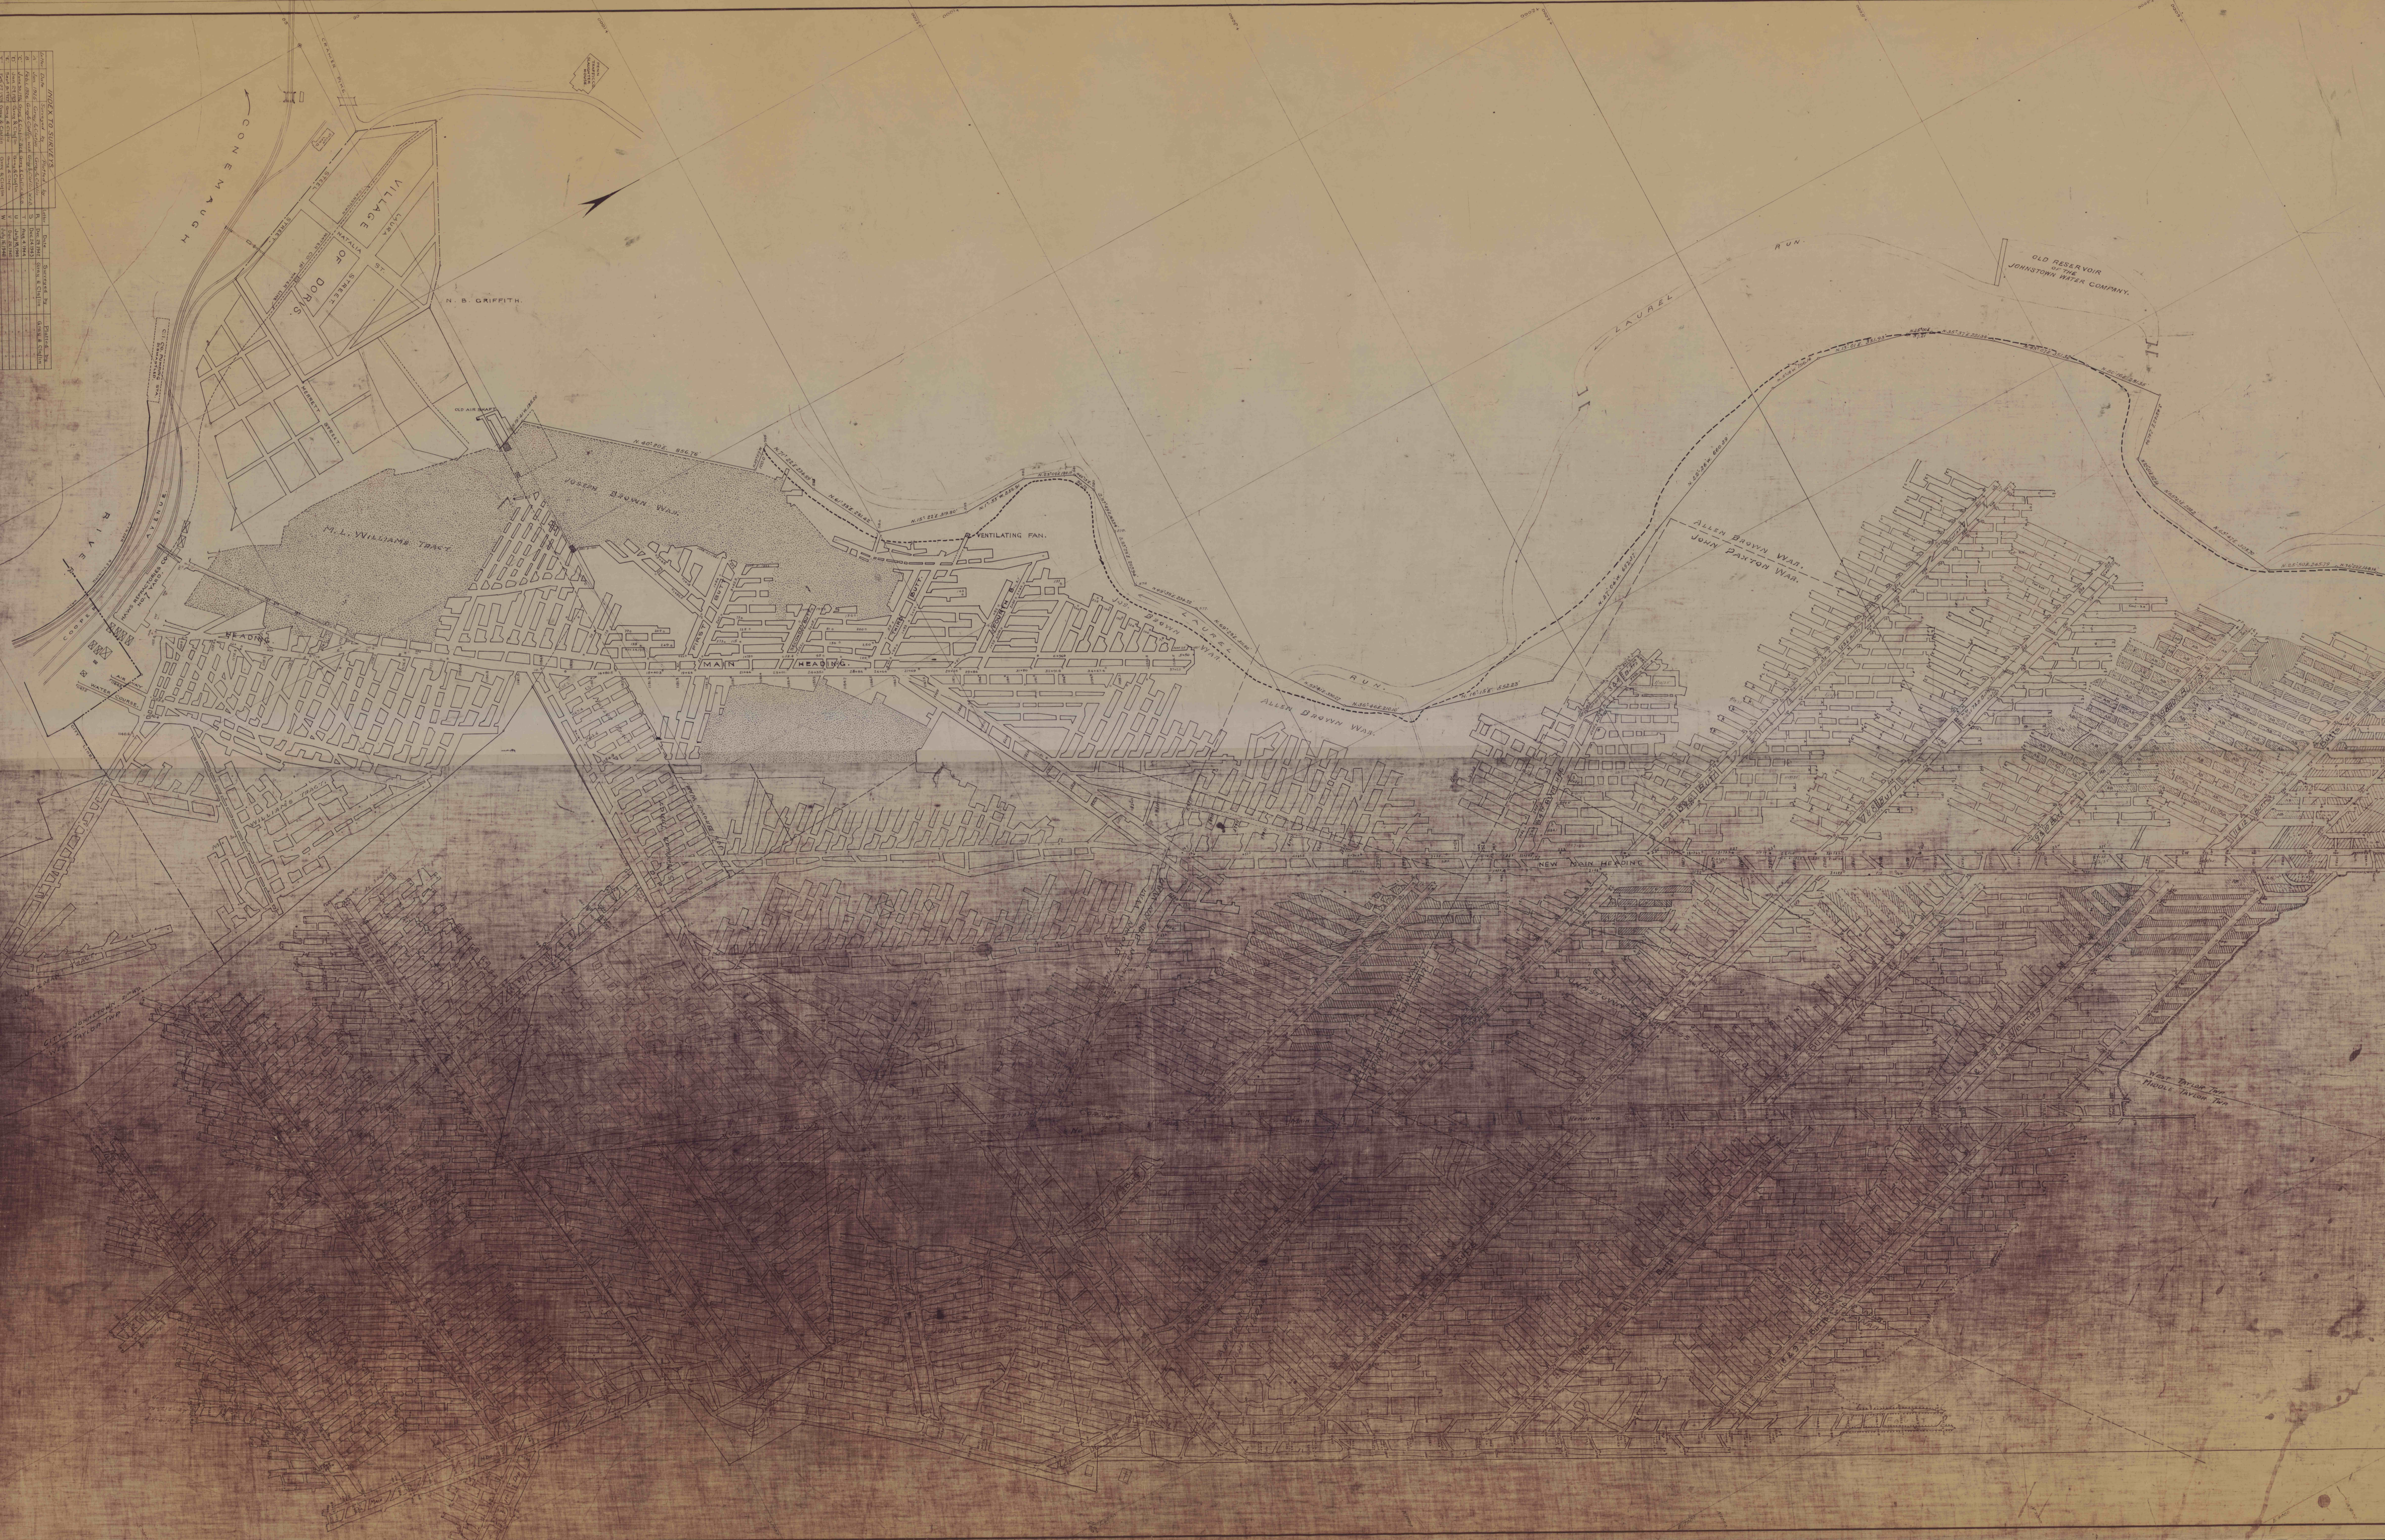

OLD RESERVOIR OF THE JOHNSTOWN WATER COMPANY

CONEMOUGH RIVER


N. B. GRIFFITH


VENTILATING FAN

ALLEN BROWN WAR.


LAUREL

NEW MAIN HEADING

