


129-53
NOTE: COAL DROPS FROM BINDER
BY FINE ROCK PUSHES UP WHEN CUT

MARY JONES

ELIZABETH REESE

ISAAC

MAHAN

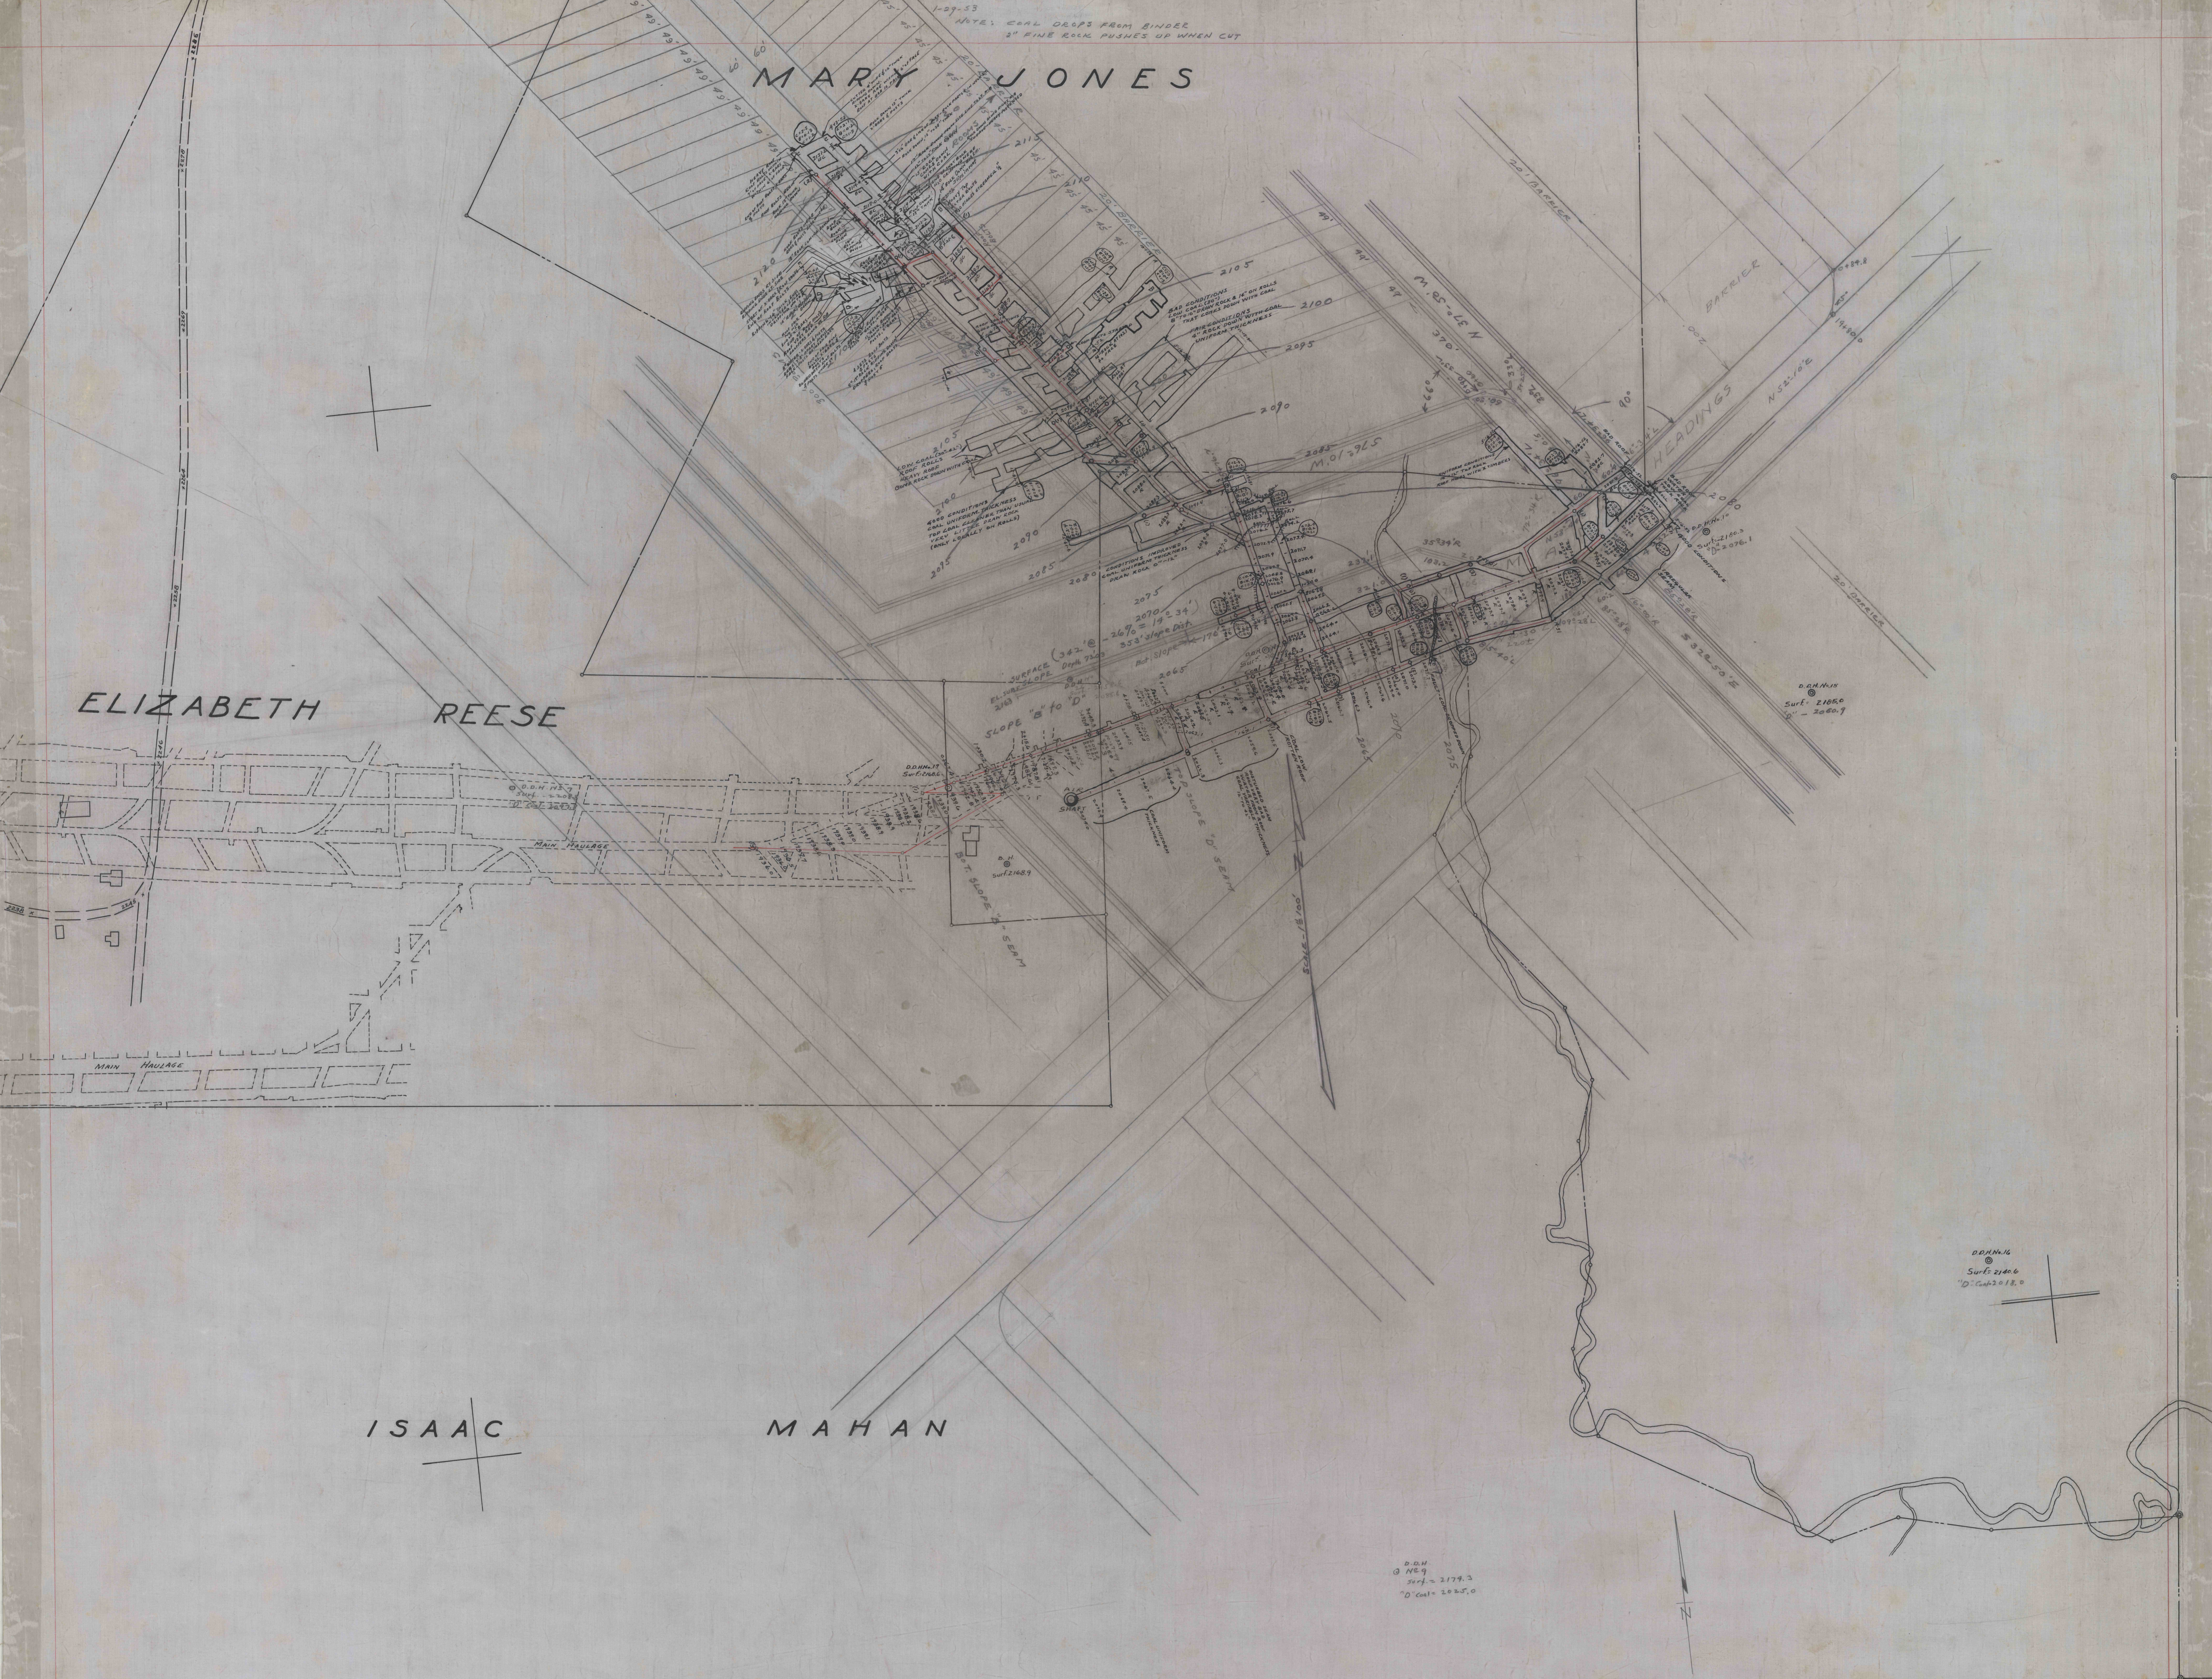

A	10-1-52
B	12-1-52
C	4-1-53
D	8-26-53

MAP SHOWING
"D" SEAM MINING OPERATIONS
OF
IMPERIAL CARDIFF COAL COMPANY
SITUATE IN
BLACKLICK & CAMBRIA TOWNS, CAMBRIA CO. PA.
SCALE - 1" = 100' JULY 13, 1949
FETTERMAN ENGR. CO.

D.D.M.
112
Surf. 2179.3
D. Cont. 2025.0

D.D.M. 113
Surf. 2186.0
D. Cont. 2018.0