


C-203

390

380

370

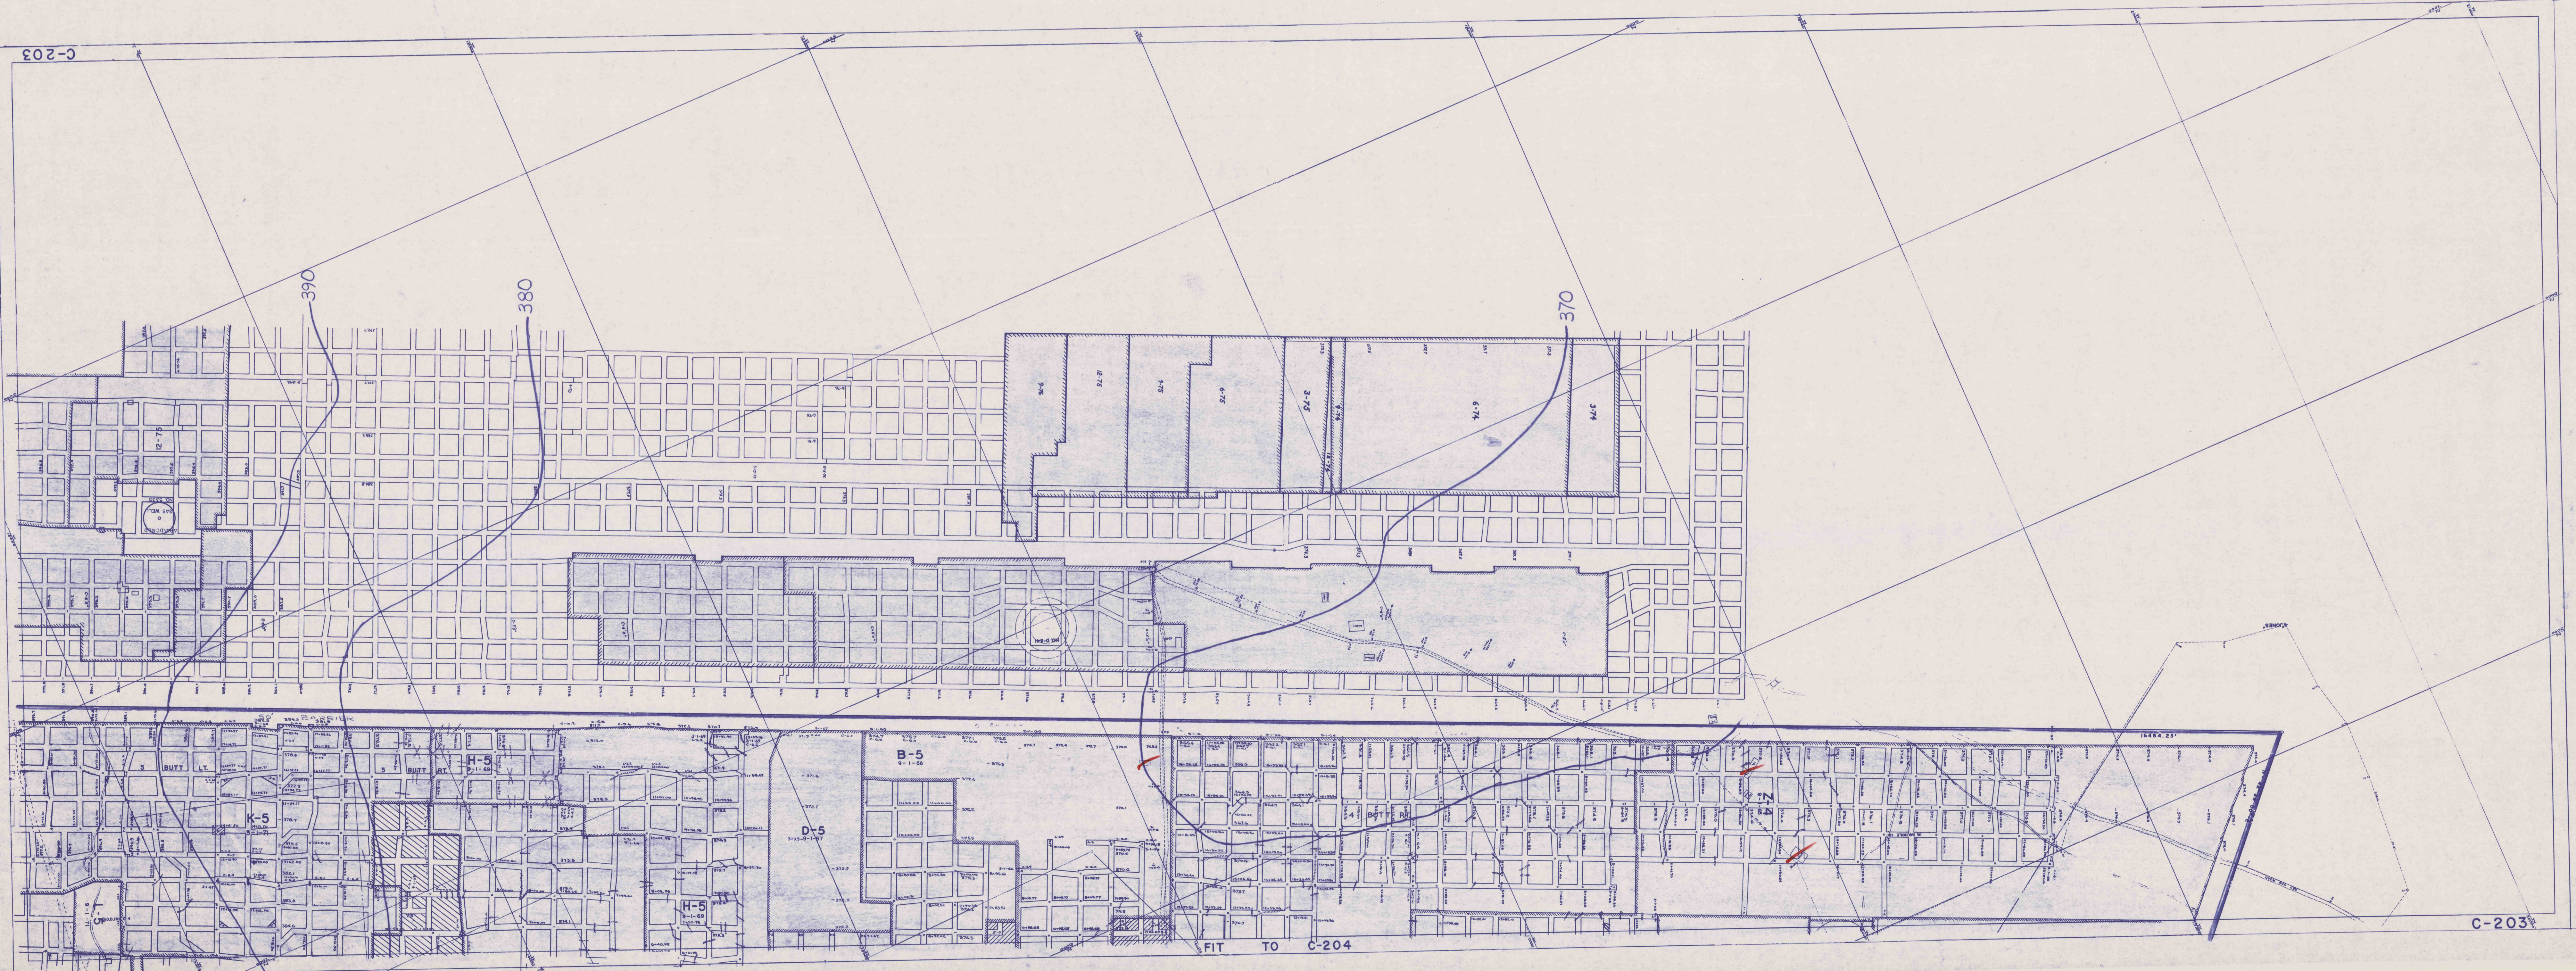

FIT TO C-204

C-203