


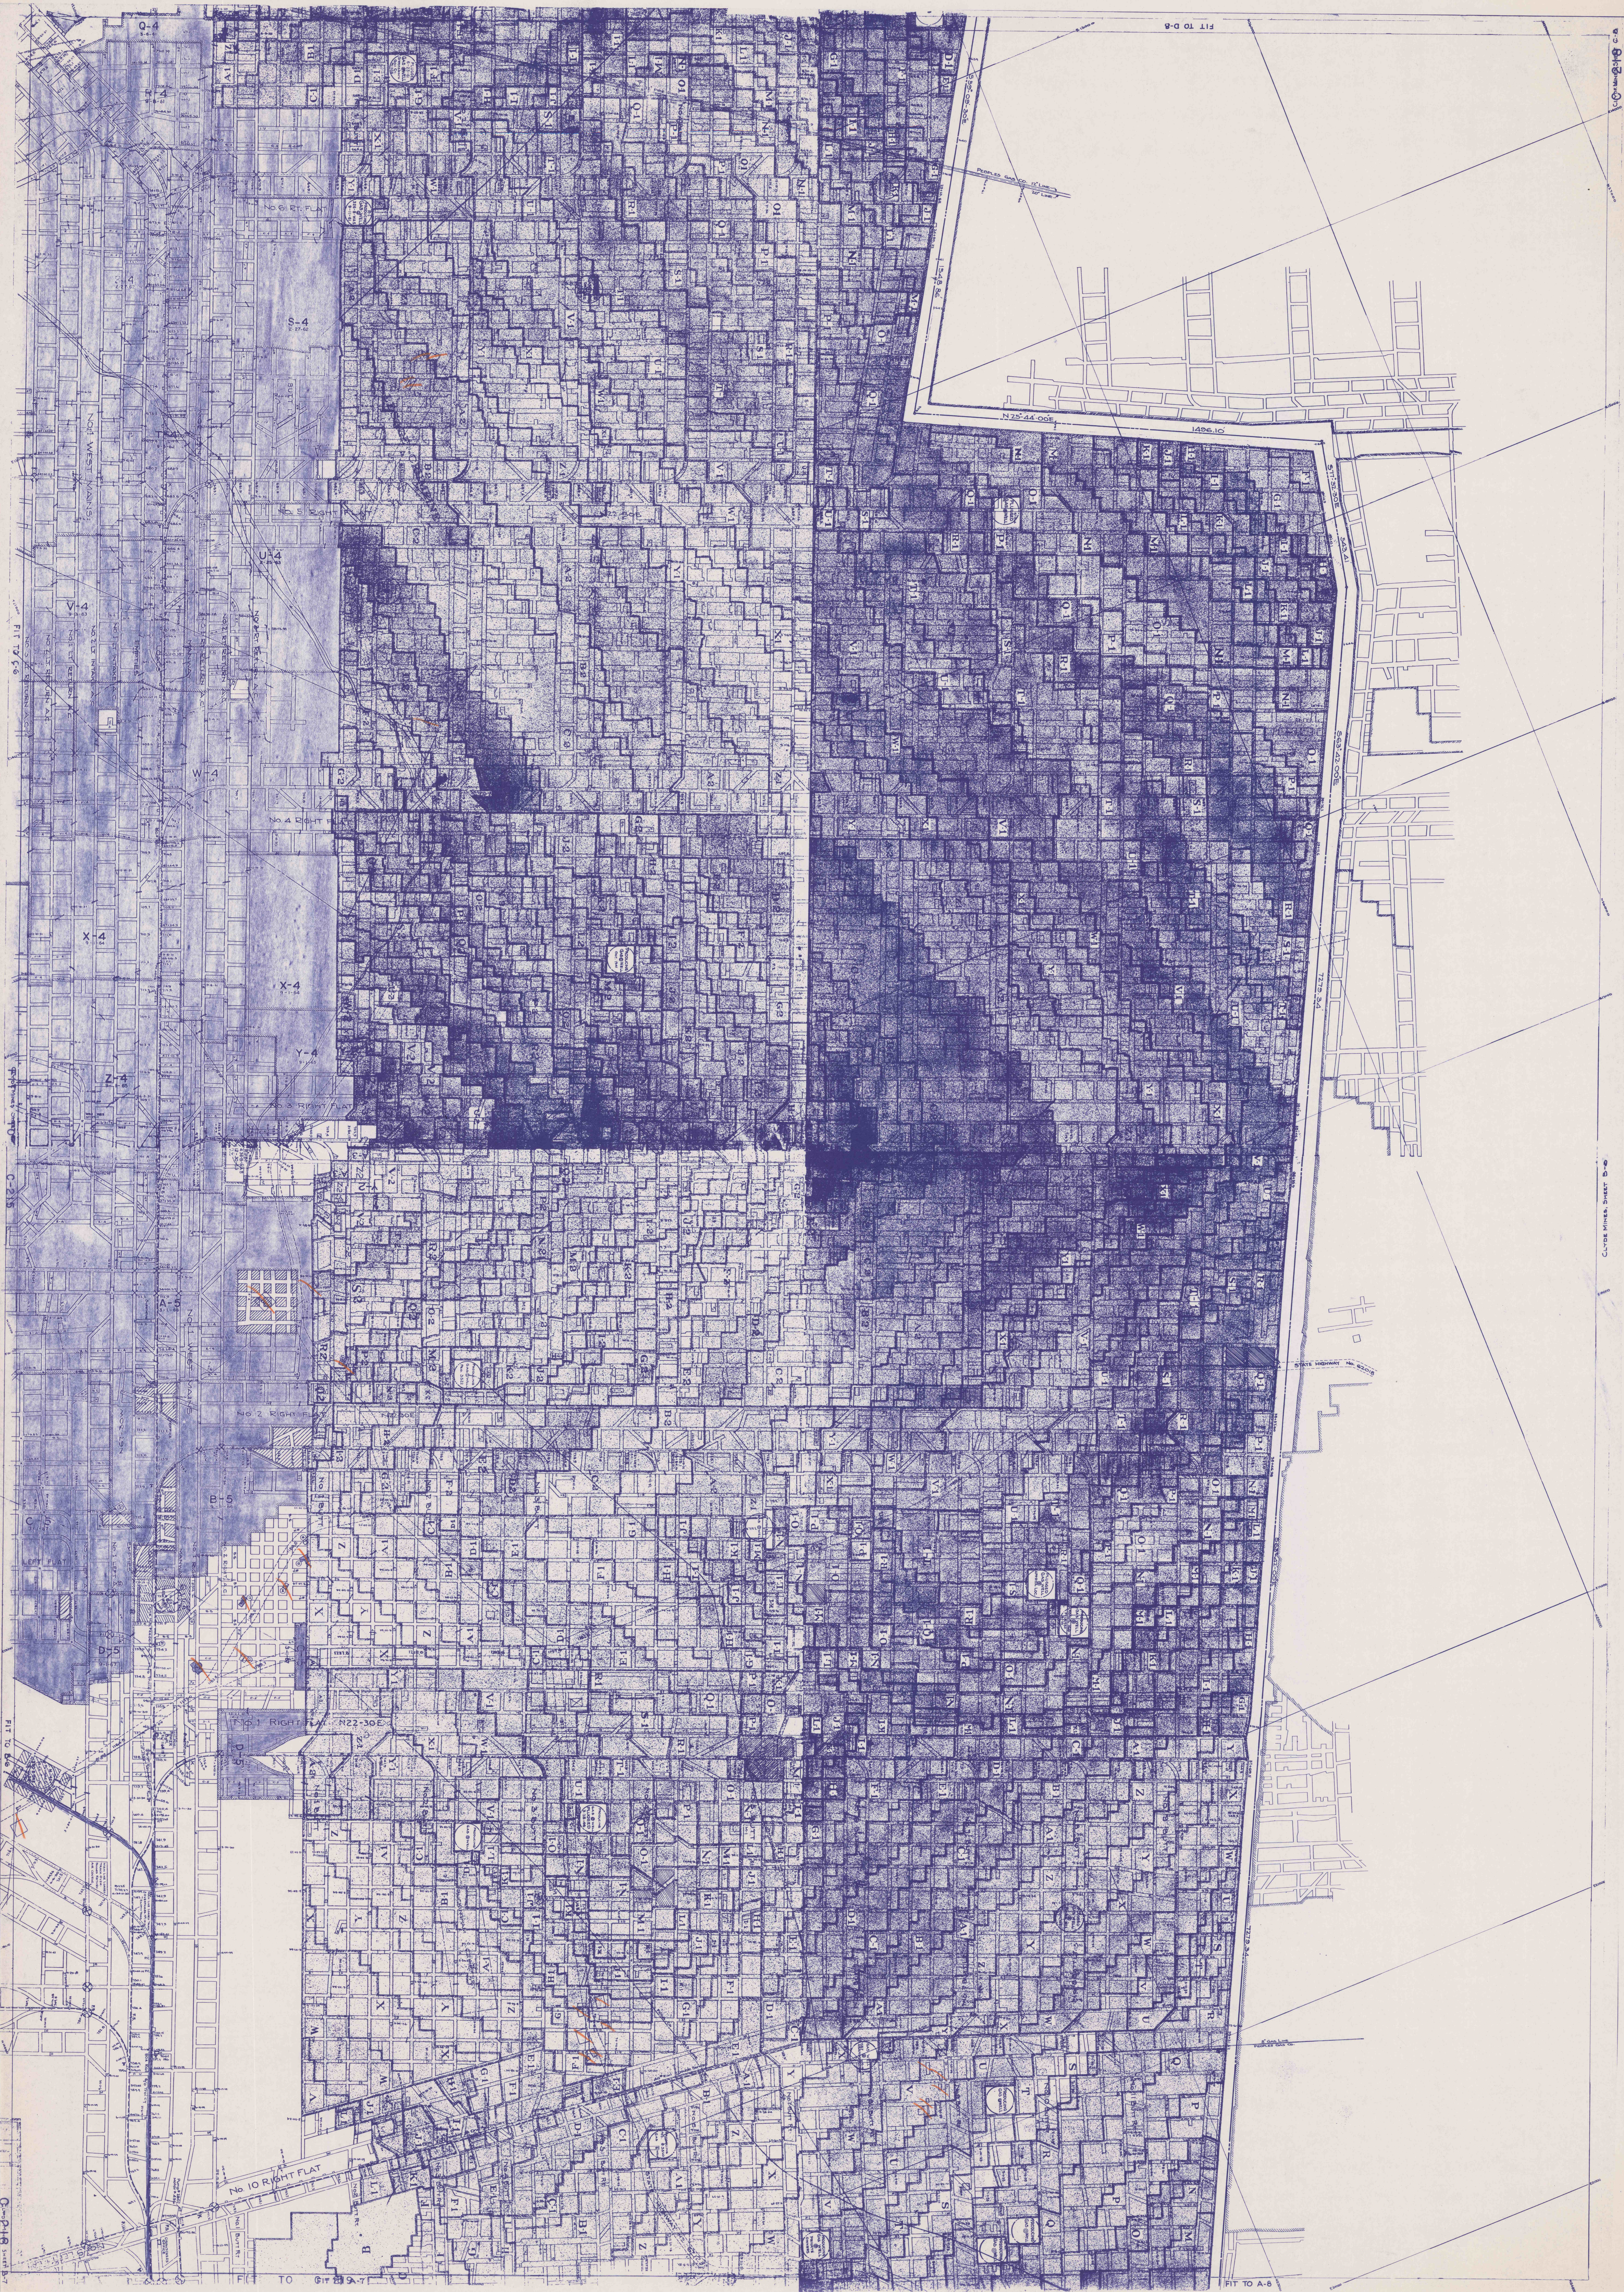

10-21-18


10-21-18