


N. 21

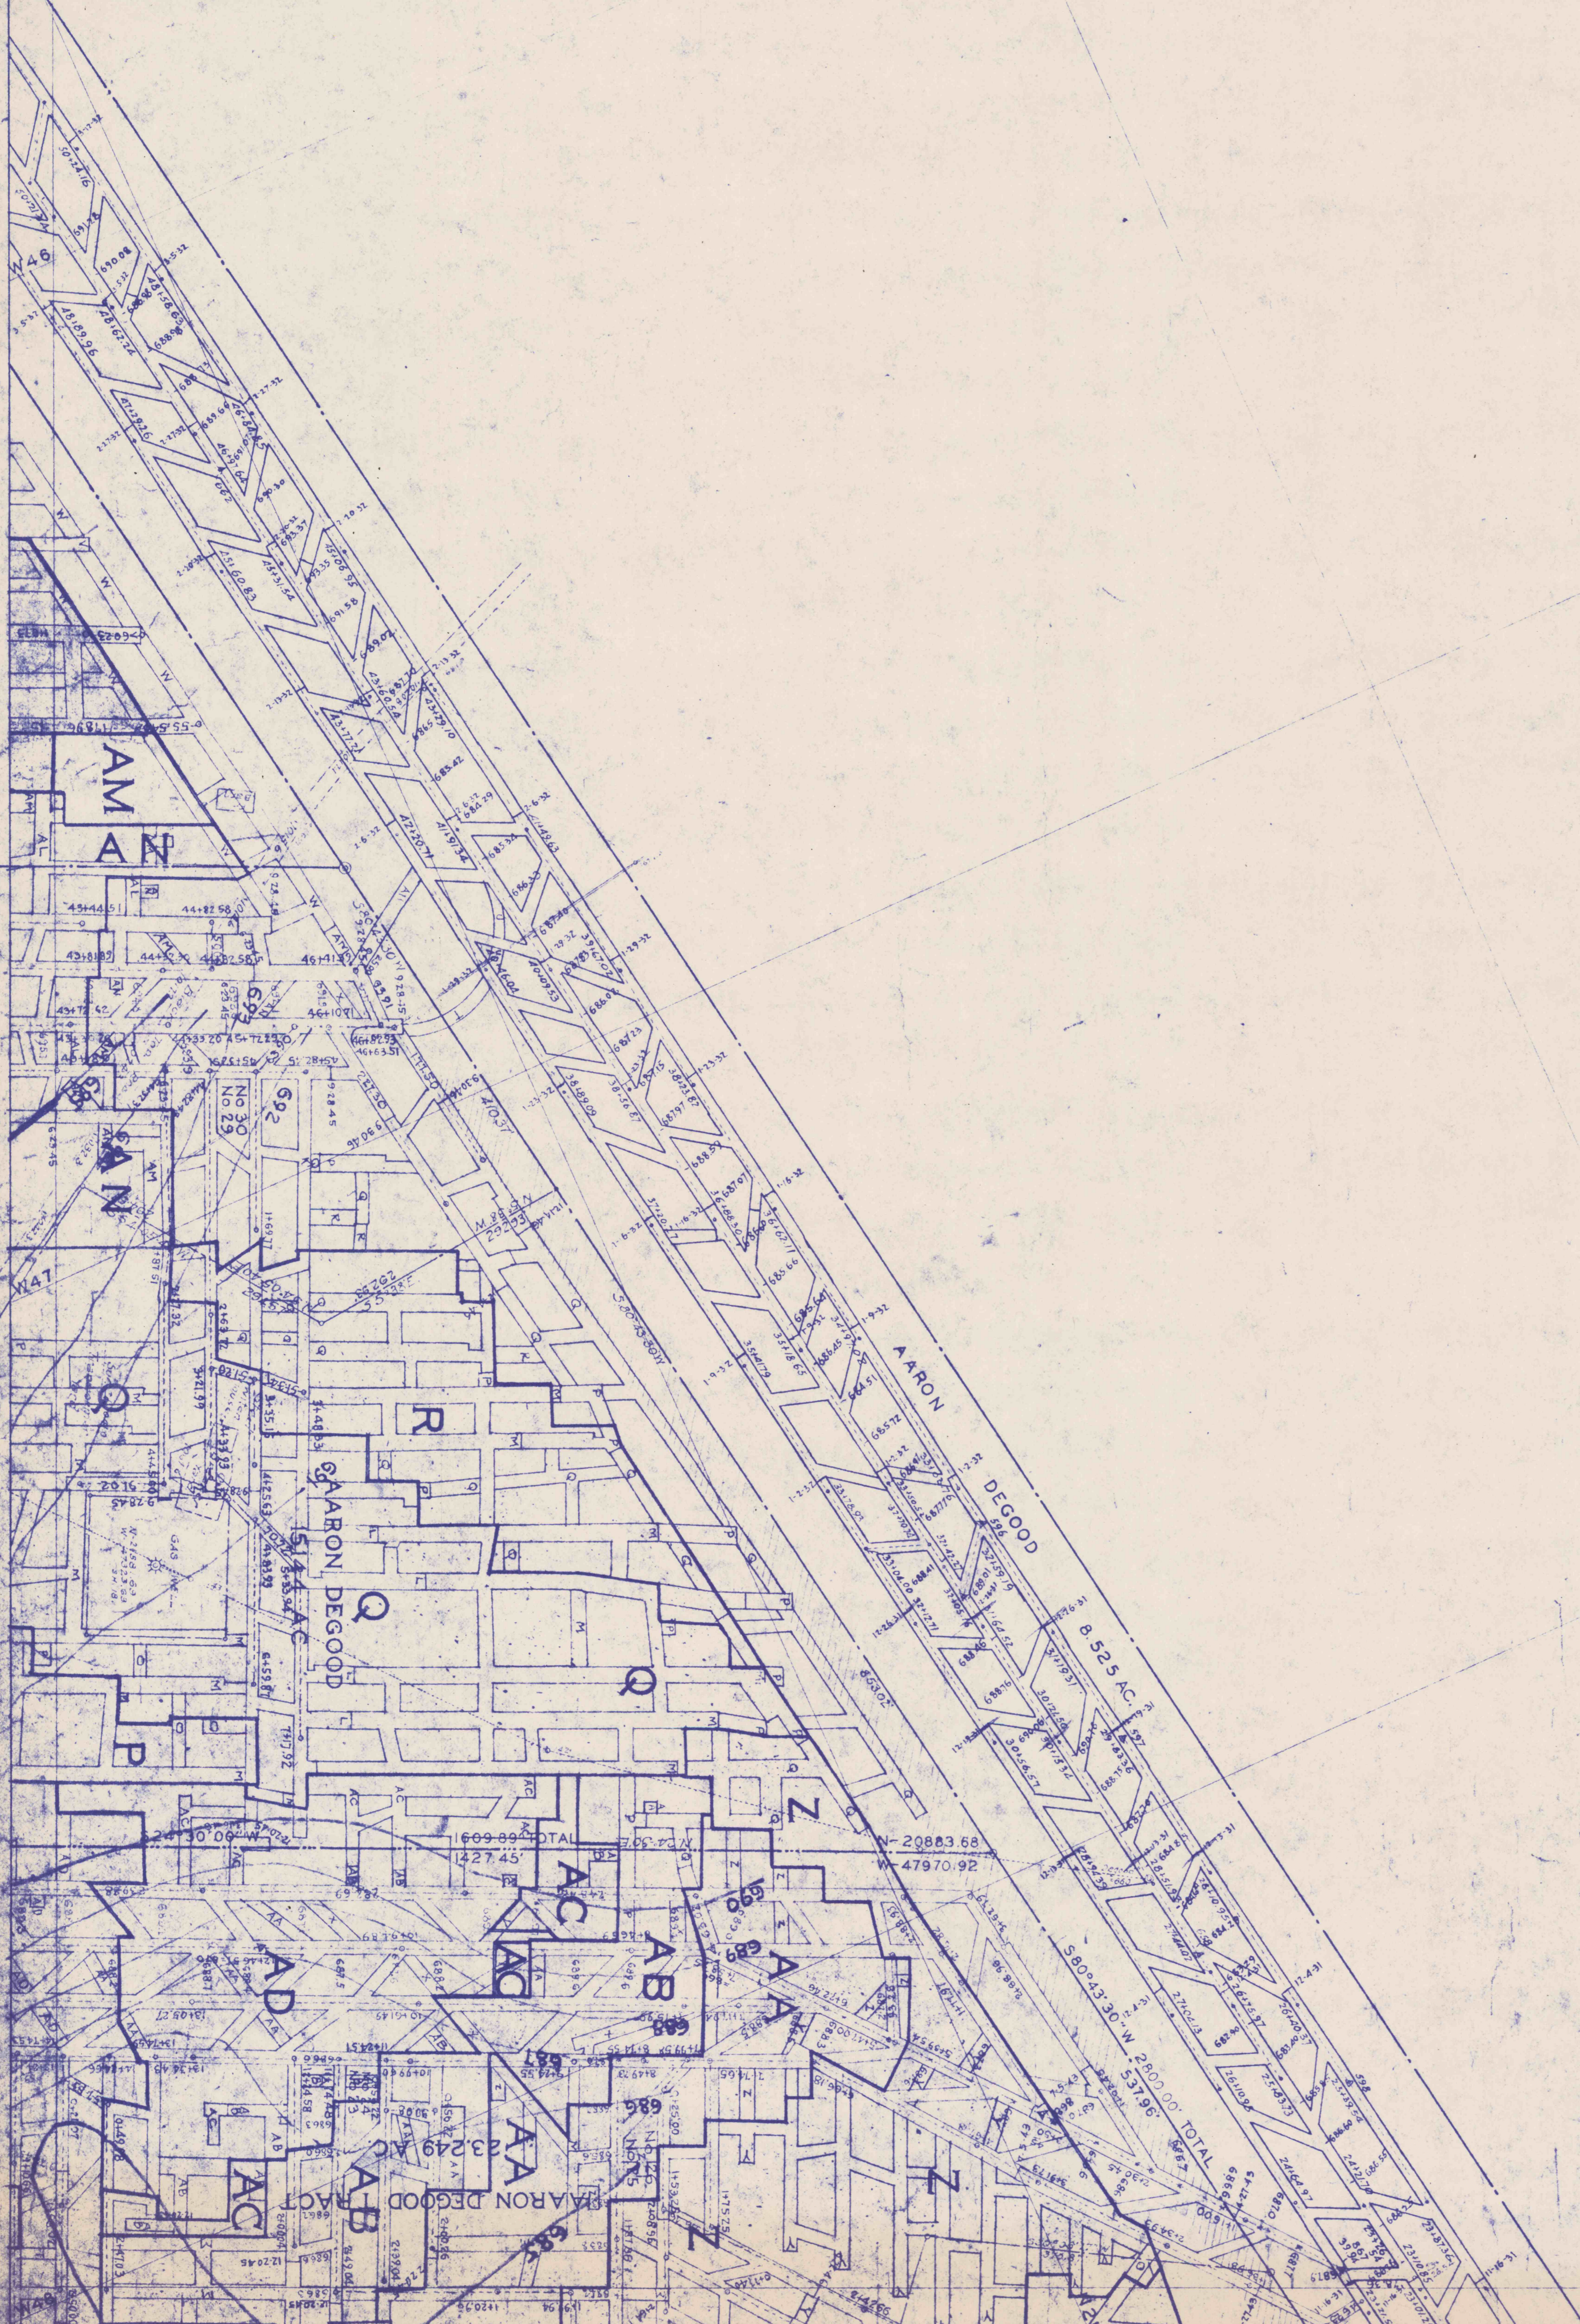

N. 20

W. 49

FIT TO I