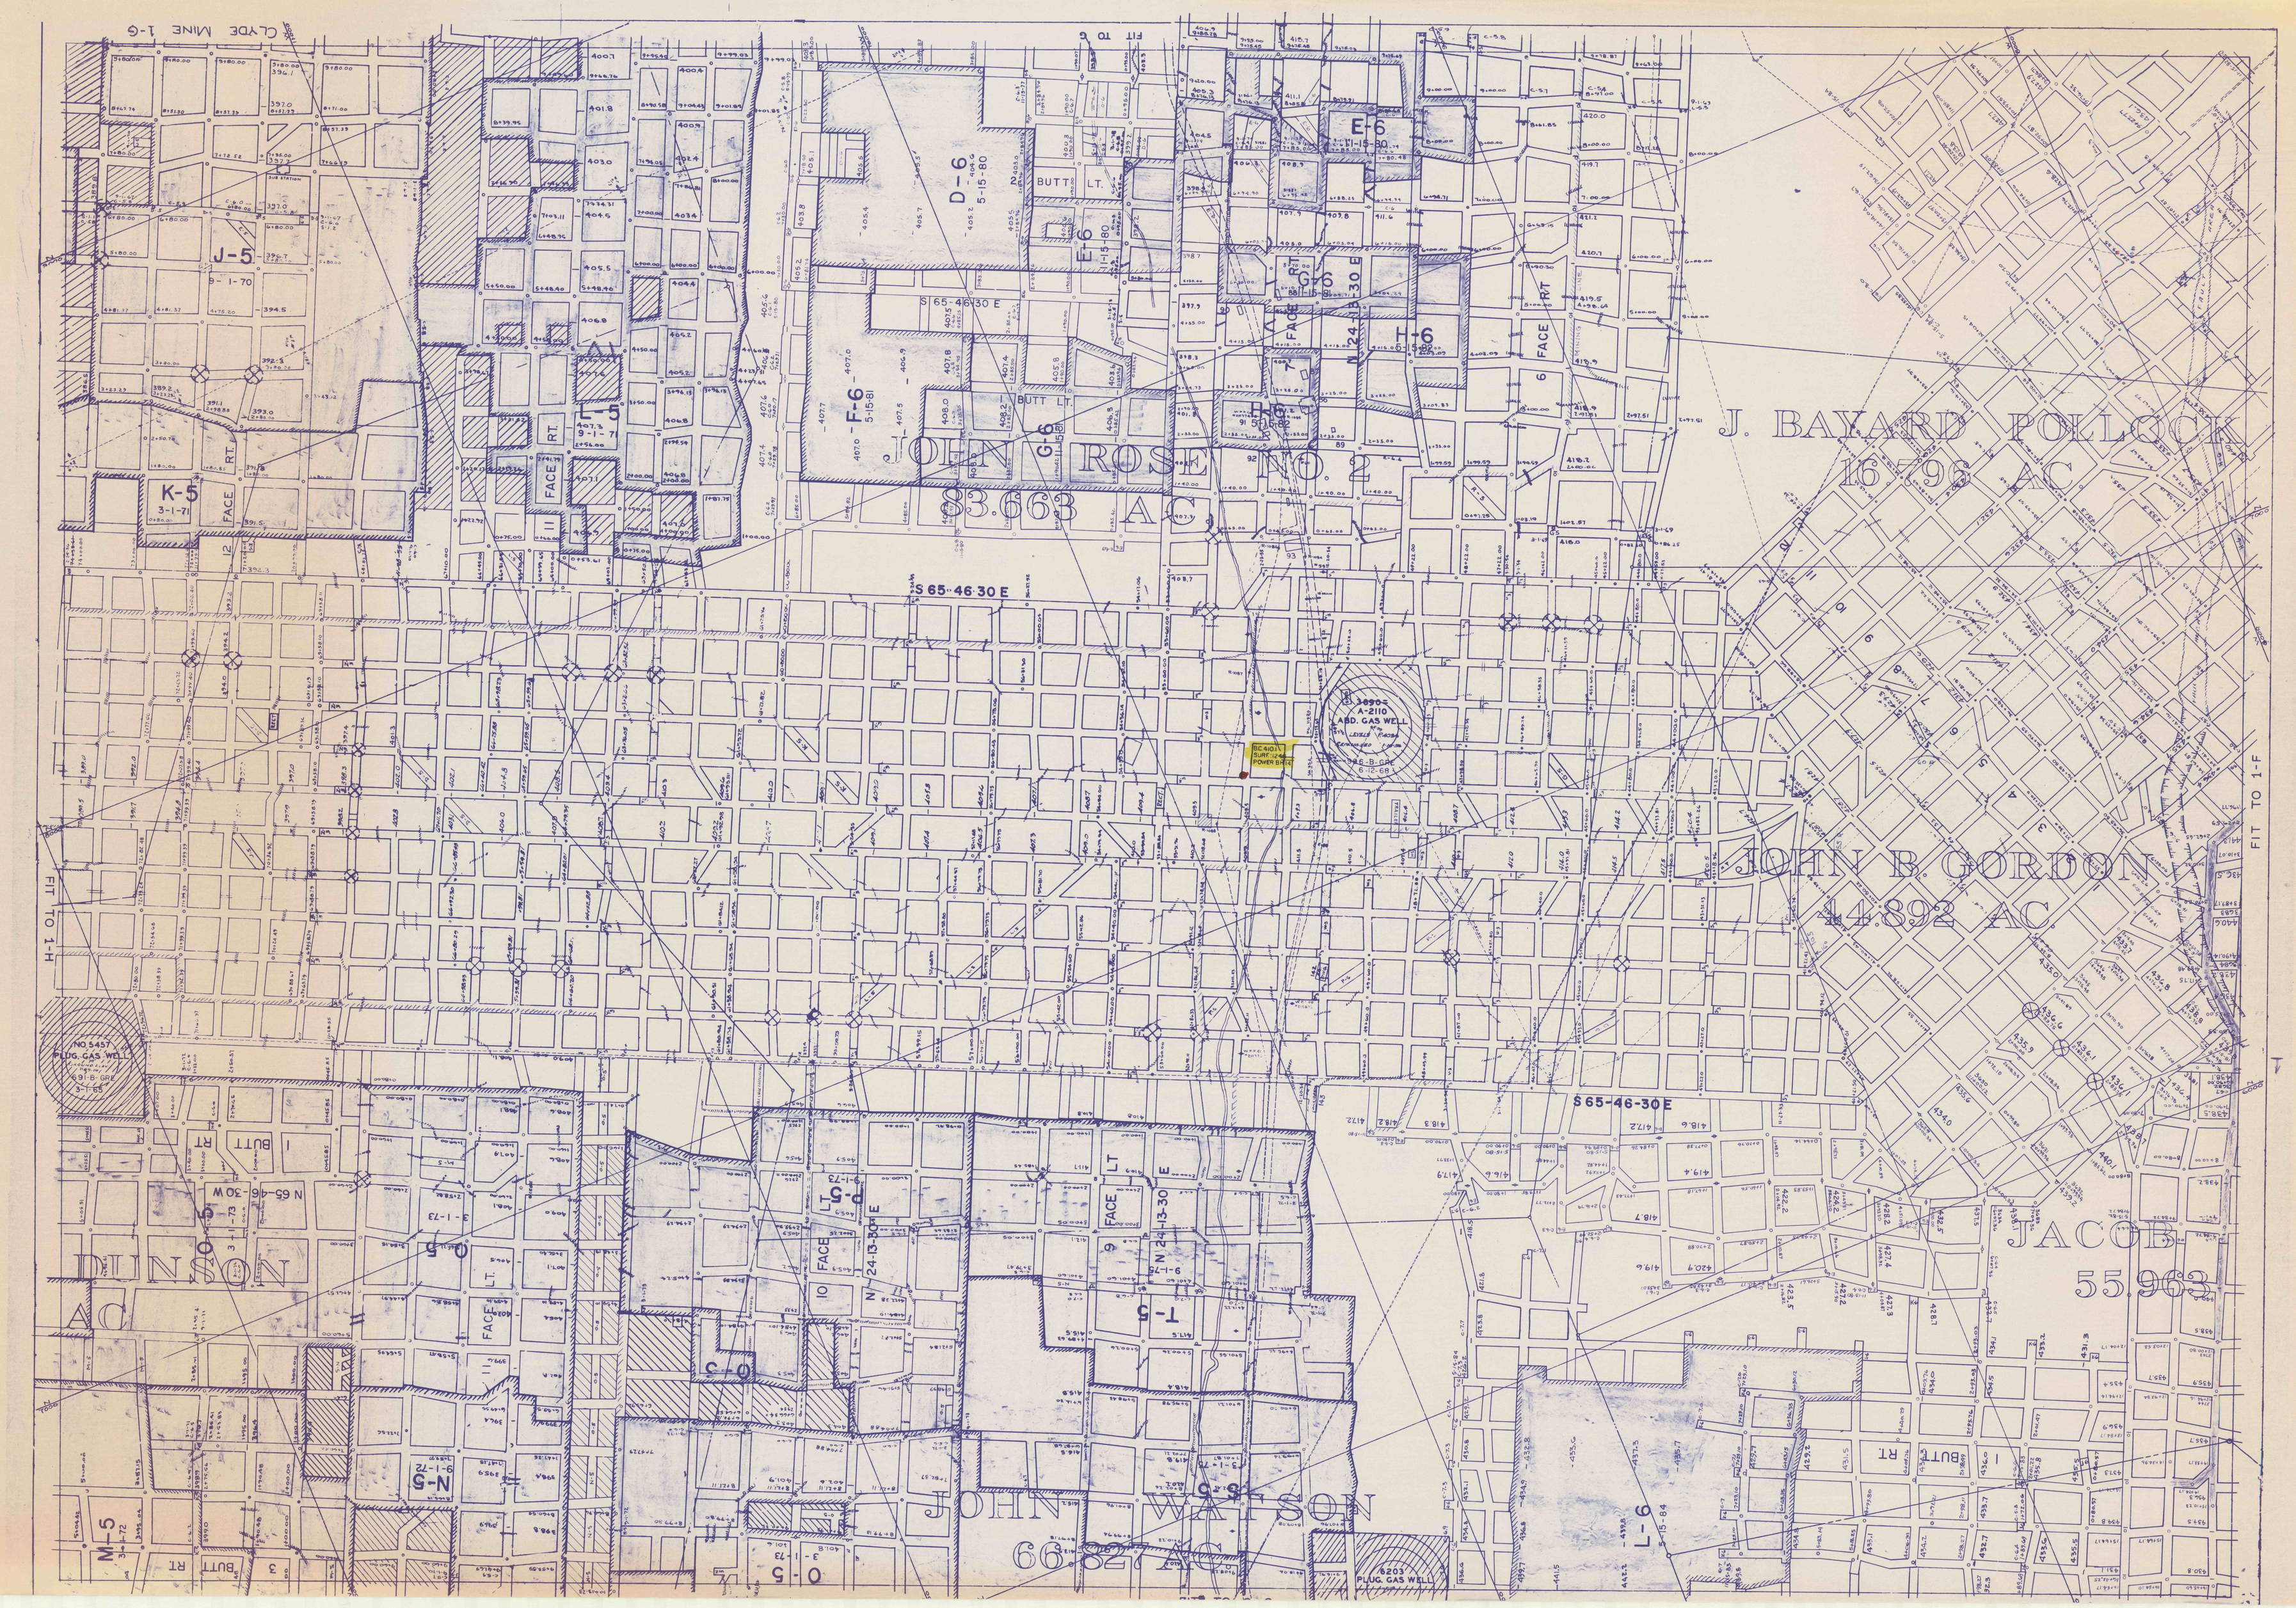

CLYDE MINE 1-G
FIT TO 1-H
FIT TO 1-F
J-5
9-1-70
K-5
3-1-71
L-5
9-1-71
D-6
5-15-80
E-6
11-15-80
F-6
5-15-81
G-6
H-6
5-15-82
JOHN ROSE NO. 2
83.663 AC
J. BAYARD POLLOCK
16.796 AC
JOHN B. GORDON
44.892 AC
JACOB
55.963
JOHN WATSON
66.827 AC
DUNSON
AC
S 65-46-30 E
N 24-13-30 E
N 65-46-30 W
BUTT LT.
BUTT RT
FACE RT.
FACE LT.
ABD. GAS WELL
PLUG. GAS WELL
M-5
N-5
O-5
P-5
T-5
L-6