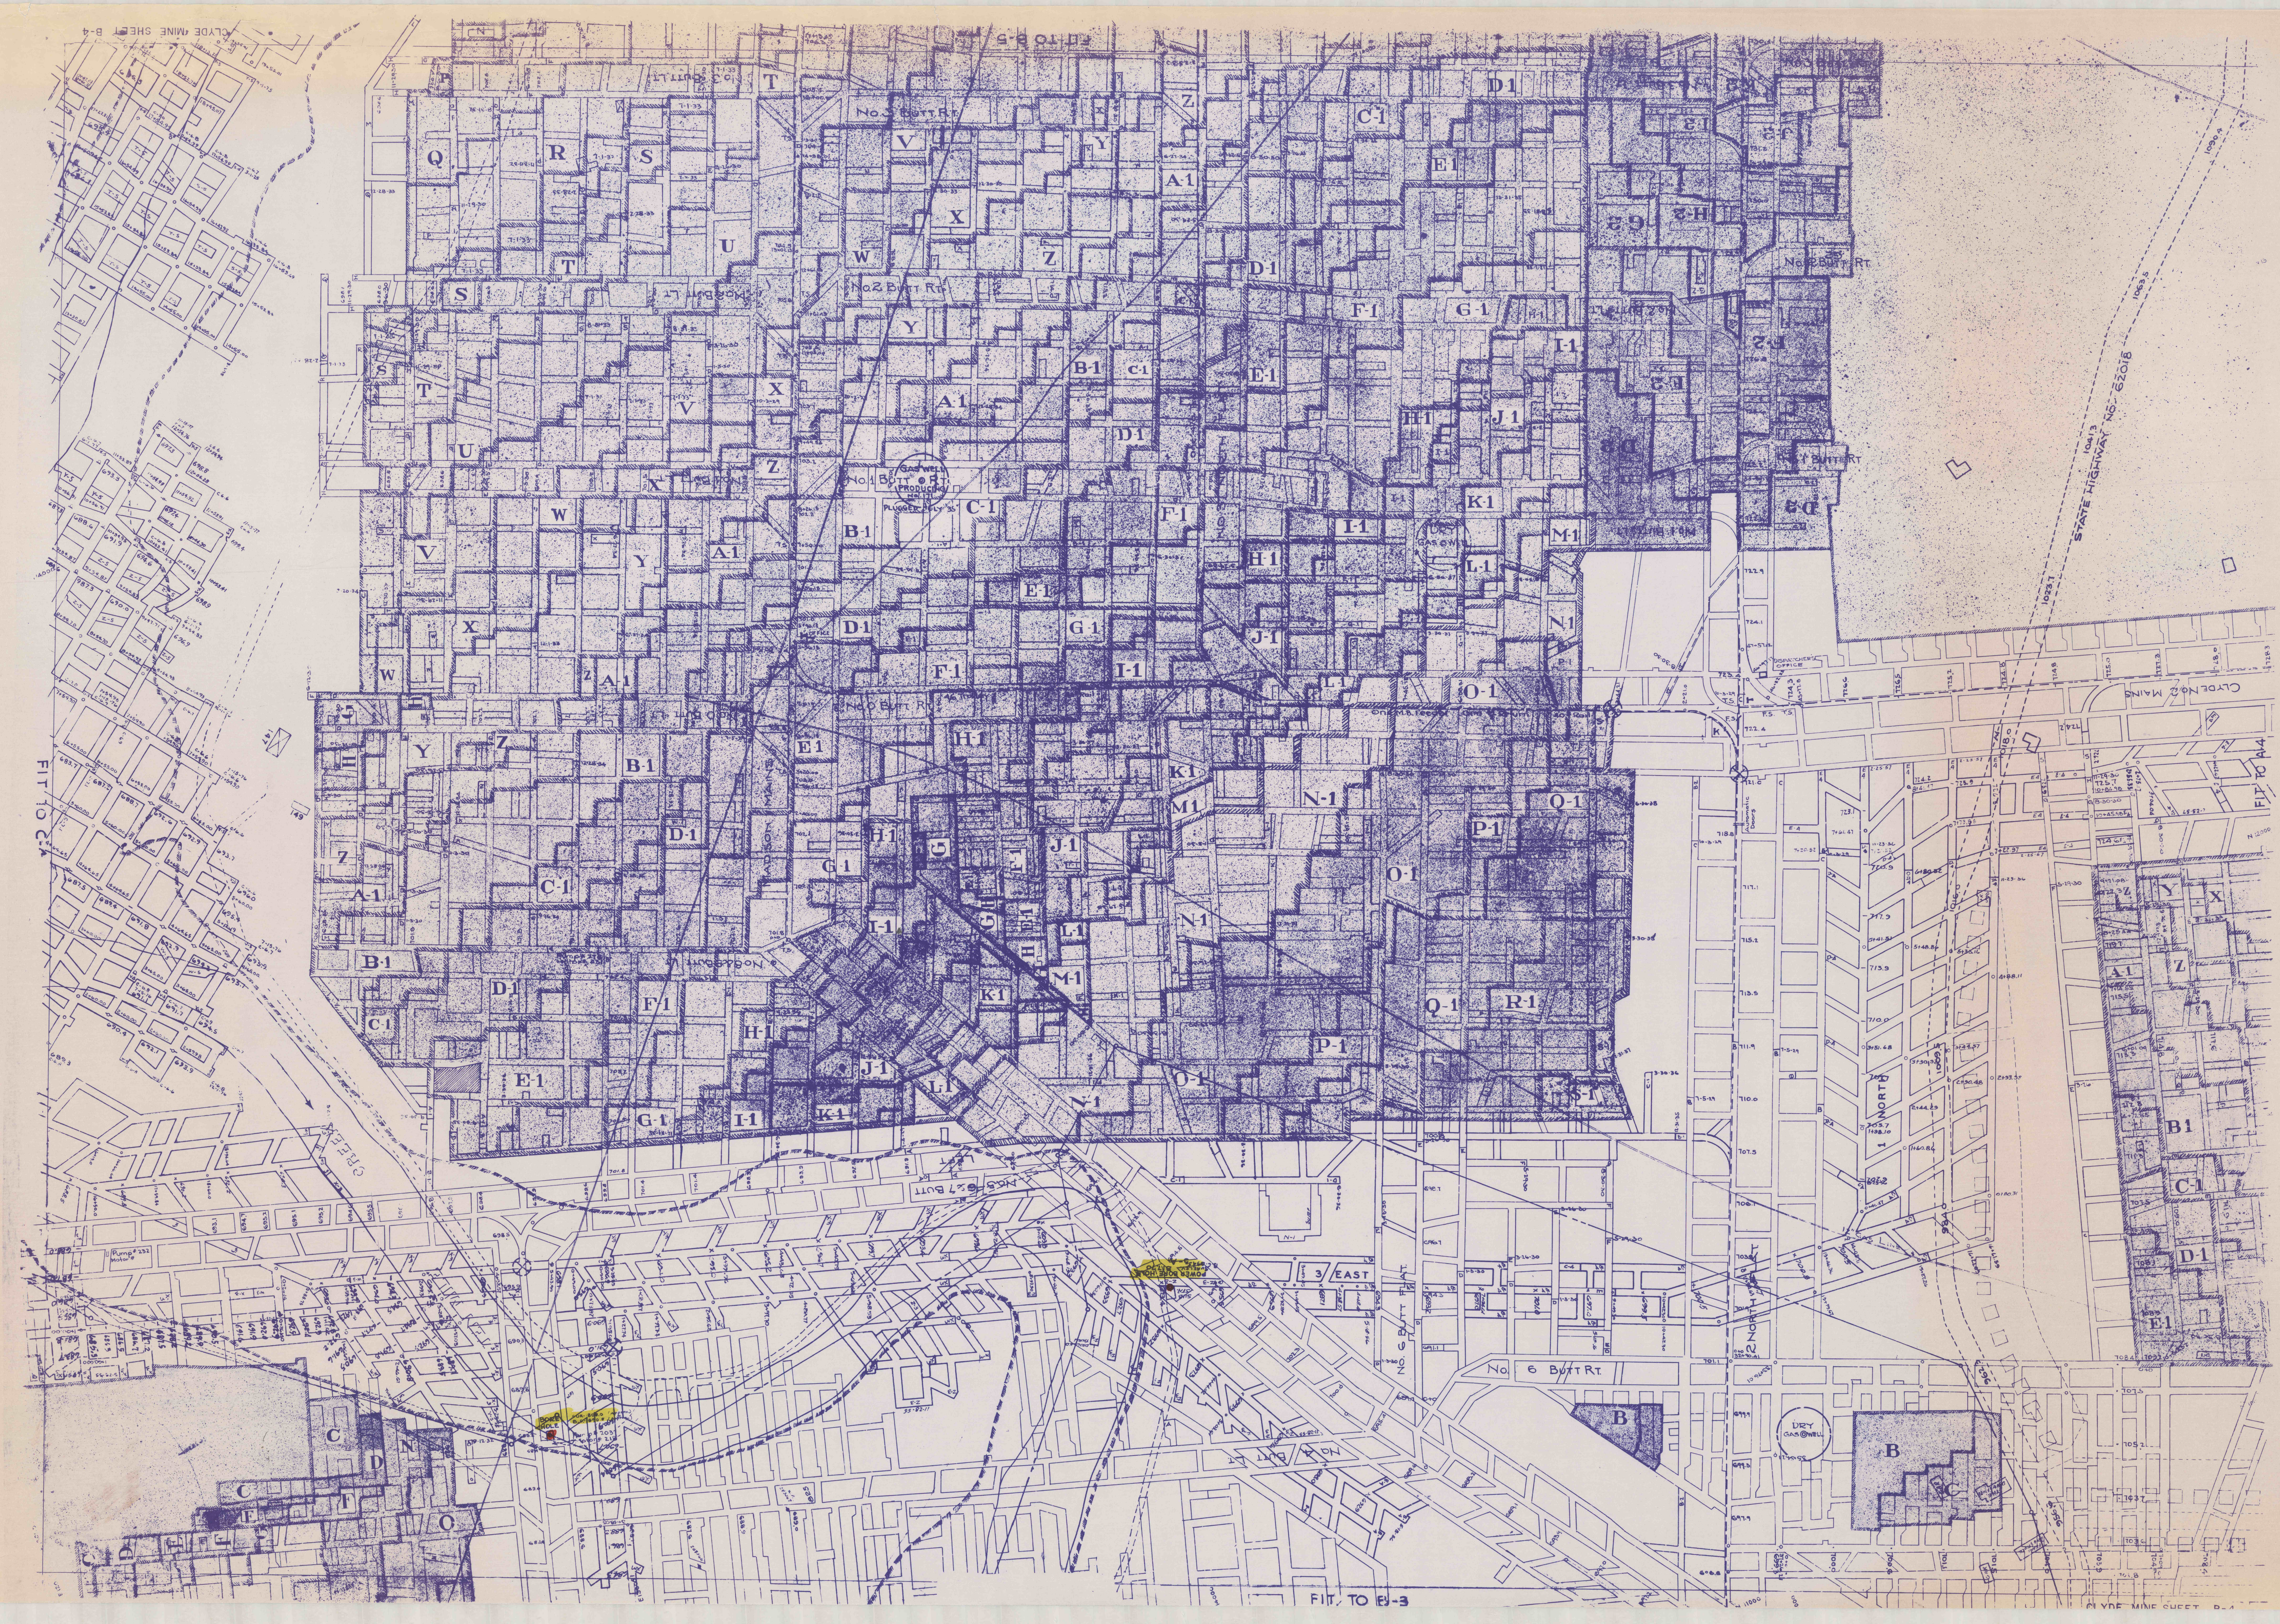
CLYDE MINE SHEET B-4
FIT TO B-5
FIT TO C-4
FIT TO A-4
FIT TO B-3
CLYDE MINE SHEET B-4
No. 3 BUTT RT.
No. 2 BUTT RT.
No. 1 BUTT RT.
No. 2 BUTT LT.
No. 3 BUTT LT.
No. 1 BUTT LT.
No. 0 BUTT RT.
No. 0 BUTT LT.
No. 1 BUTT RT.
No. 2 BUTT RT.
No. 1 BUTT LT.
GAS WELL PRODUCING No. 171 PLUGGED JULY '35
DRY GAS WELL
MADISON MAINS
DISPATCHER'S OFFICE
Automatic Doors
CLYDE No. 2 MAINS
STATE HIGHWAY No. 62018
CREEK
Pump # 232 Motor #
No. 5-6 & 7 BUTT LEFT
3 EAST
No. 6 BUTT FLAT.
No. 6 BUTT RT.
No. 4 BUTT LT
1 NORTH
2 NORTH LEFT
GAS LINE
BORE HOLE
POWER BORE HOLE
Q
R
S
T
U
V
W
X
Y
Z
A-1
B-1
C-1
D-1
E-1
F-1
G-1
H-1
I-1
J-1
K-1
L-1
M-1
N-1
O-1
P-1
Q-1
R-1
S-1
G
H
D-2
E-2
F-2
G-2
H-2
I-2
J-2
D-3
B
C
D
E
F
N
O
147
149